

PRICE PANCOAST COAL CO.

STEVENS
D.L. & W. FEE

PENNA. COAL CO.

JOS. HORSEFIELD

THE DELAWARE & HUDSON CO.

LUZERNE COAL CO.
D.L. & W. LESSEE

GENET

N.C. & I. CO.

WILLARD PARKER

J.W. GRIFFIN

D. & H. Coal Co. Penna. Coal Co. Exchange.
DOLPH & PORTER
PENNA. COAL CO.

LACKAWANNA VALLEY
COAL CO.
D.L. & W. FEE

GILBERT DUNNING

H.B. ROCKWELL

BOYMAN

SCRANTON COAL CO.

JOHN MILLS

LEVI DEPEW

CAYUGA & SUSQUEHANNA
TRACT
D.L. & W. FEE

H.B. ROCKWELL

JACOB BIESECKER

PENNA. COAL CO.

D. & H. CO. FEE
NOW SOUTH PENN.
COLLIERIES CO.

MISCELLANEOUS LOTS

MISCELLANEOUS LOTS

DANIEL SWARTZ

JACOB DEPEW

H.B. ROCKWELL

THE HUDSON CO. FEE

C.M.S.
SIMPSON
SPENCER COAL CO.

FERD. VON STORCH
WEST RIDGE COAL CO.
T.C. VON STORCH

SANDERSON

POTTER

ROBINSON
West Ridge Coal Co. Lessee.

EARL & GRIFFIN
Bulls Head Coal Co. Lessee

KELSEY

GILMORE - MEYLERT

WILLARD PARKER
Von Storch Collieries Co.
Lessee

D.L. & W. FEE
Bulls Head Brkr.

CHURCH

SANDERSON

D.L. & W. R.R.
FEE

NASSAU
D.L. & W. Fee

WINTON
D. L. & W. Fee

GILMORE - MEYLERT


GILMORE - MEYLERT

WALSH

BLAIR

SCRANTON
COAL CO.

GREEN RIDGE COAL CO.

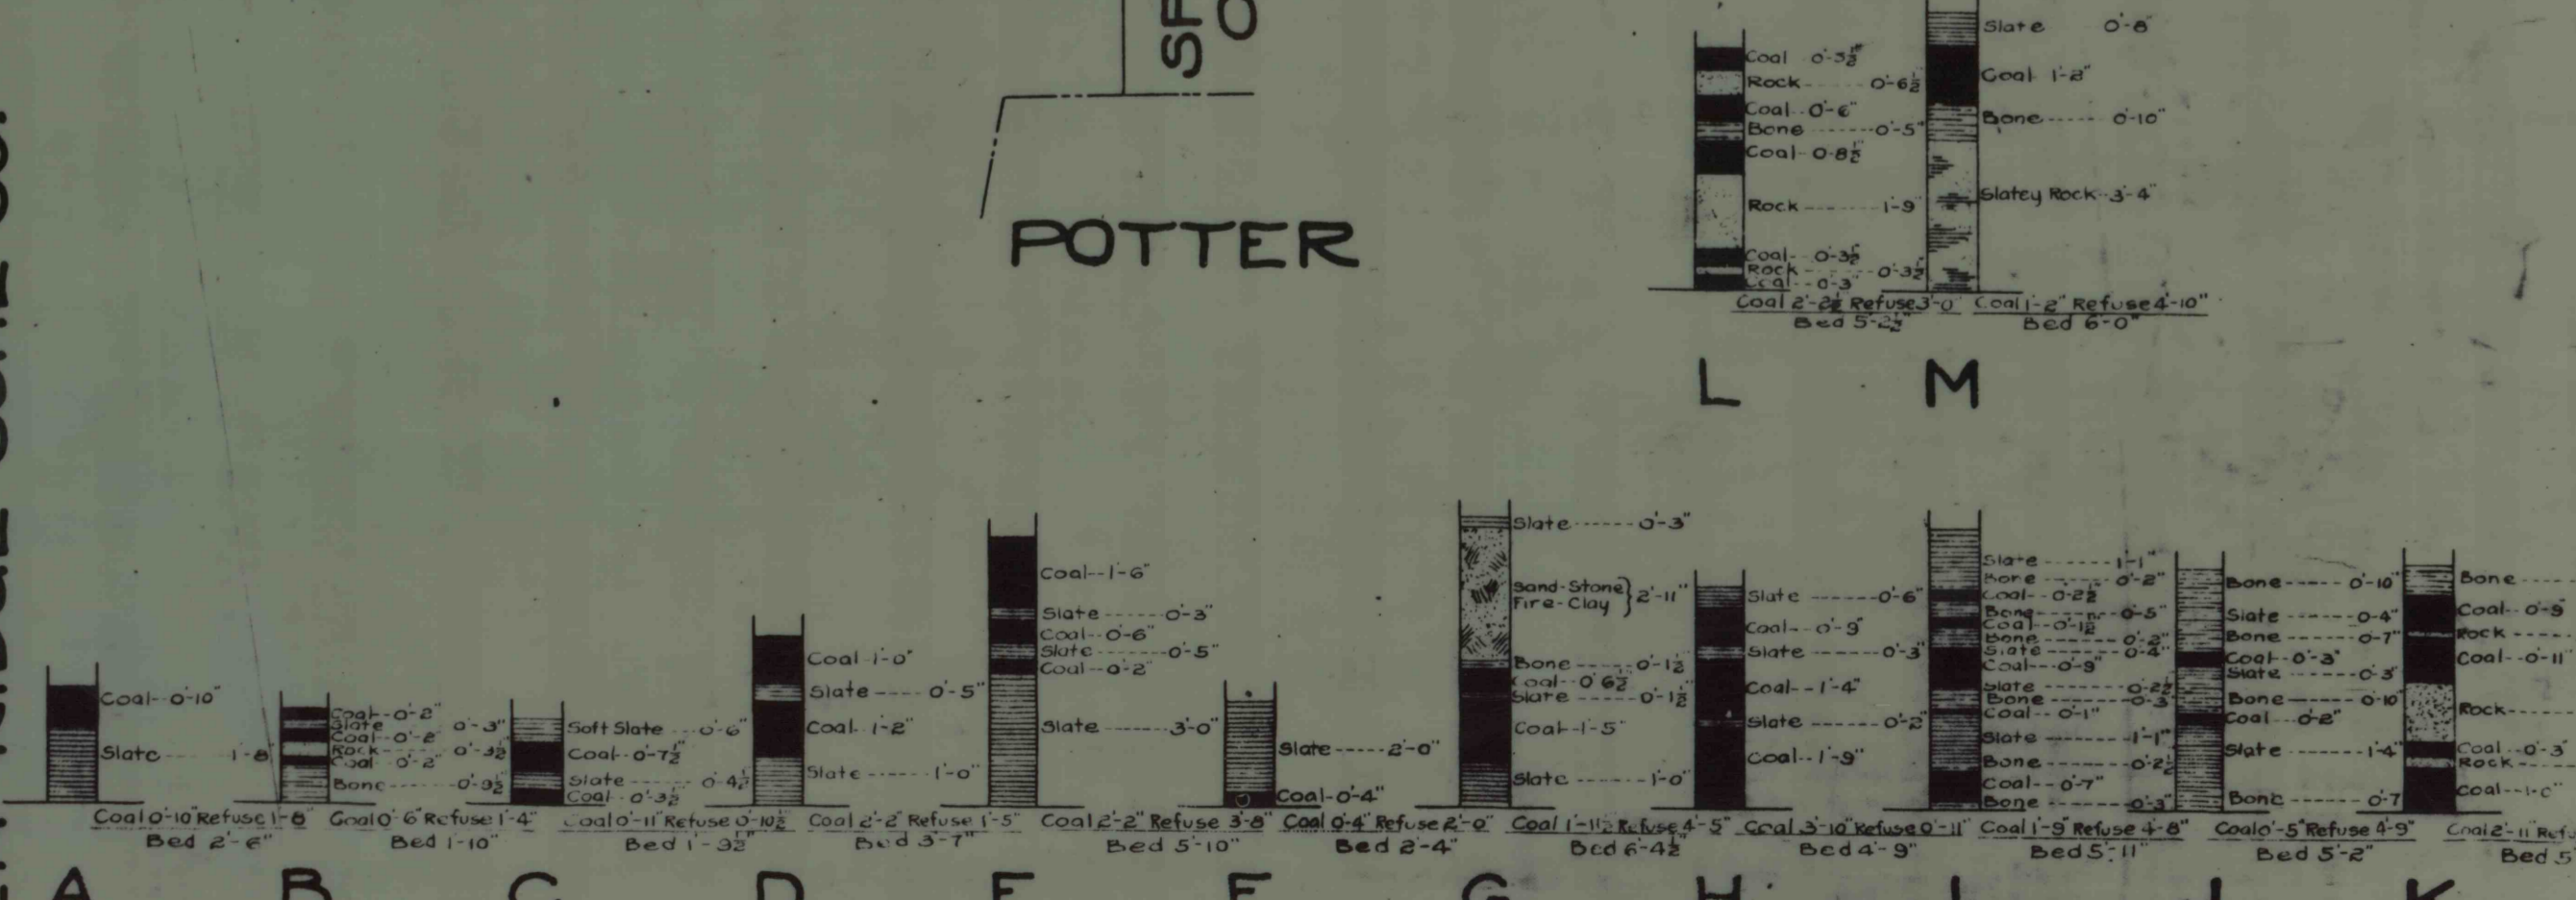

NOTE: Adjoining Workings are transferred from
Maps of various Coal Cos.

THE HUDSON COAL CO.
PROVIDENCE DIVISION
(MARVINE-DICKSON-MANVILLE COLLIERIES)
WORKINGS IN THE
NO. 1 DUNMORE BED.
Scale: 1" = 400'

Office of
Forecast Department
Scranton, Pa.

May, 1920.
posted To Jan. 1921