

STEVENS  
D.L.&W. FEE

PENNA. COAL CO.  
JOS. HORSEFIELD

LUZERNE COAL CO.  
D.L.&W. LESSEE

LACKAWANNA VALLEY  
D.L.&W. FEE

CAYUGA & SUSQUEHANNA  
TRACT  
D.L.&W. FEE

WILLARD PARKER

GENET

DELAWARE & HUDSON CO.

DOLPH & PORTER  
PENNA. COAL CO.

GILBERT DUNNING

3" BH #11

3" BH #128

3" BH #41

3" BH #535B

3" BH #562B

3" BH #70

3" BH #12

6" BH #150

6" BH #134

3" BH #14

H. B. ROCKWELL

BOWMAN

JOHN MILLS

LEVI DEPEW

PENNA. COAL CO.

JACOB BIESECKER

3" BH #549B

3" BH #501B

3" BH #472B

2" BH #224B

2" BH #223B

DANIEL SWARTZ

JACOB DEPEW

MISCELLANEOUS PLOTS

FERD VON STORCH

WEST RIDGE COAL CO.

T. C. VON STORCH

ROBINSON  
Bulls Head Coal Co. Lessee

EARL & GRIFFIN  
Bulls Head Coal Co. Lessee

D. & H. Co. Lessee BH #115  
D. & H. Co. To D.L. & W.R. in Exchange

KELSEY BH #173  
D. & H. Co. To D.L. & W.R. in Exchange

CHURCH  
BH #187

GRIFFIN

WINTON

BLAIR

WILLARD PARKER  
Von Storch Collieries Co.  
Lessee

D.L. & W.R.R.  
FEE

D.L. & W. Fee

D.L. & W. Fee

D.L. & W. Fee

SANDERSON

GILMORE MEYBERT

SANDERSON

GILMORE MEYBERT

WALSH

WALSH

WALSH

WALSH


WALSH

SCRANTON COAL CO.

J. SIMPSON  
SPENCER COAL CO.

POTTER

GREEN RIDGE COAL CO.

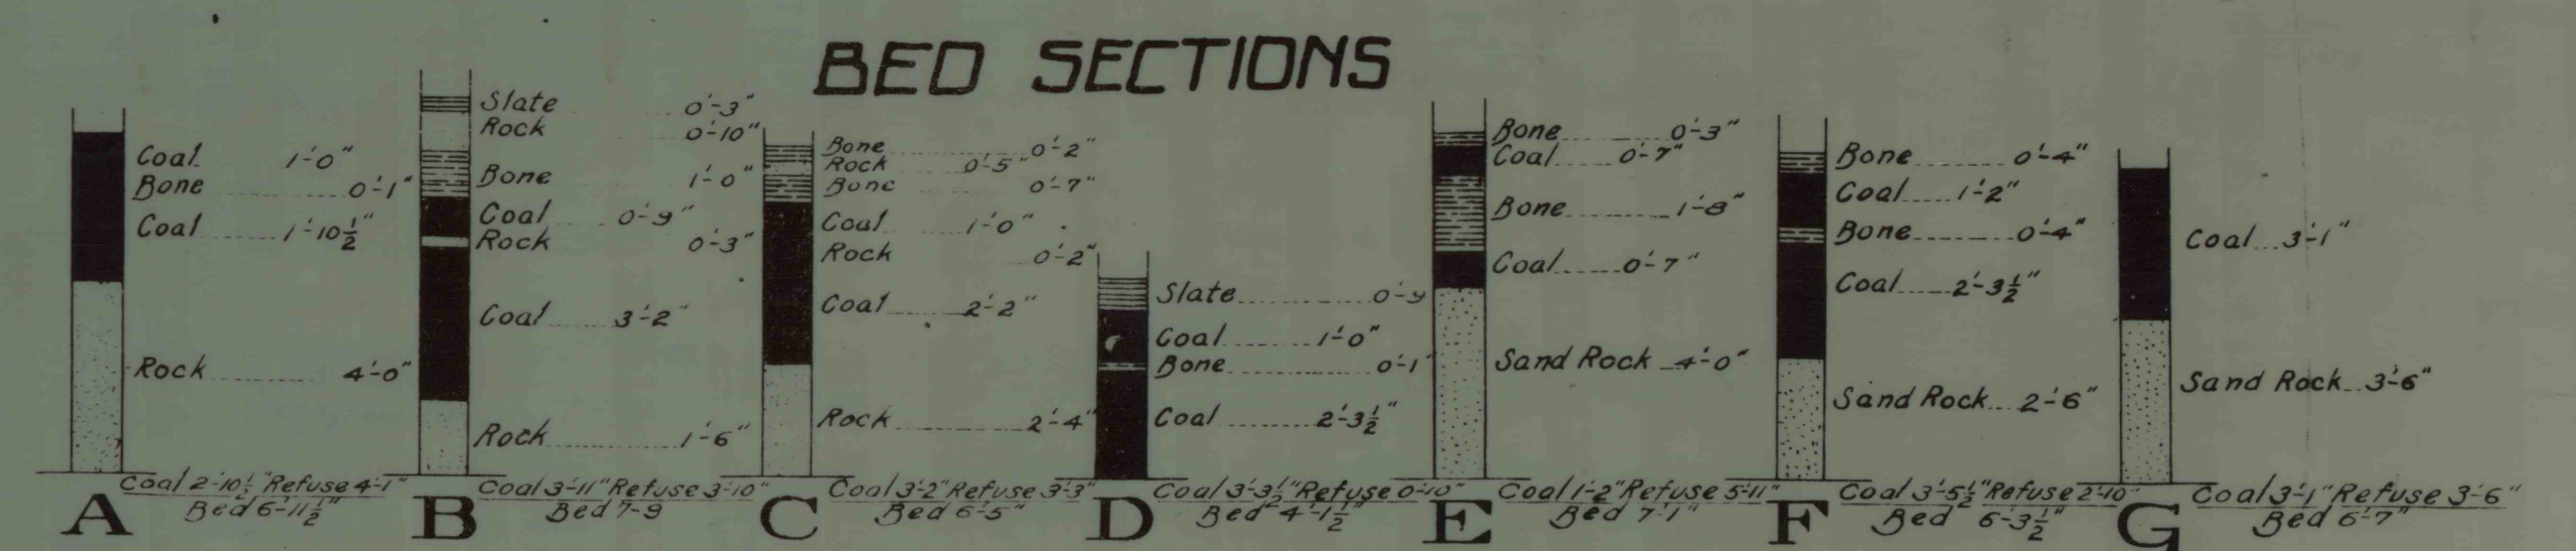

THE HUDSON COAL CO.  
PROVIDENCE DIVISION  
(MARINE-DICKSON-MANVILLE COLLIERIES)  
WORKINGS IN THE  
N#3 DUNMORE BED  
Scale: 1" = 400'

NOTE: Adjoining Working are transferred from  
Maps of various Coal Cos.

Office of  
Forecast Department  
Scranton, Pa.