

STEVENS
D.L. & W. FEE

Storrs No 3 shaft

LUZERNE COAL CO.
D.L. & W. LESSEE

LACKAWANNA VALLEY
D.L. & W. COAL CO.

3' BH # 11
3' BH # 12B
3' BH # 46
3' BH # 535B
3' BH # 138
BH # 136
3' BH # 70
3' BH # 12
6' BH # 150
6' BH # 134
Cayuga shaft

CAYUGA & SUSQUEHANNA
D.L. & W. FEE

THE DELAWARE & HUDSON Co.

D. & H. PORTER
PENNA. COAL CO.

BERT DUNNING

BOYMAN

PENNA. COAL CO.

LEVI DEPEY

JOHN MILLS

PENNA. COAL Co.

JACOB BIESECKER

JACOB DEPEY

DANIEL SWARTZ

2' BH # 224B
2' BH # 223B

FRED VON STORCH

WEST RIDGE COAL CO.

JC VON STORCH

ROBINSON
BULLS HEAD COAL CO. LESSEE

EARL & GRIFFIN
BULLS HEAD COAL CO. LESSEE

VON STORCH COLLIES CO.
- Park shaft

WILLARD PARKER
VON STORCH COLLIES CO.
Lessee

D.L. & W. R.R.
FEE

D.L. & W. FEE

NASSAU

WINTON

D.L. & W. FEE

CHURCH

GRIFFIN

SANDERSON


GILMORE MEYERT

SANDERSON

BLAIR

SCRANTON COAL CO.

BED SECTIONS

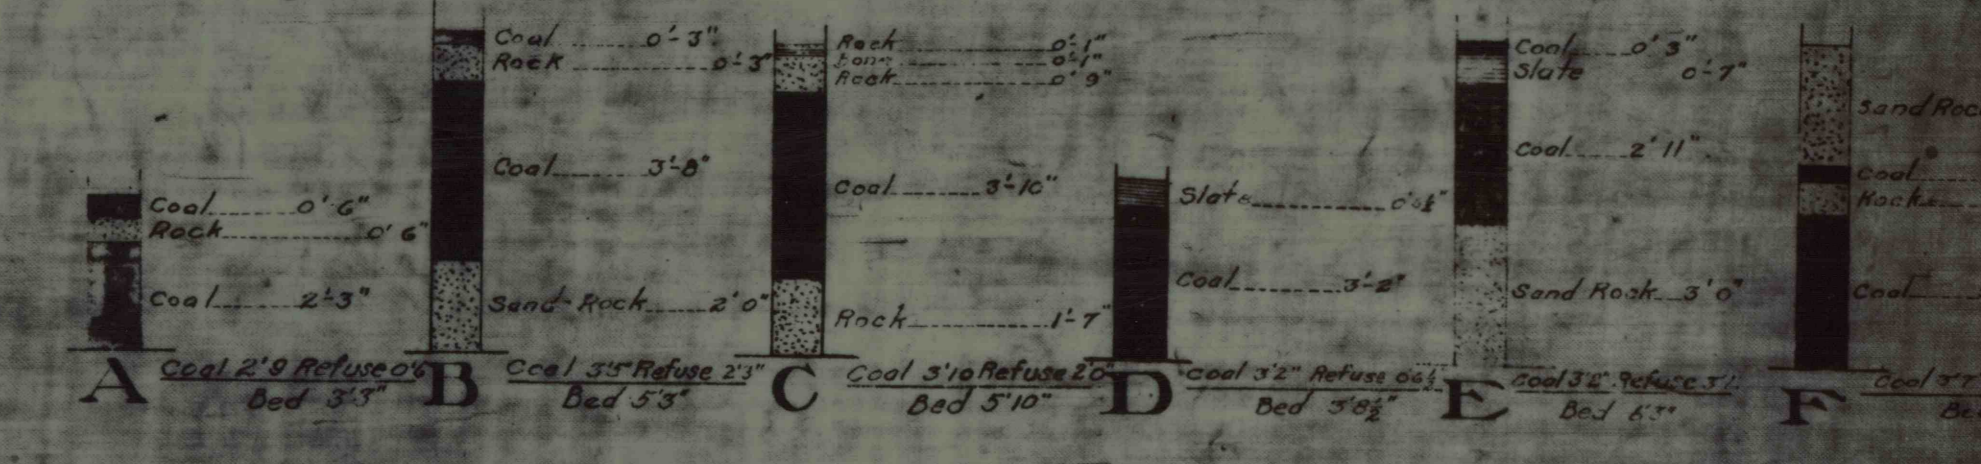

THE HUDSON COAL CO.

PROVIDENCE DIVISION

MARVIN-DIXON-MANVILLE-COLUMBIUS

WORKINGS IN THE

No 4 DUNMORE BED

Scale: 1" = 400'

Office of
Forest Department
Scranton, Pa.

NOTE - Adjoining Workings are transferred from
Maps of various Coal Cos.

May 1913