



5/6

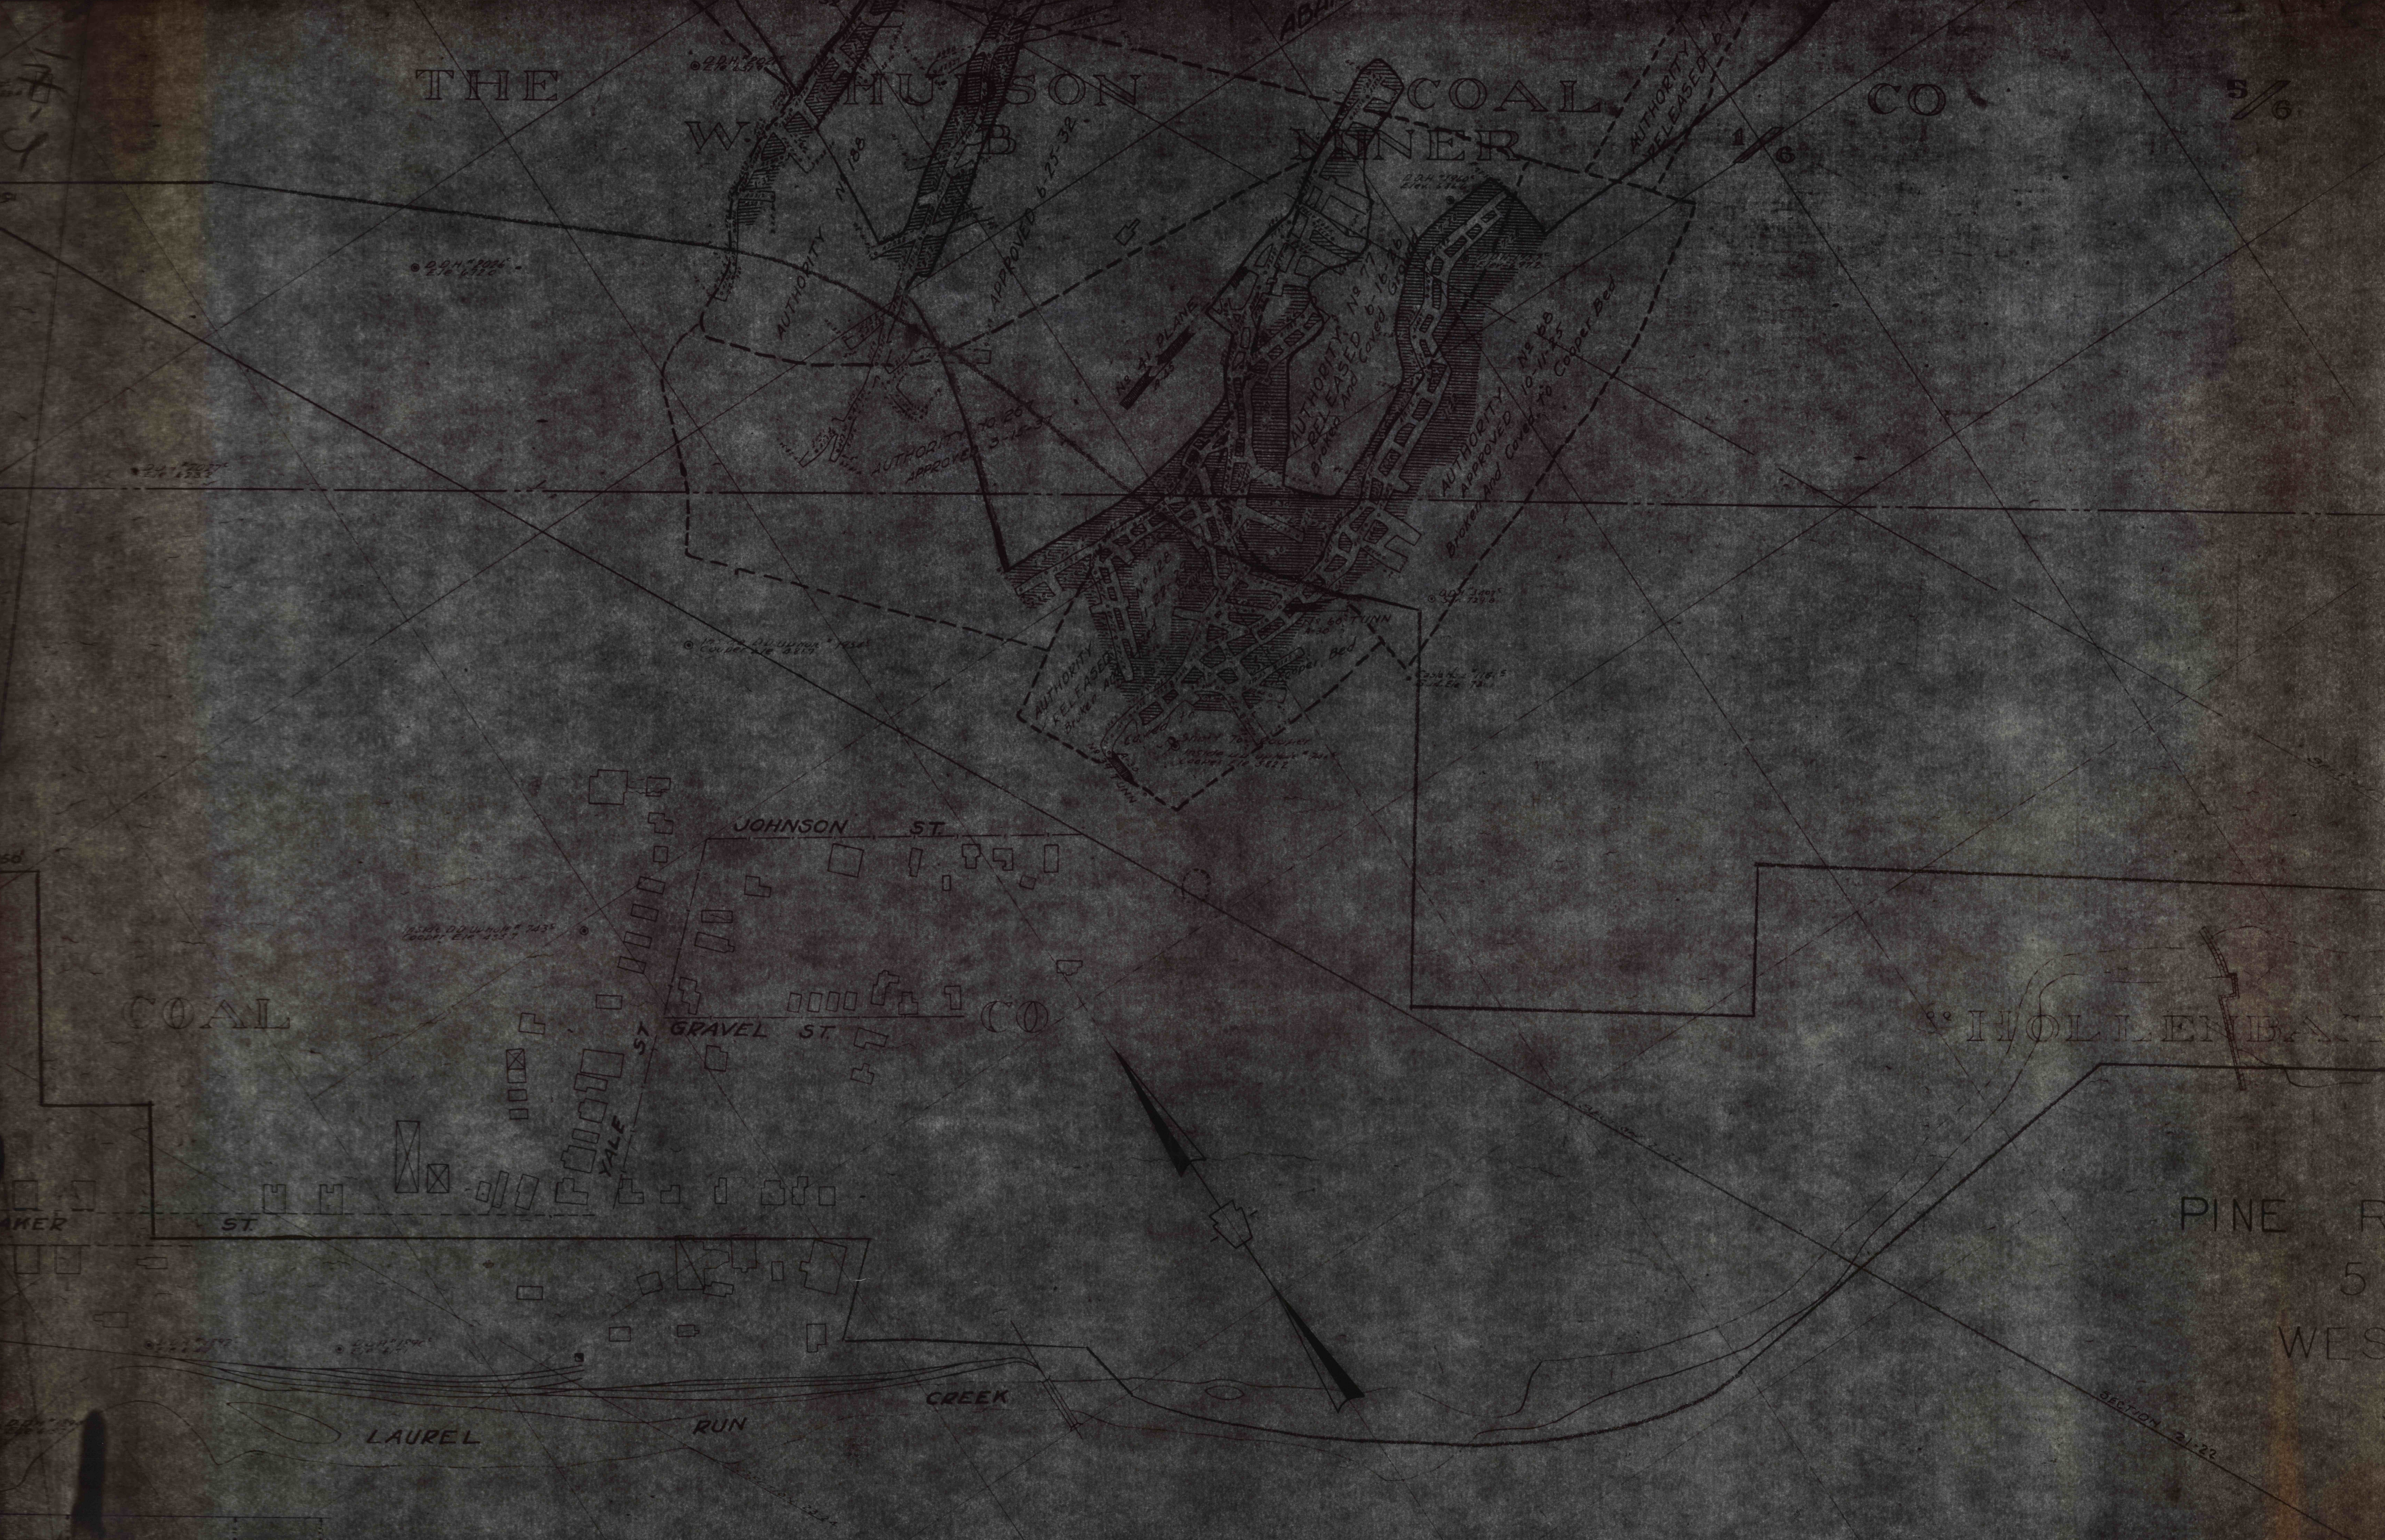

5 foot

SECTION 21-22

LAUREL RUN CREEK

HOLLENBACH

PINE RIVER

5

WEST

S