


# HUDSON COAL

## W. B. MINER

The Hudson Coal Co. owns 75% of coal and all interests in  
3 with Penna 1132-131 coal lease W. B. Miner et al. to  
Thos. H. Atherton 11-20-93

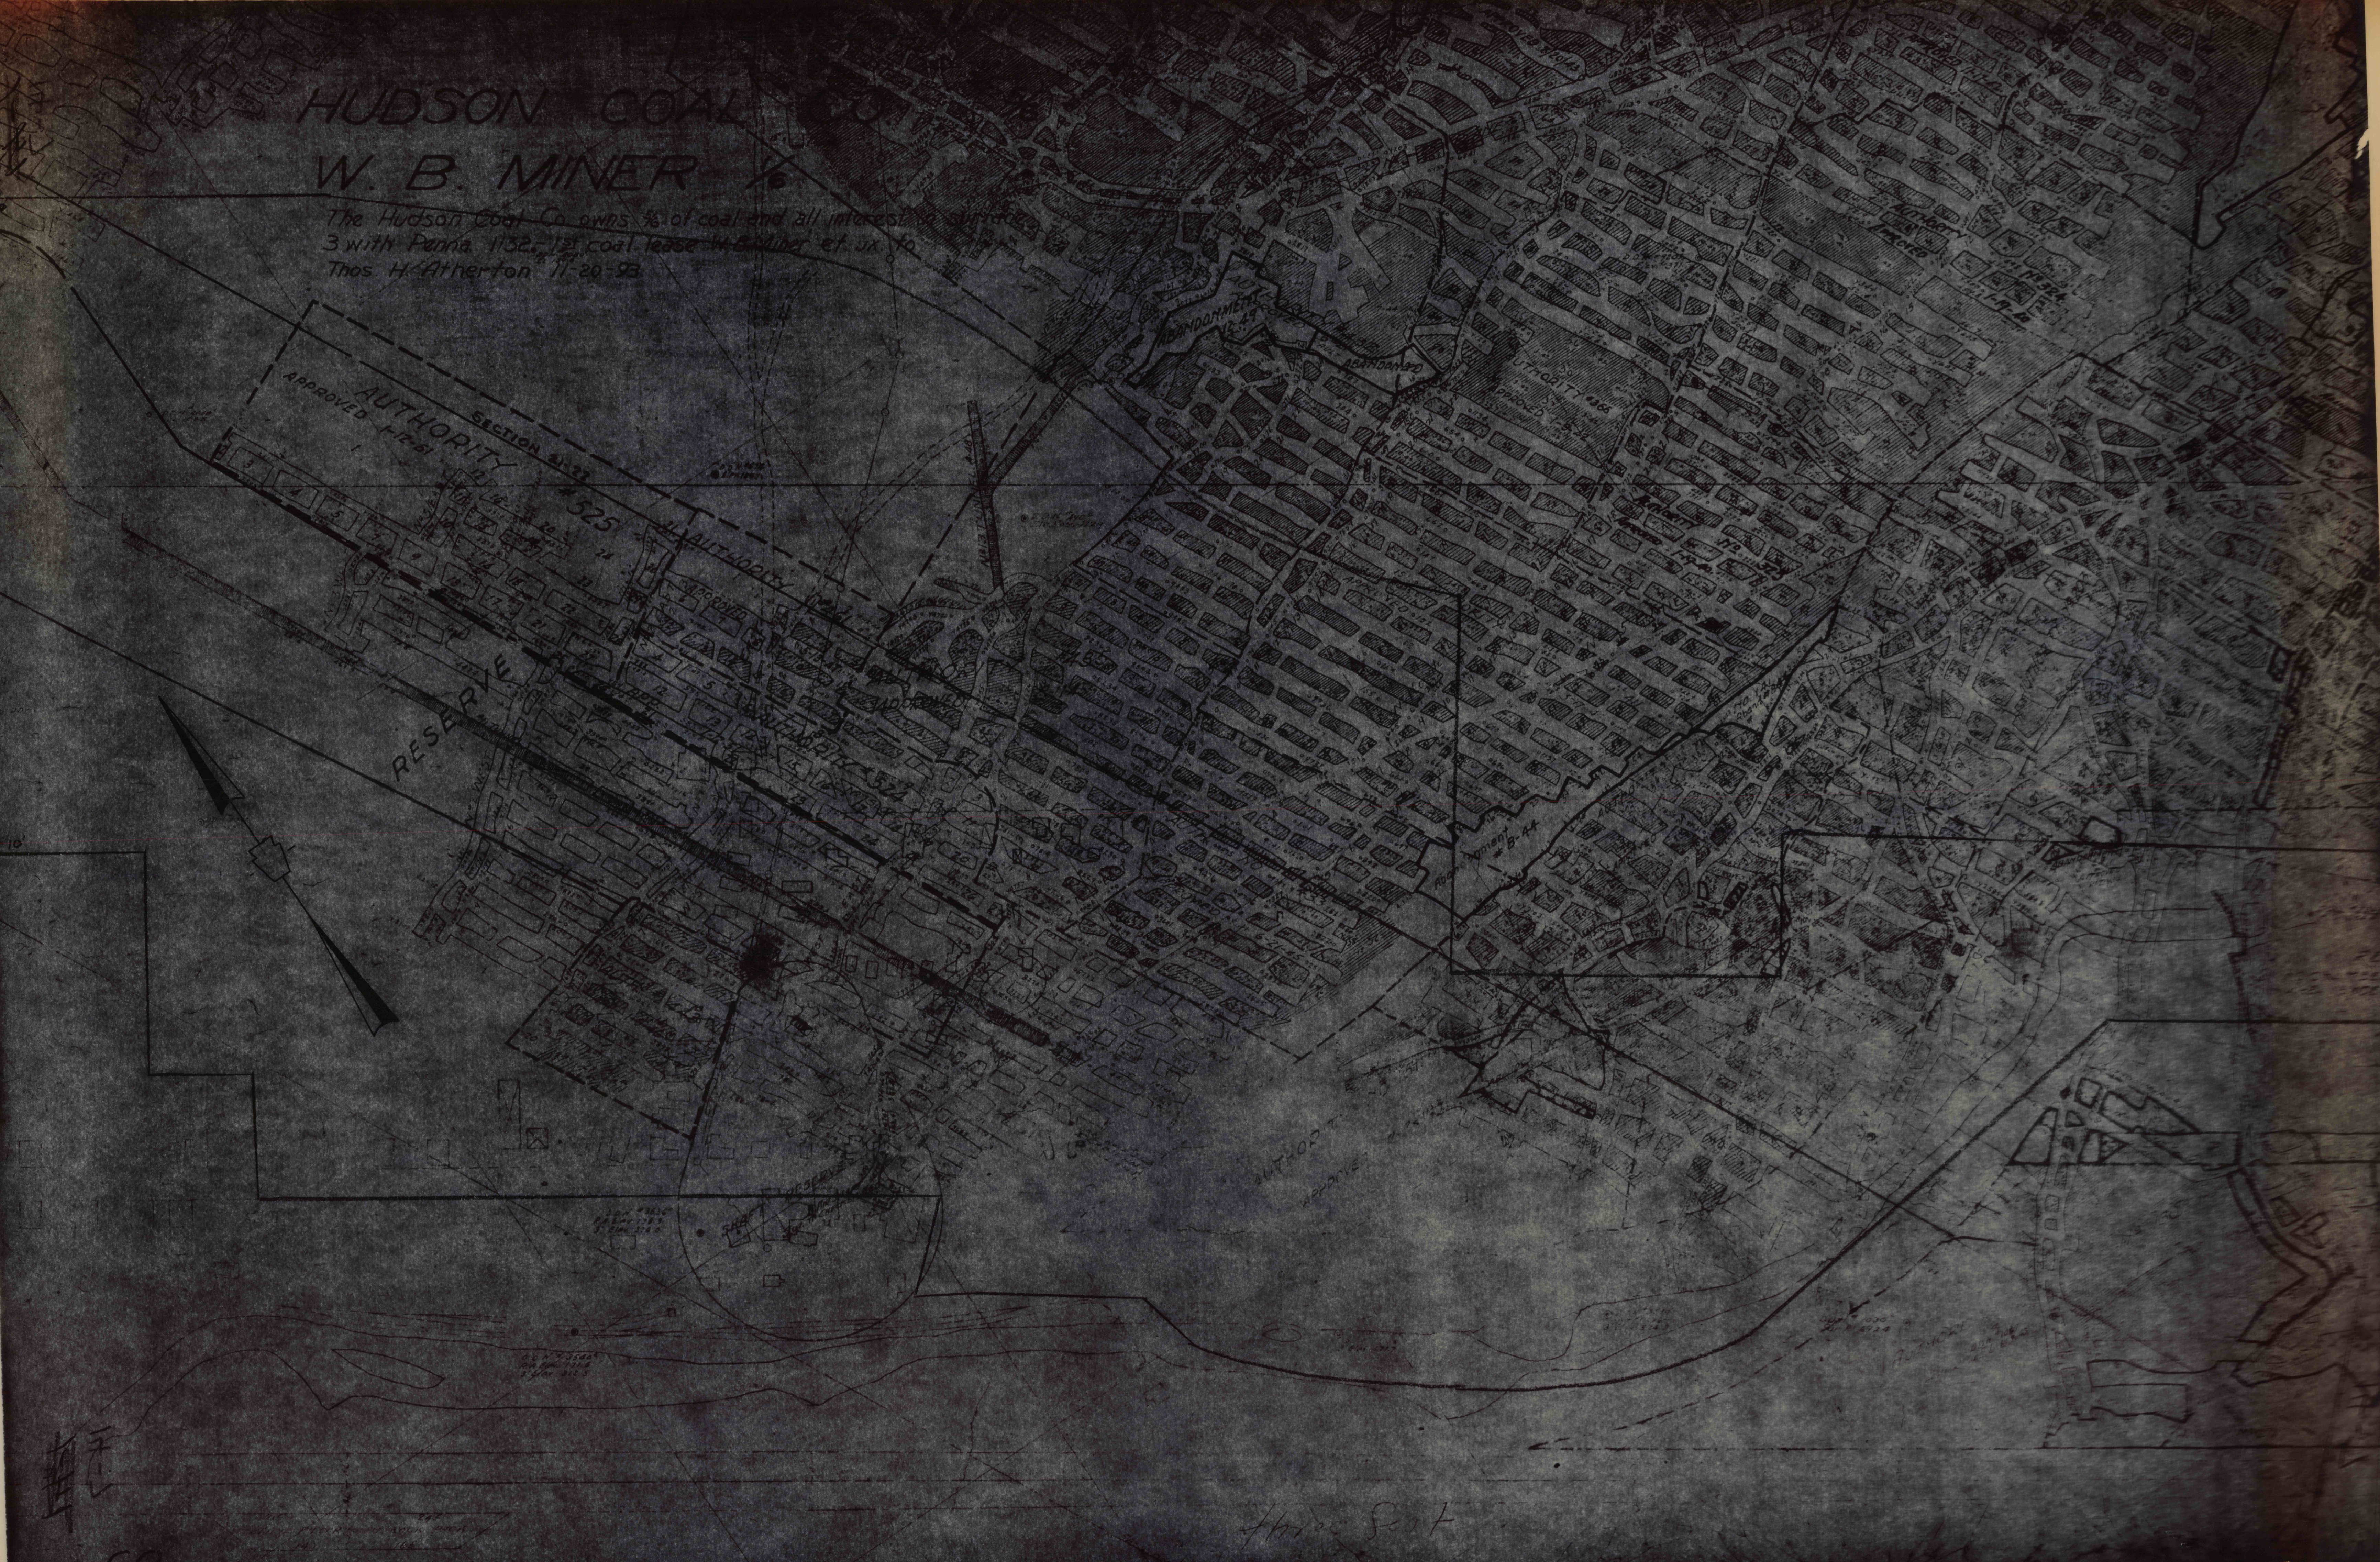

SECTION 21-23  
AUTHORITY  
APPROVED 11-20-93

RESERVE

525

AUTHORITY

524

AUTHORITY

APPROVED

Three feet