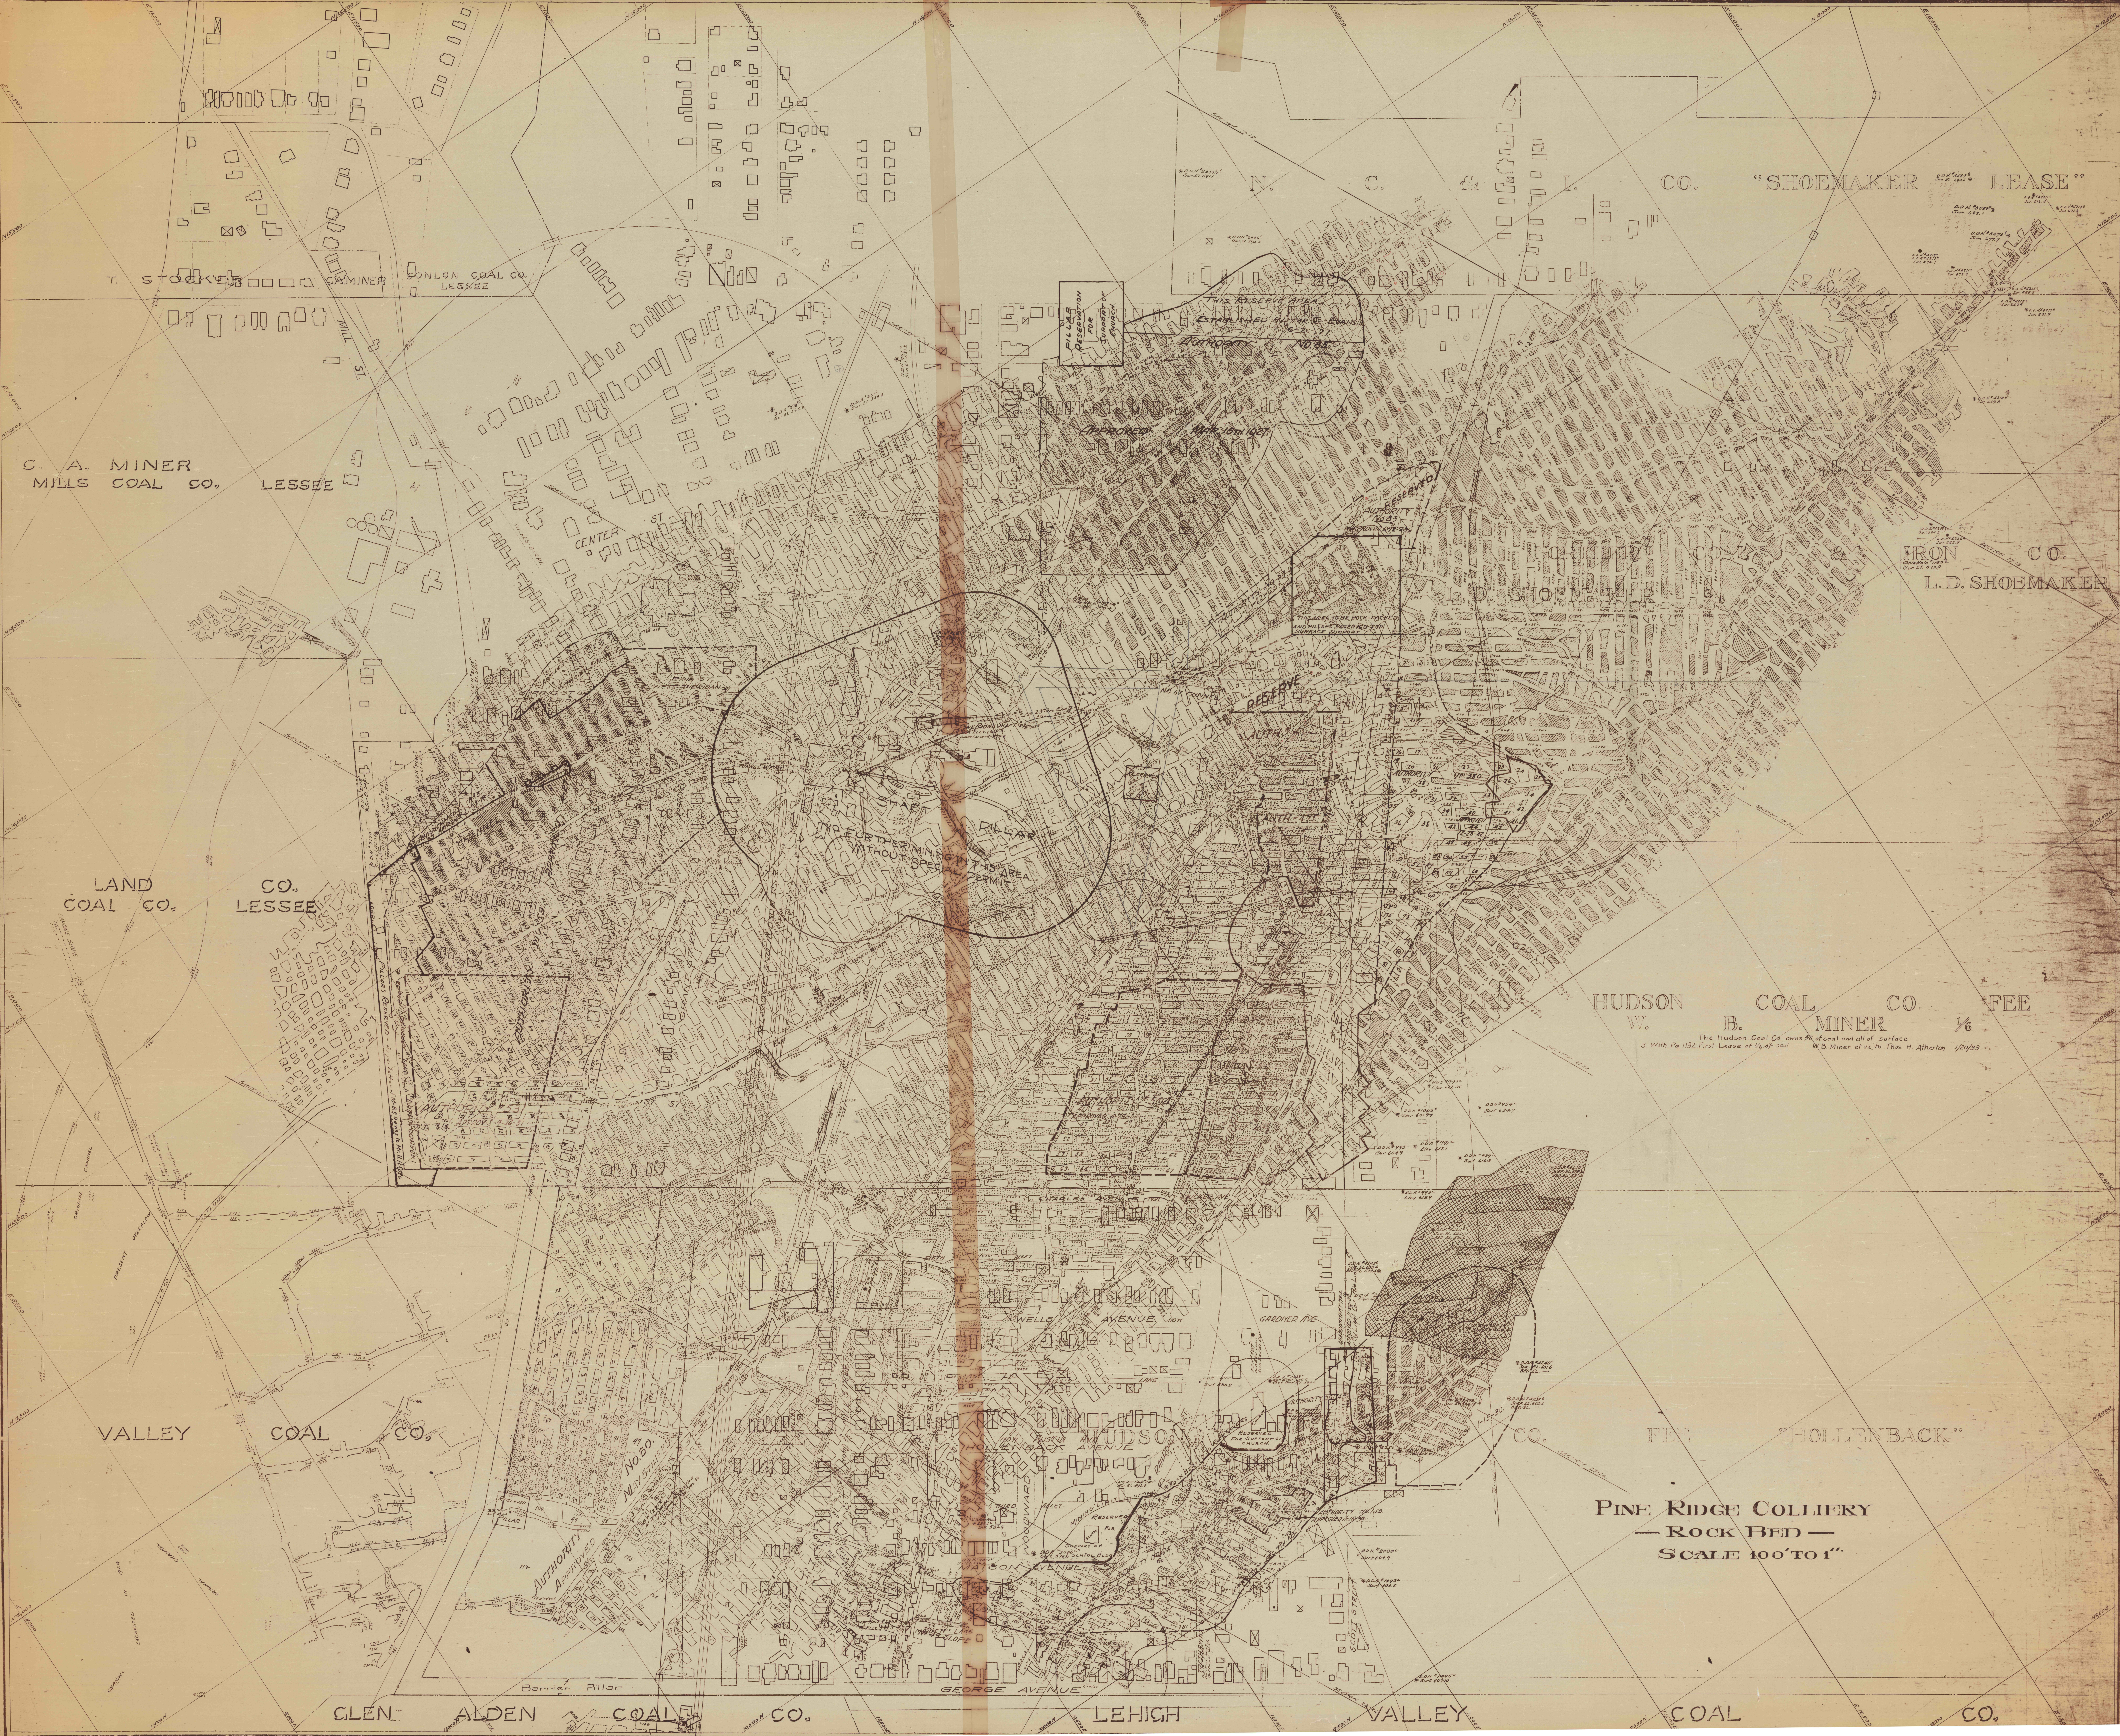

PINE RIDGE COLLIERY

— ROCK BED —

SCALE 100' TO 1"