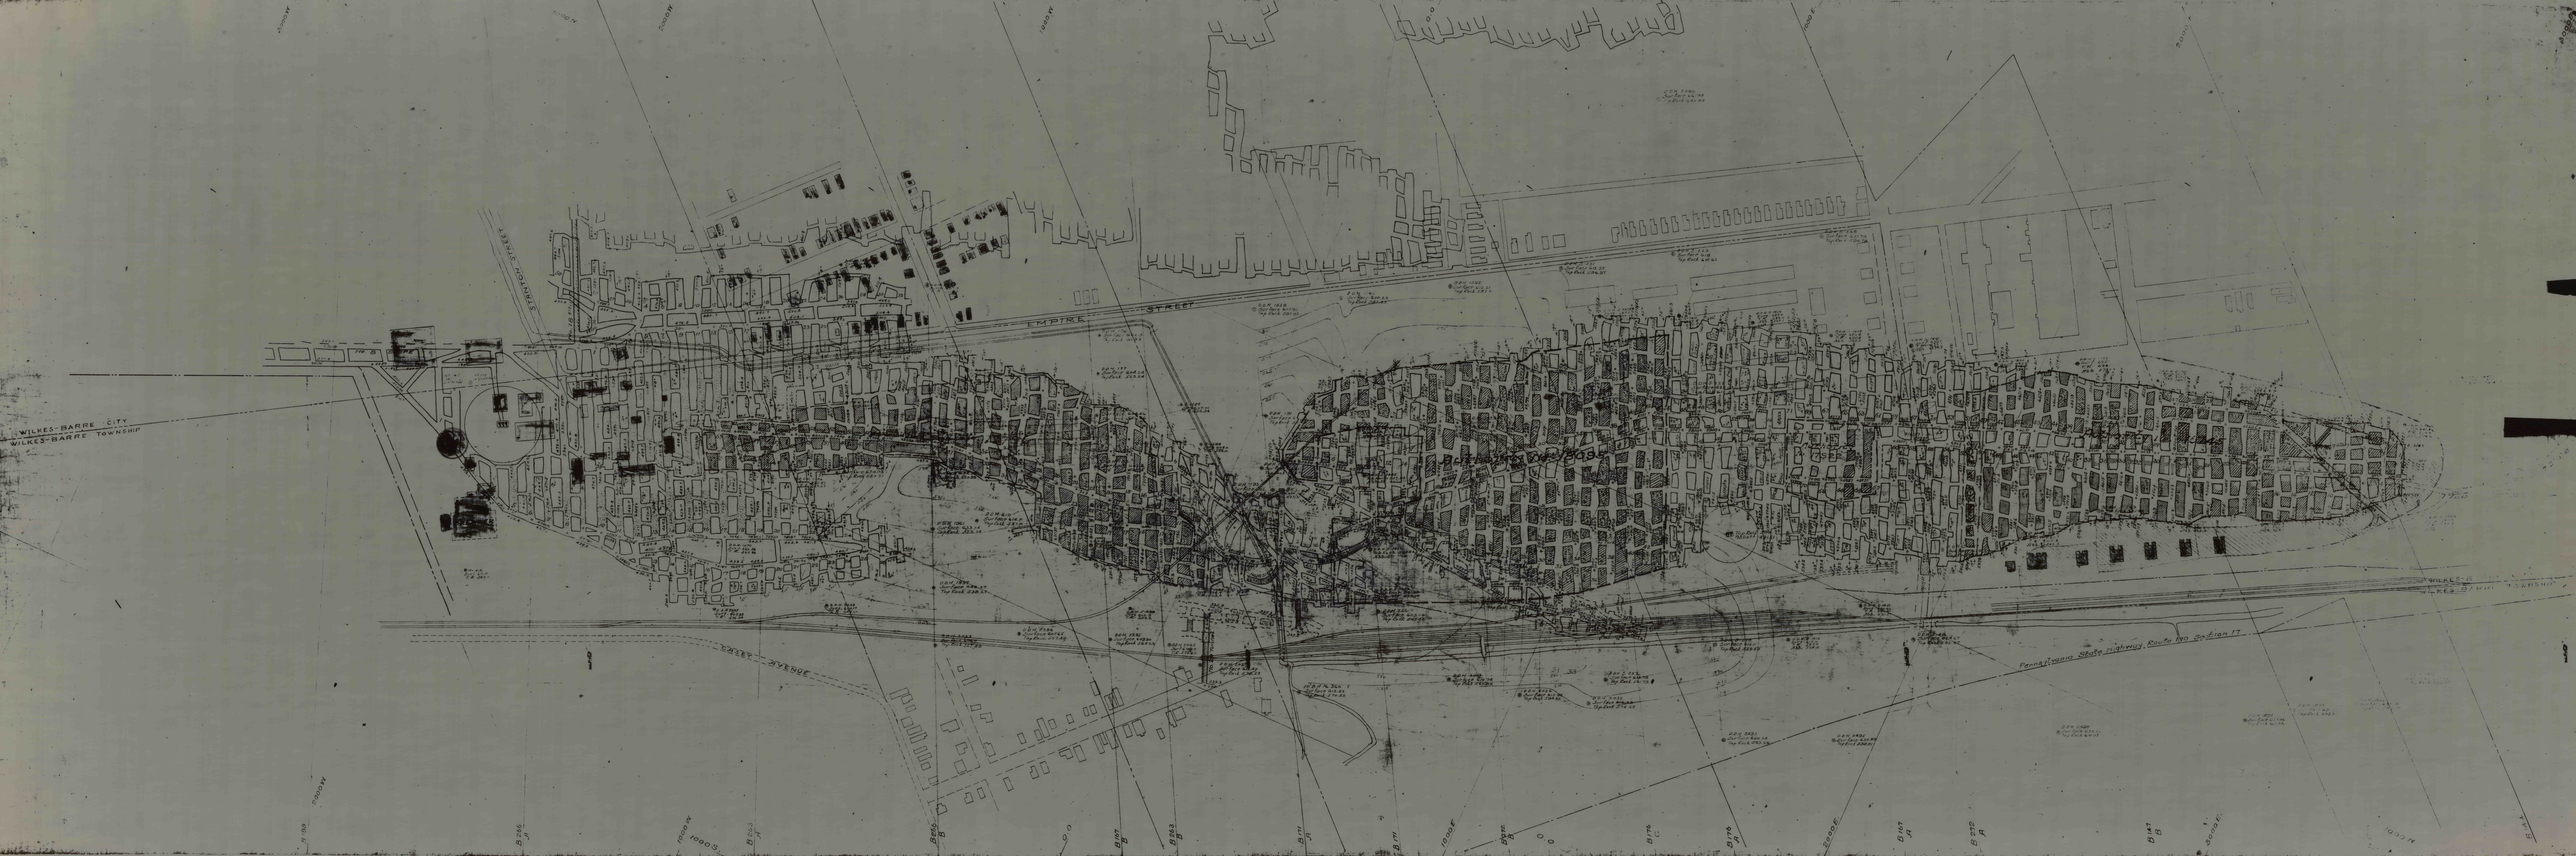
EMPIRE STREET
WILKES-BARRE CITY
WILKES-BARRE TOWNSHIP
Pennsylvania State Highway Route No. Section 17