


FT RESERVATION  
BALTIMORE No 2 SHAFT  
MINING  
AUTHORITY

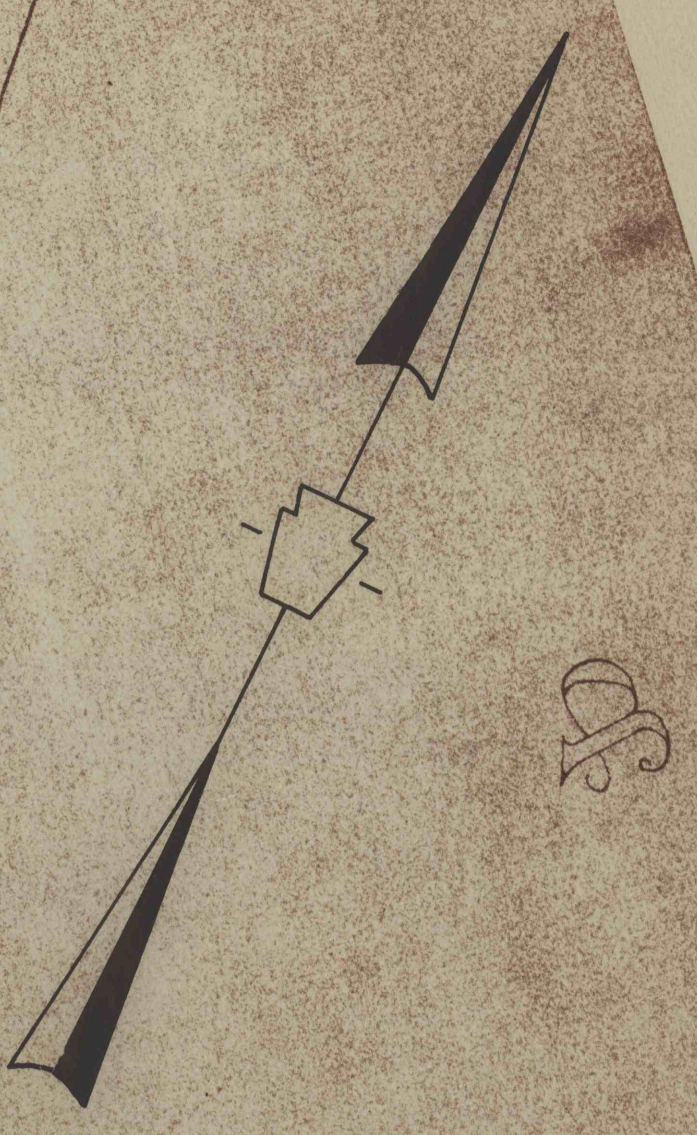

# H U D S O N

ABANDONMENT AREA #4-57  
Approved 4-15-57



BALT No 4 SHAFT

SKIPMORE

BALT No 4 SHAFT

BALT No 4 SHAFT