

Coal conveyed by  
Scranton Coal Co. to the  
School  
District  
of the City  
of Scranton  
Pa.  
Dec. 20, 1935


Quincy Ave.

+904.7

+891.0

+834.9

+870.4

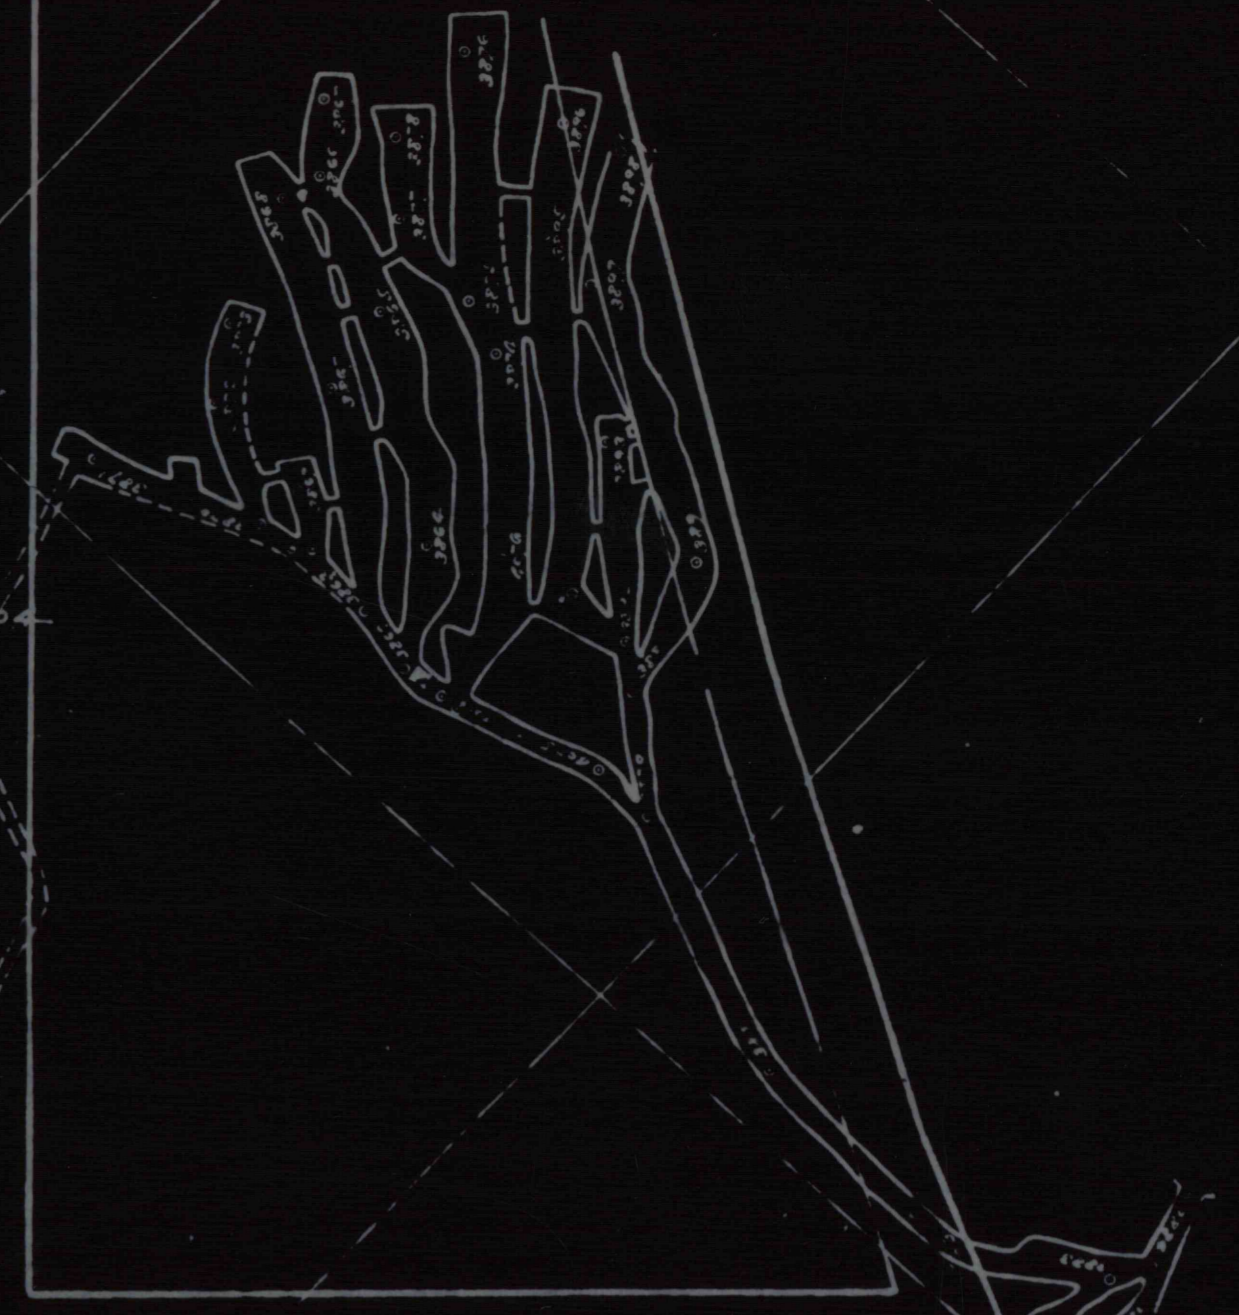

Monroe Ave.

Hitchcock Tract

St.

St.

St.

Ave.

+817.1

+799.5

Wesleyan Church  
Dec. 6, 1935

Madison Ave.

Coal conveyed  
by Scranton  
Coal Co. to the  
County of  
Lackawanna  
Dec. 31, 1935

Jefferson Ave.

Adams Ave.

Ave.

Coal conveyed by  
Scranton Coal Co.  
to the School District  
of the City of  
Scranton Pa.  
Dec. 20, 1935

Coal conveyed by L. I. & C. Co.  
to County of Lackawanna  
Aug. 20th 1879  
Reserves right to drive gang-ways  
to reach other coal.

