



Coal conveyed by
Scranton Coal Co to
the School District of
Scranton

Coal conveyed by
Scranton Coal Co
to the Westminster
Presbyterian Church
Dec 20 1935

Coal conveyed
by Scranton Coal
Co to the School
District of
Scranton Pa.
Dec 20 1935

Coal conveyed
by the
School District
of Scranton
Pa. Dec 20 1935

COURT HOUSE BLOCK
Coal Conveyed by L.I.C. Co
to County of Lackawanna
August 26th 1879 Reserved right
to drive ways to reach other
coal

Coal Conveyed by
L.I.C. Co to
County of Lackawanna
August 26th 1879


Coal conveyed by
Scranton Coal Co
to the First
National Bank
of Scranton Pa.
June 25 1934

Area outlined in Red conveyed by the
Scranton Coal Co to the City of Scranton, Pa.
Dec 20 1935
(Prior conveyances excepted)

Coal conveyed
by Scranton
Coal Co to the
School District
of Scranton Pa
Dec 20 1935

Rock Facking Posted

No 1 DUNMORE VEIN
LITTLE POCONO-RIVER SECTION

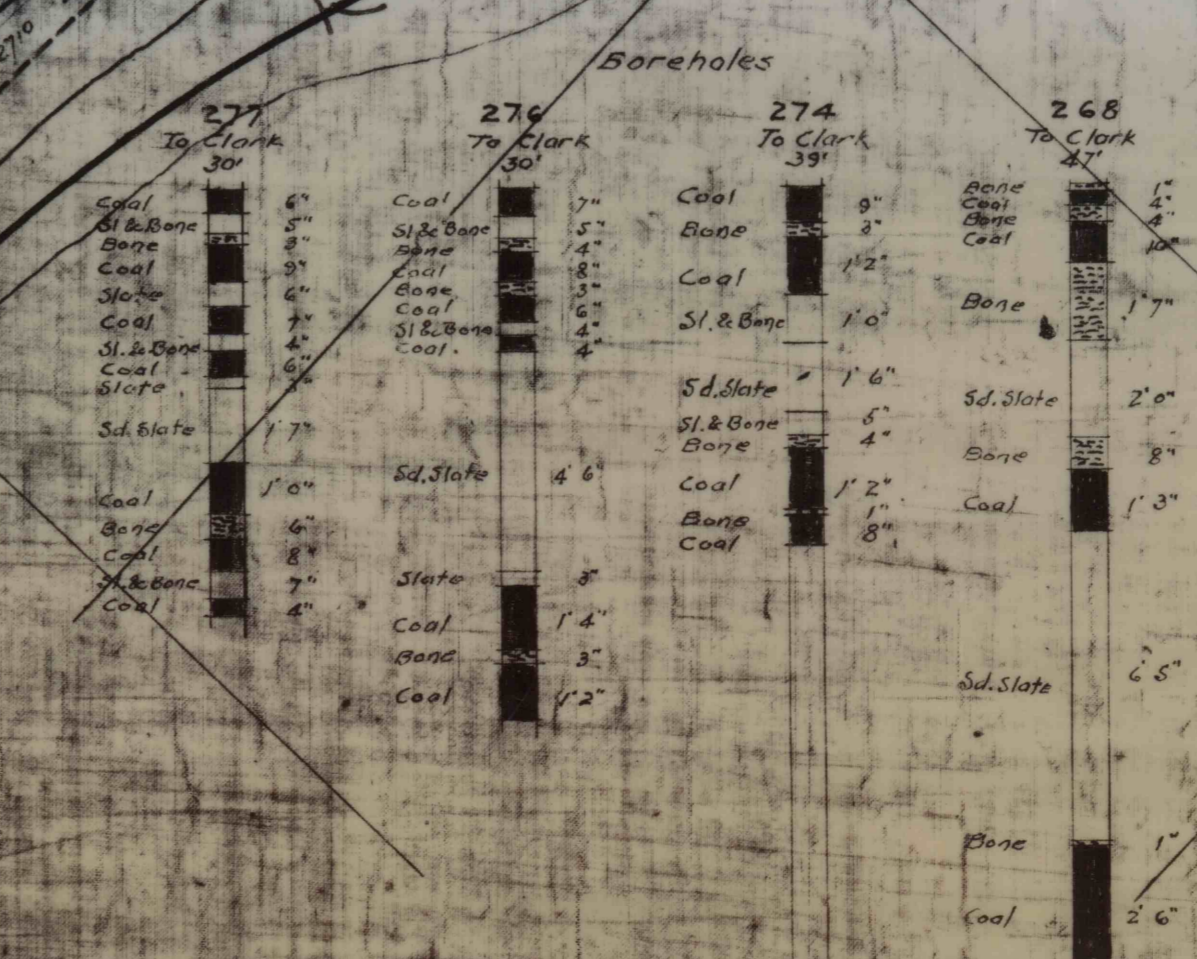

BINE BEGG