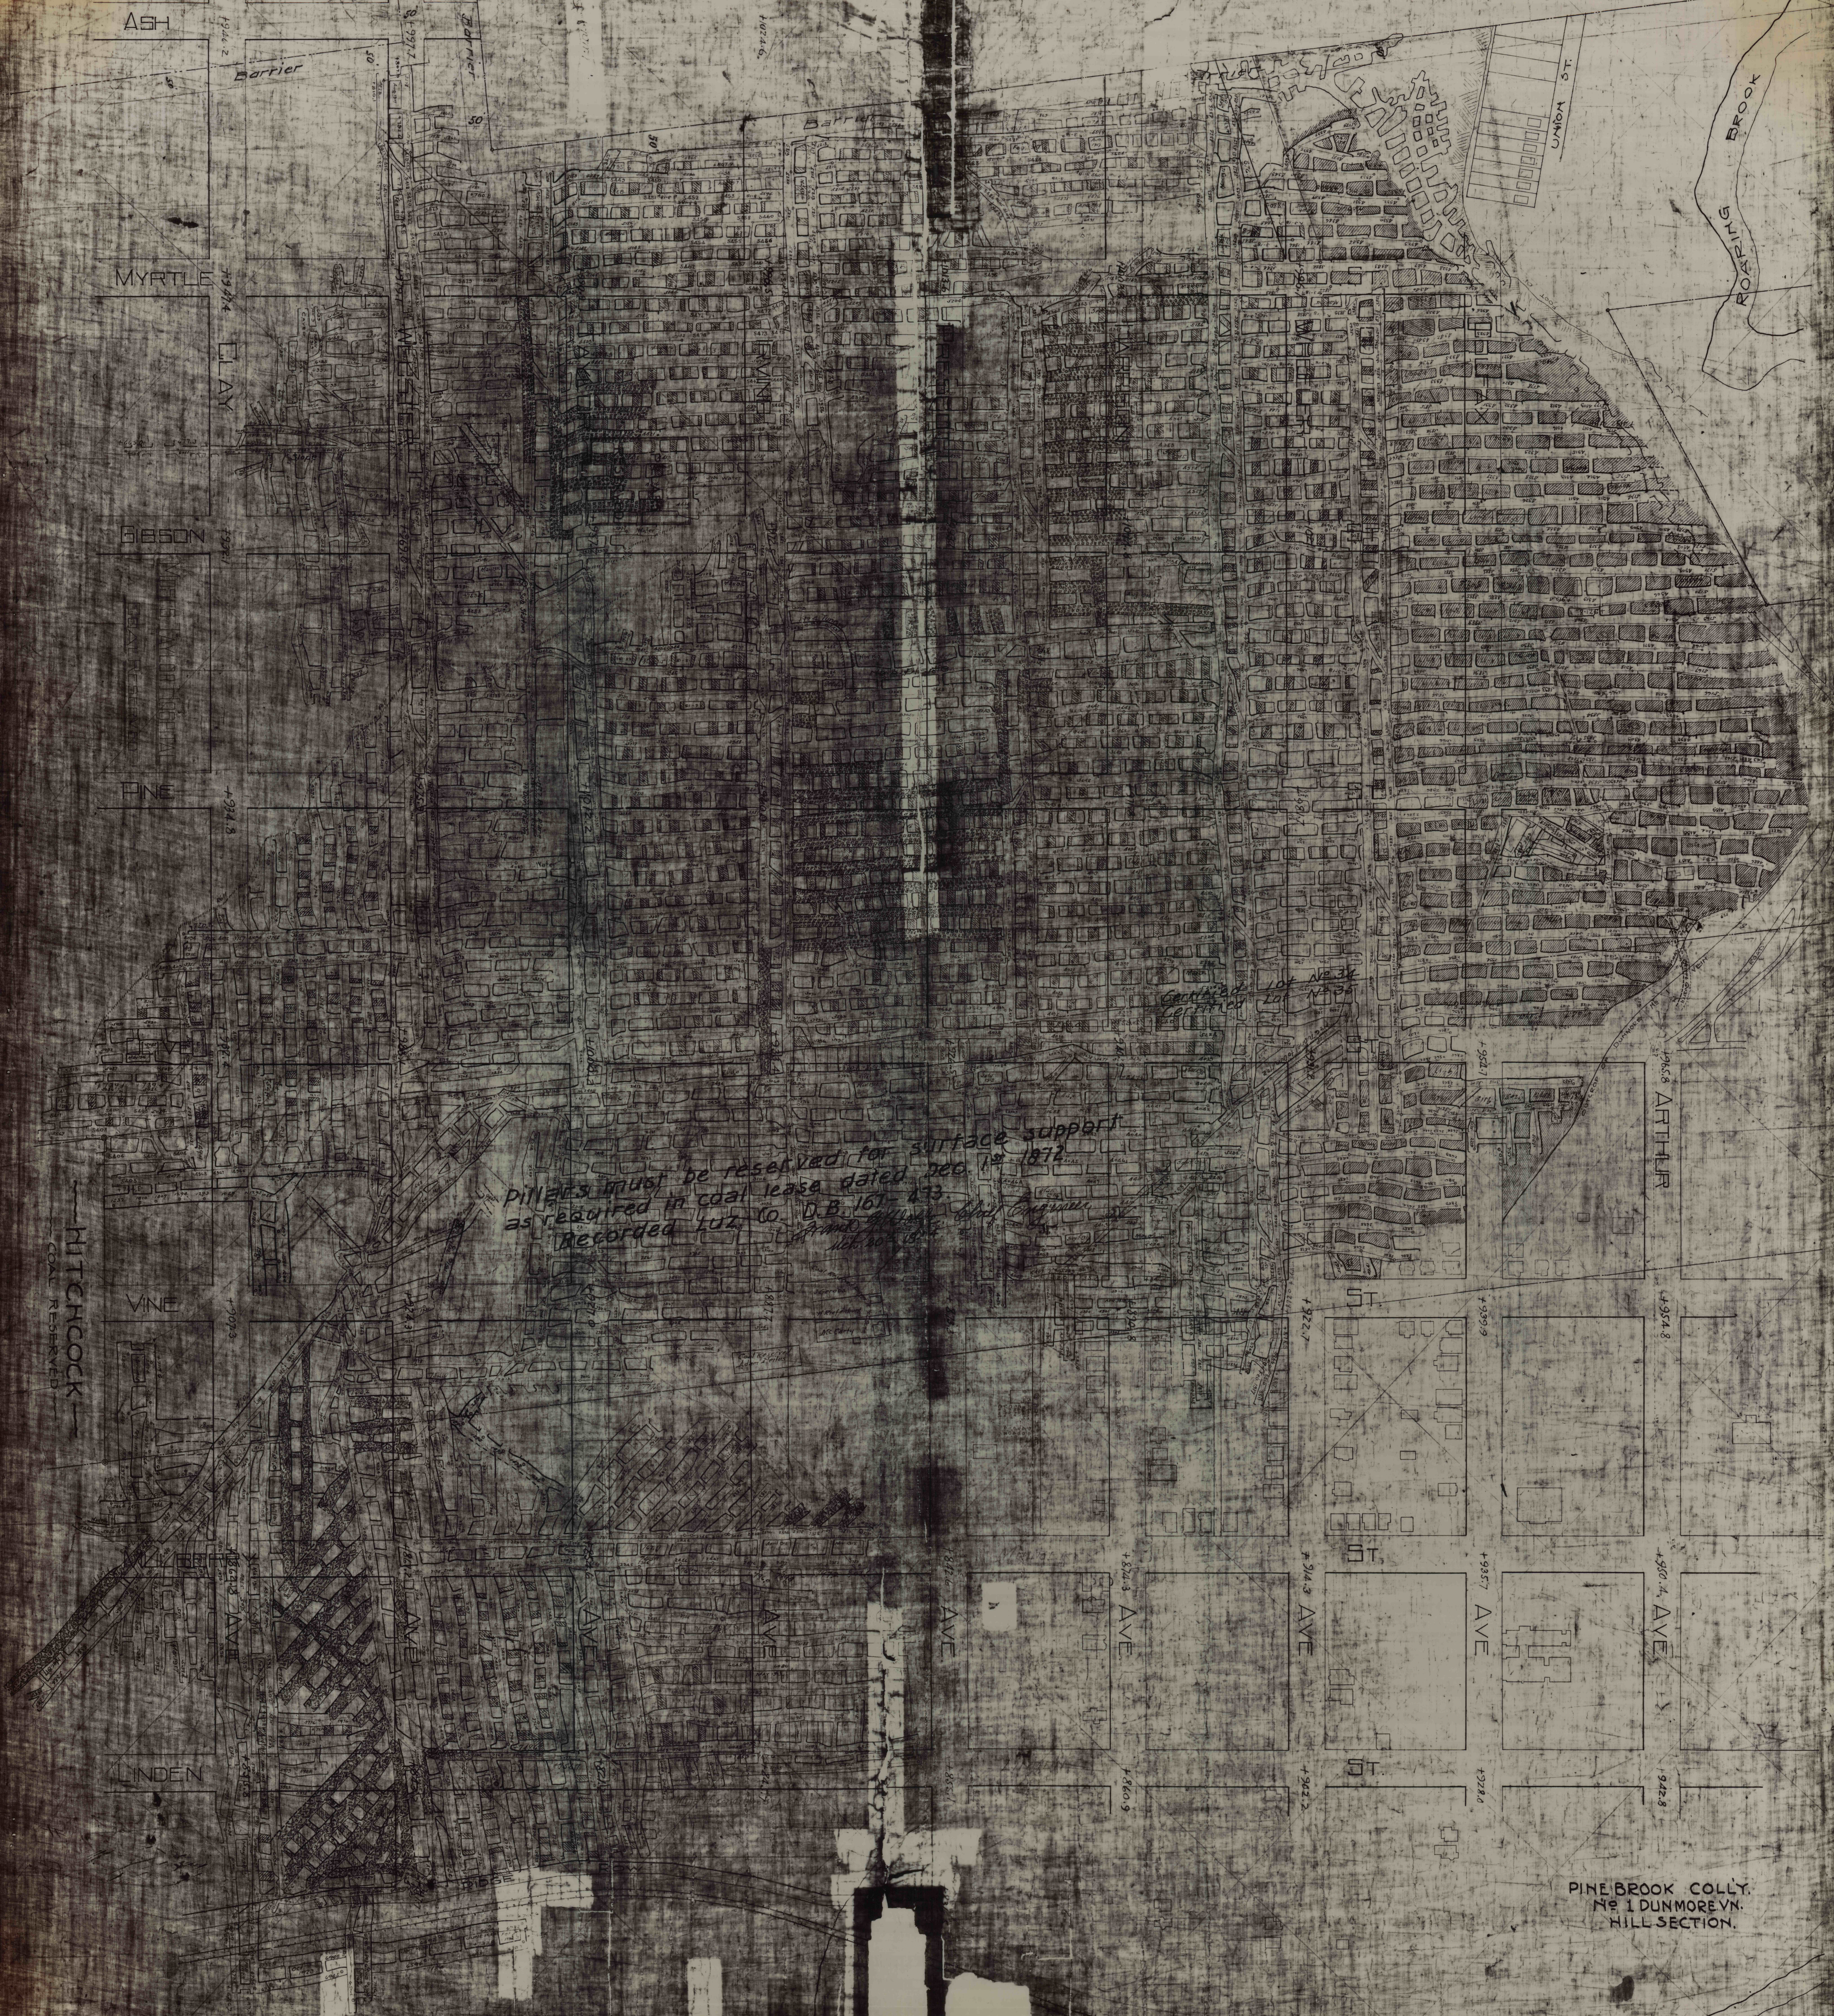

Pillars must be reserved for surface support as required in coal lease dated Dec. 1st 1872 Recorded Luz. Co. D.B. 167-473.

Frank J. [illegible] Chief Engineer
Mch. 20th 1914

PINE BROOK COLLY.
No 1 DUNMORE VN.
HILL SECTION.