


Bert New County

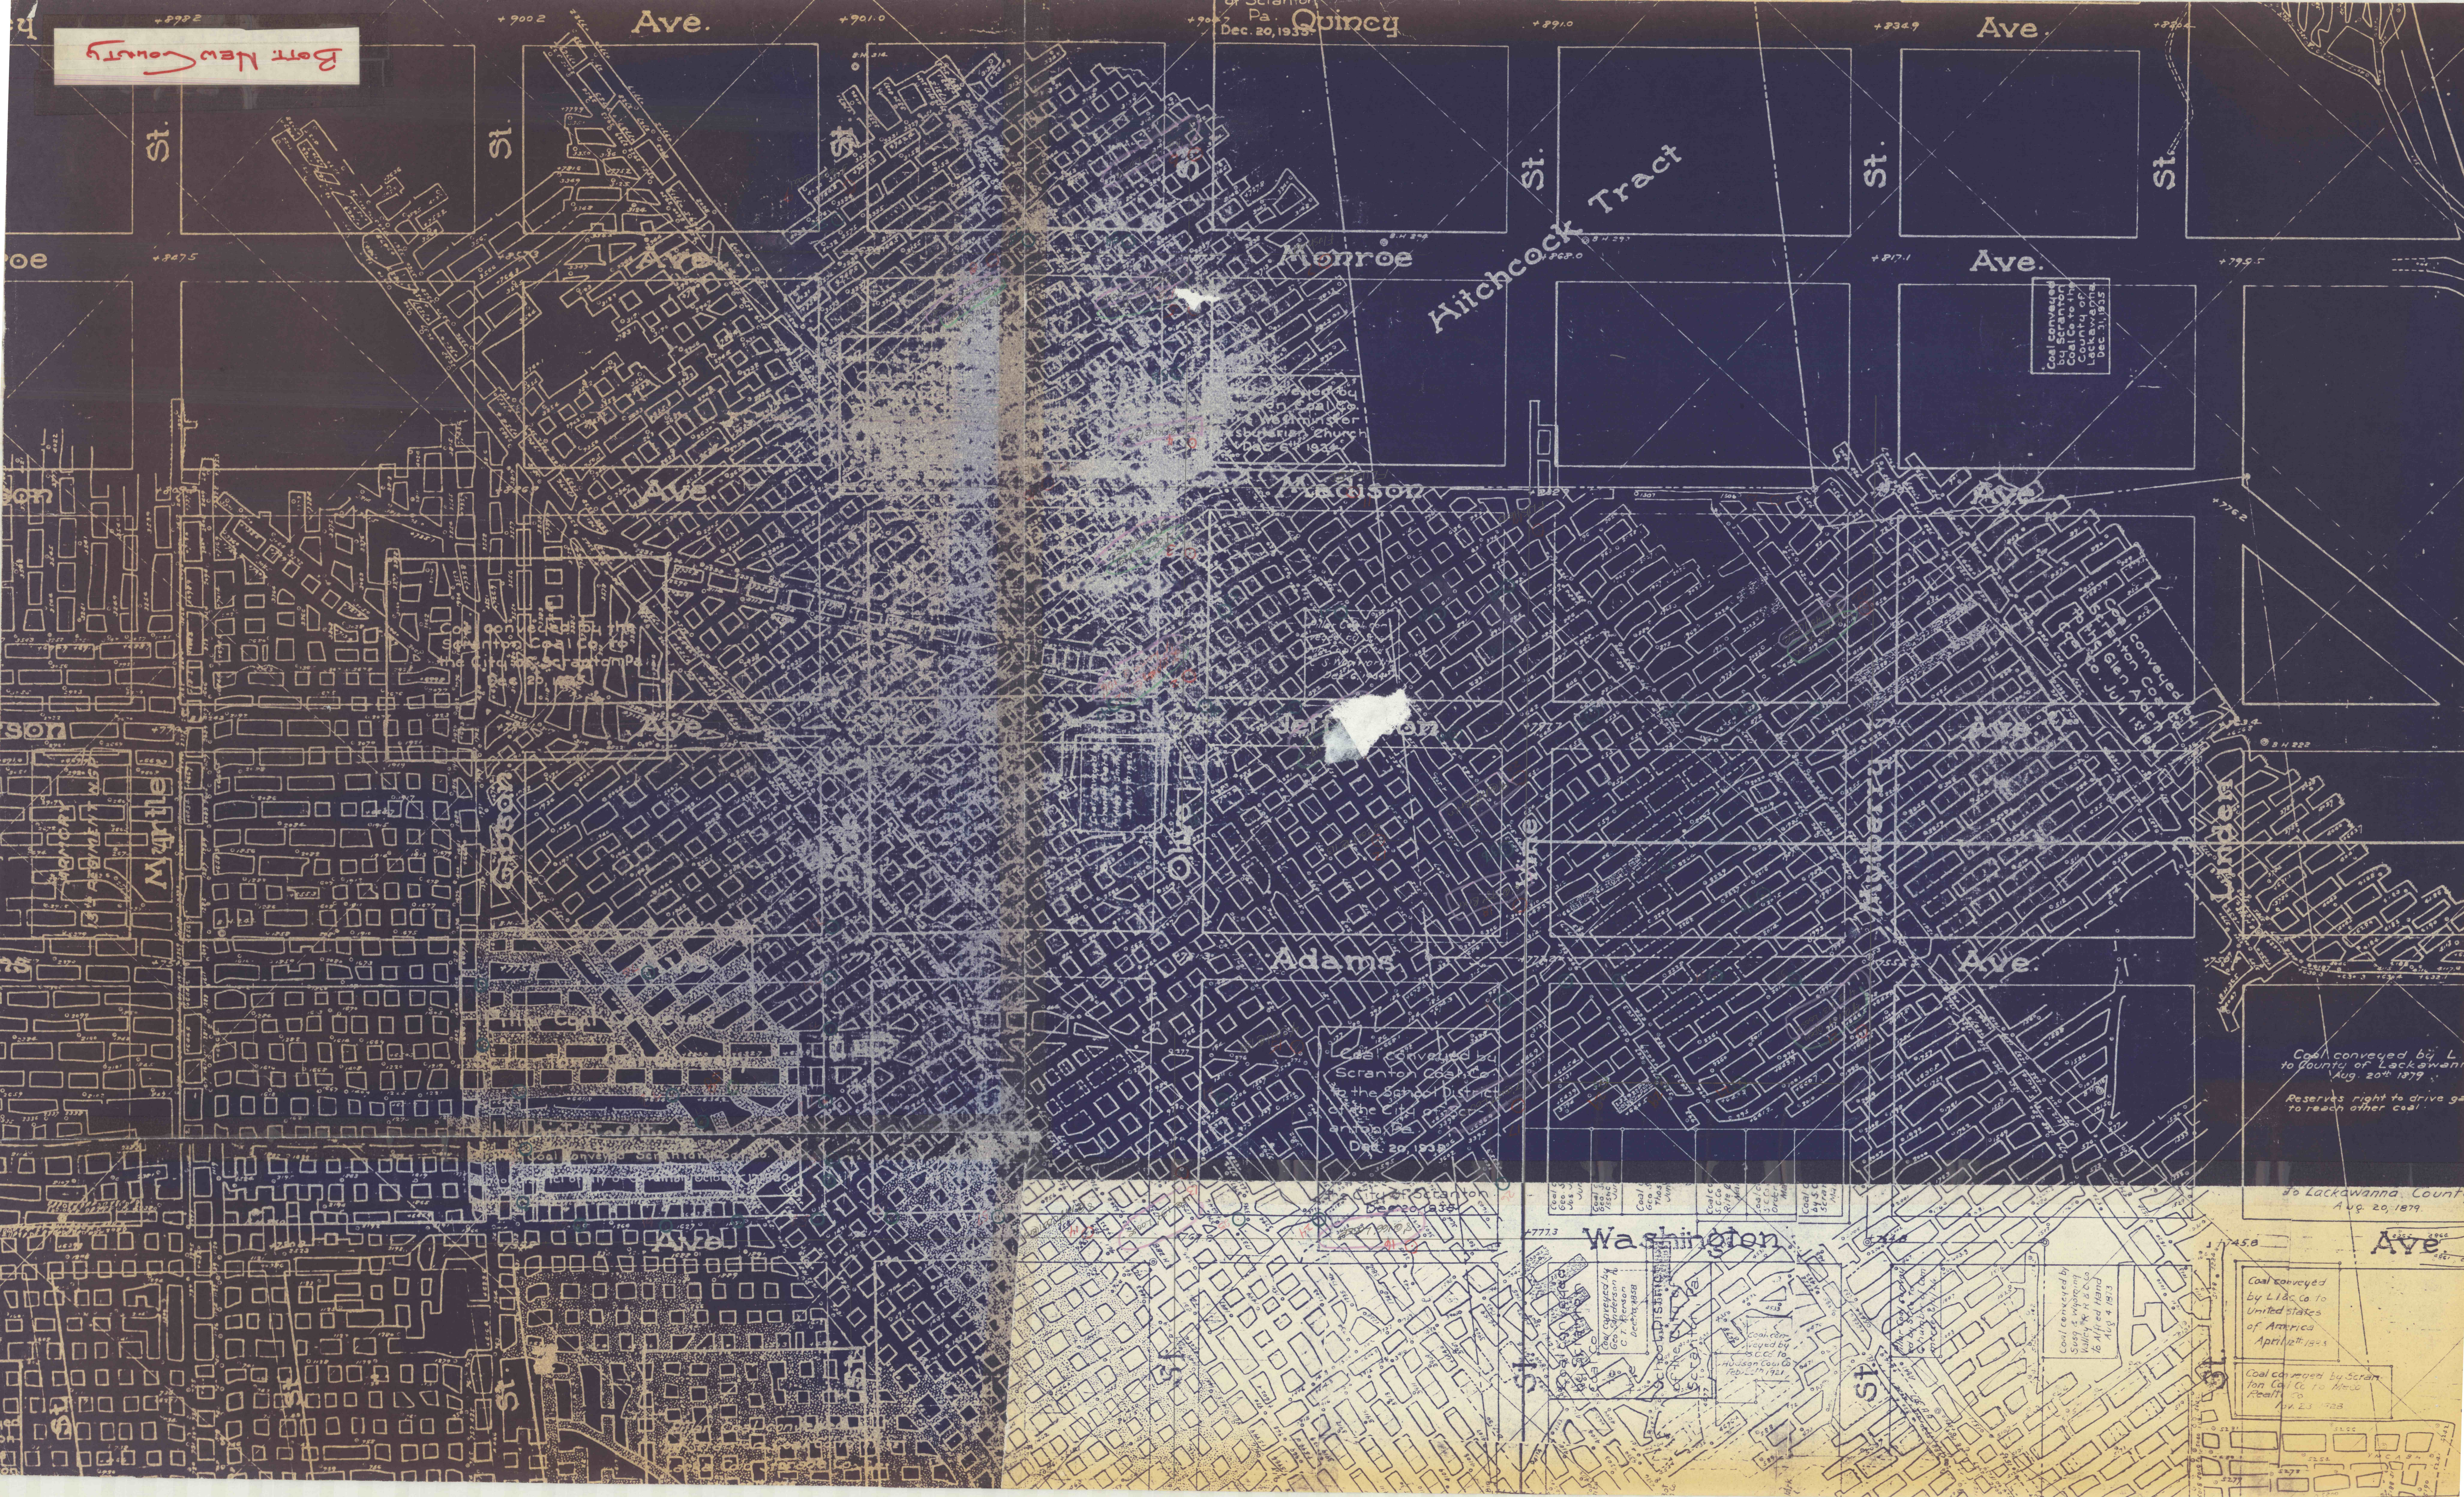

Quincy Pa Dec. 20, 1935

Hitchcock Tract



Coal conveyed by L. to County of Lackawanna Aug. 20th 1879. Reserves right to drive g. to reach other coal.

to Lackawanna County Aug. 20, 1879




Ave.

Ave.

St.

St.

St.

St.

St.

Monroe

Ave.

Madison

Adams

Washington

Ave.

Myrtle

St.

St.

St.

Ave.