

25P




P-6-H-6

P-6-H-7

P-6-H-8

P-6-H-5

P-6-H-4

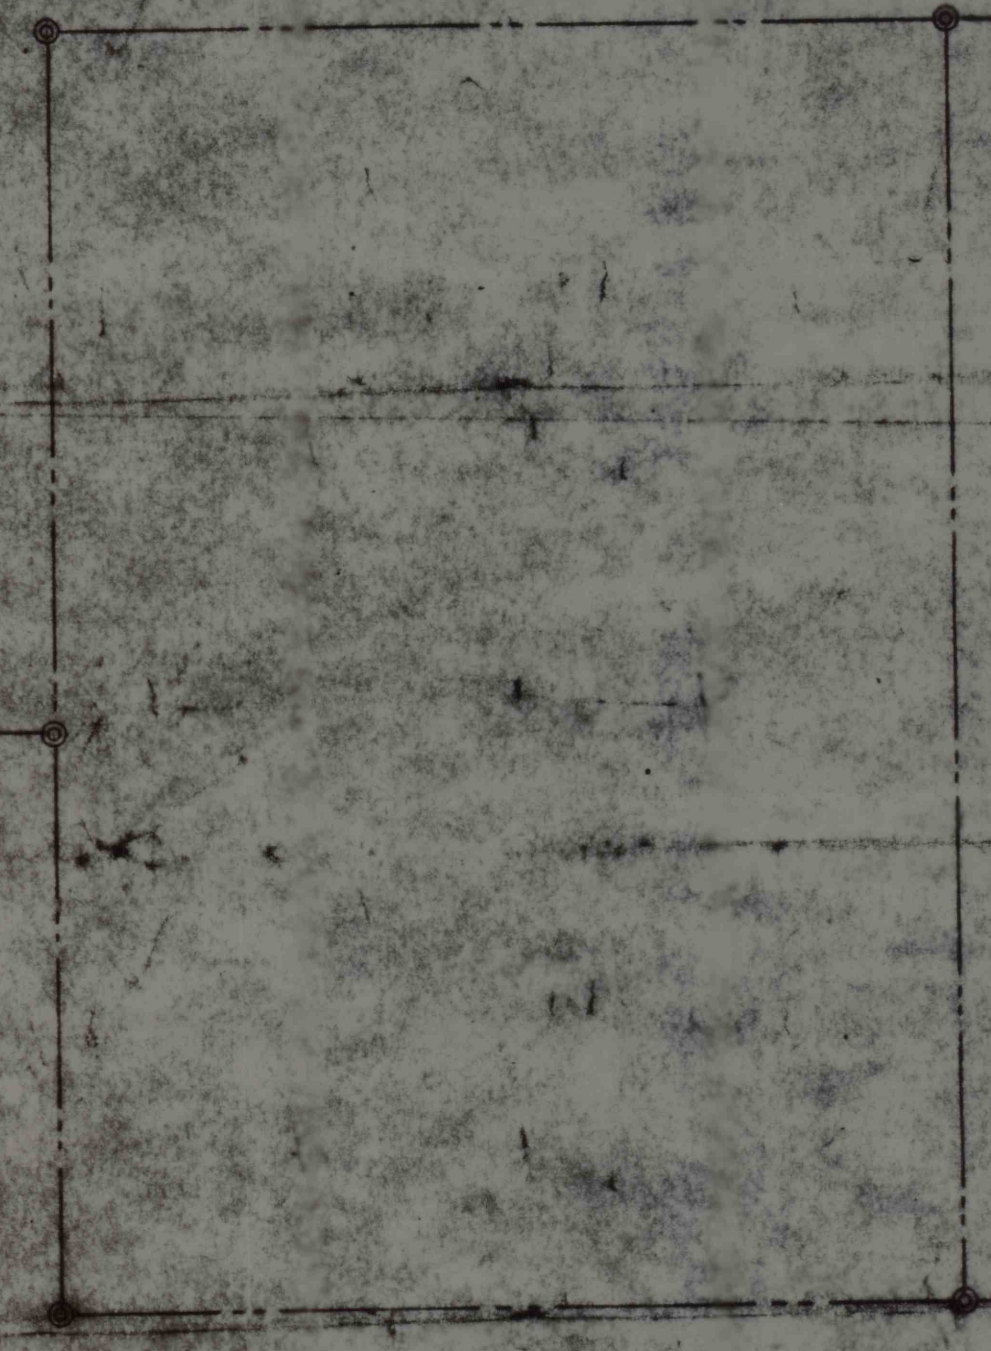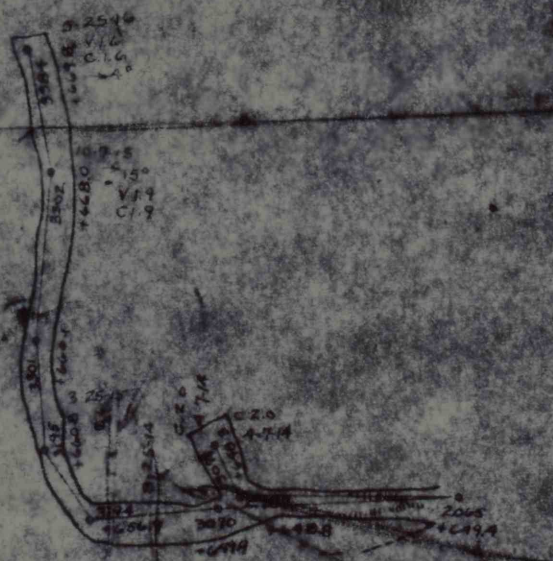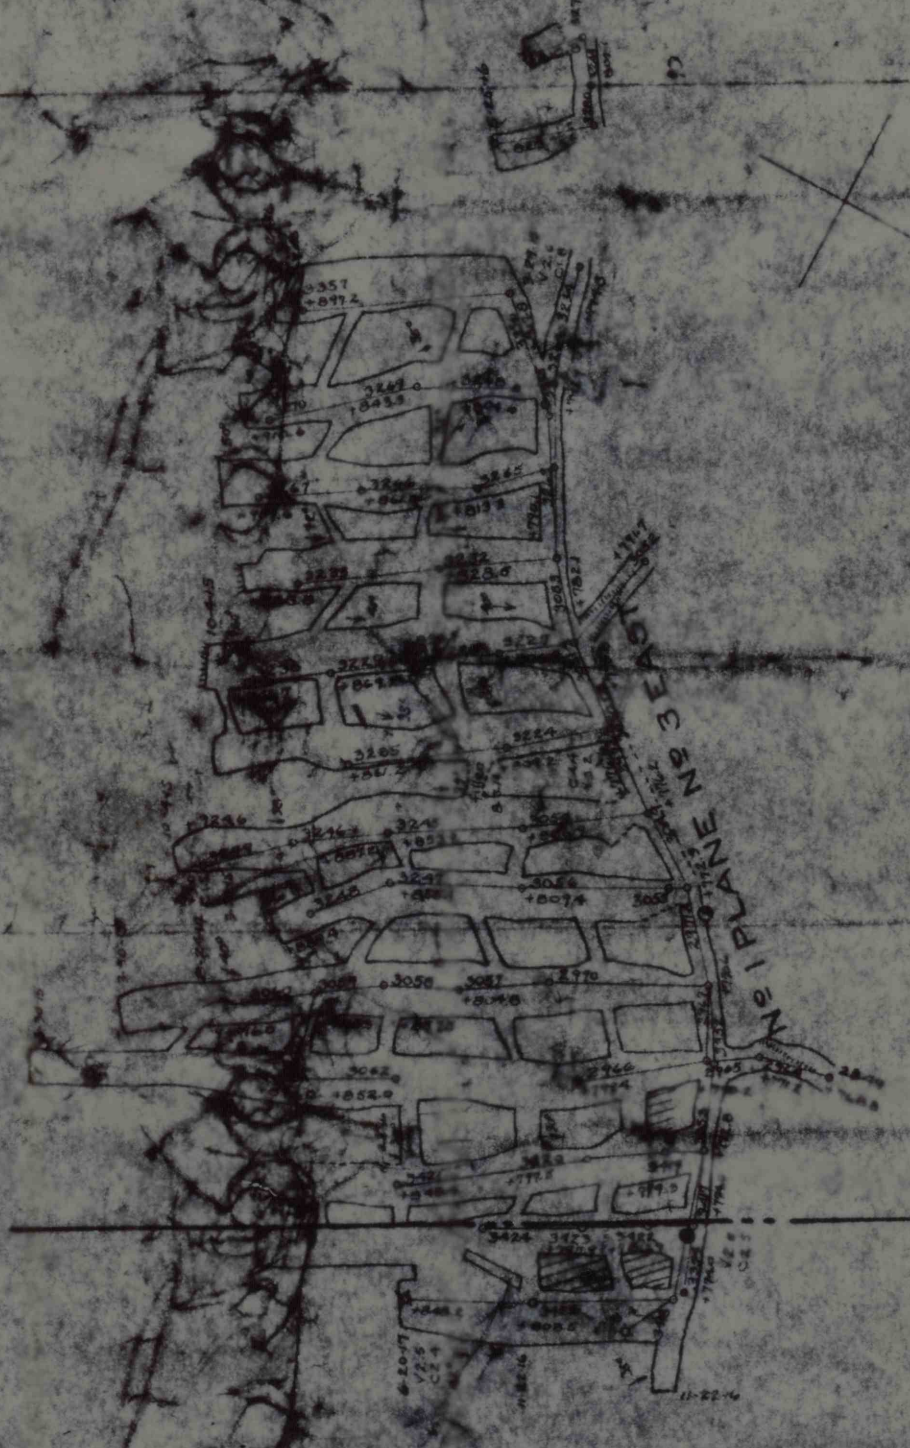

For 500 - 5000 - 1000