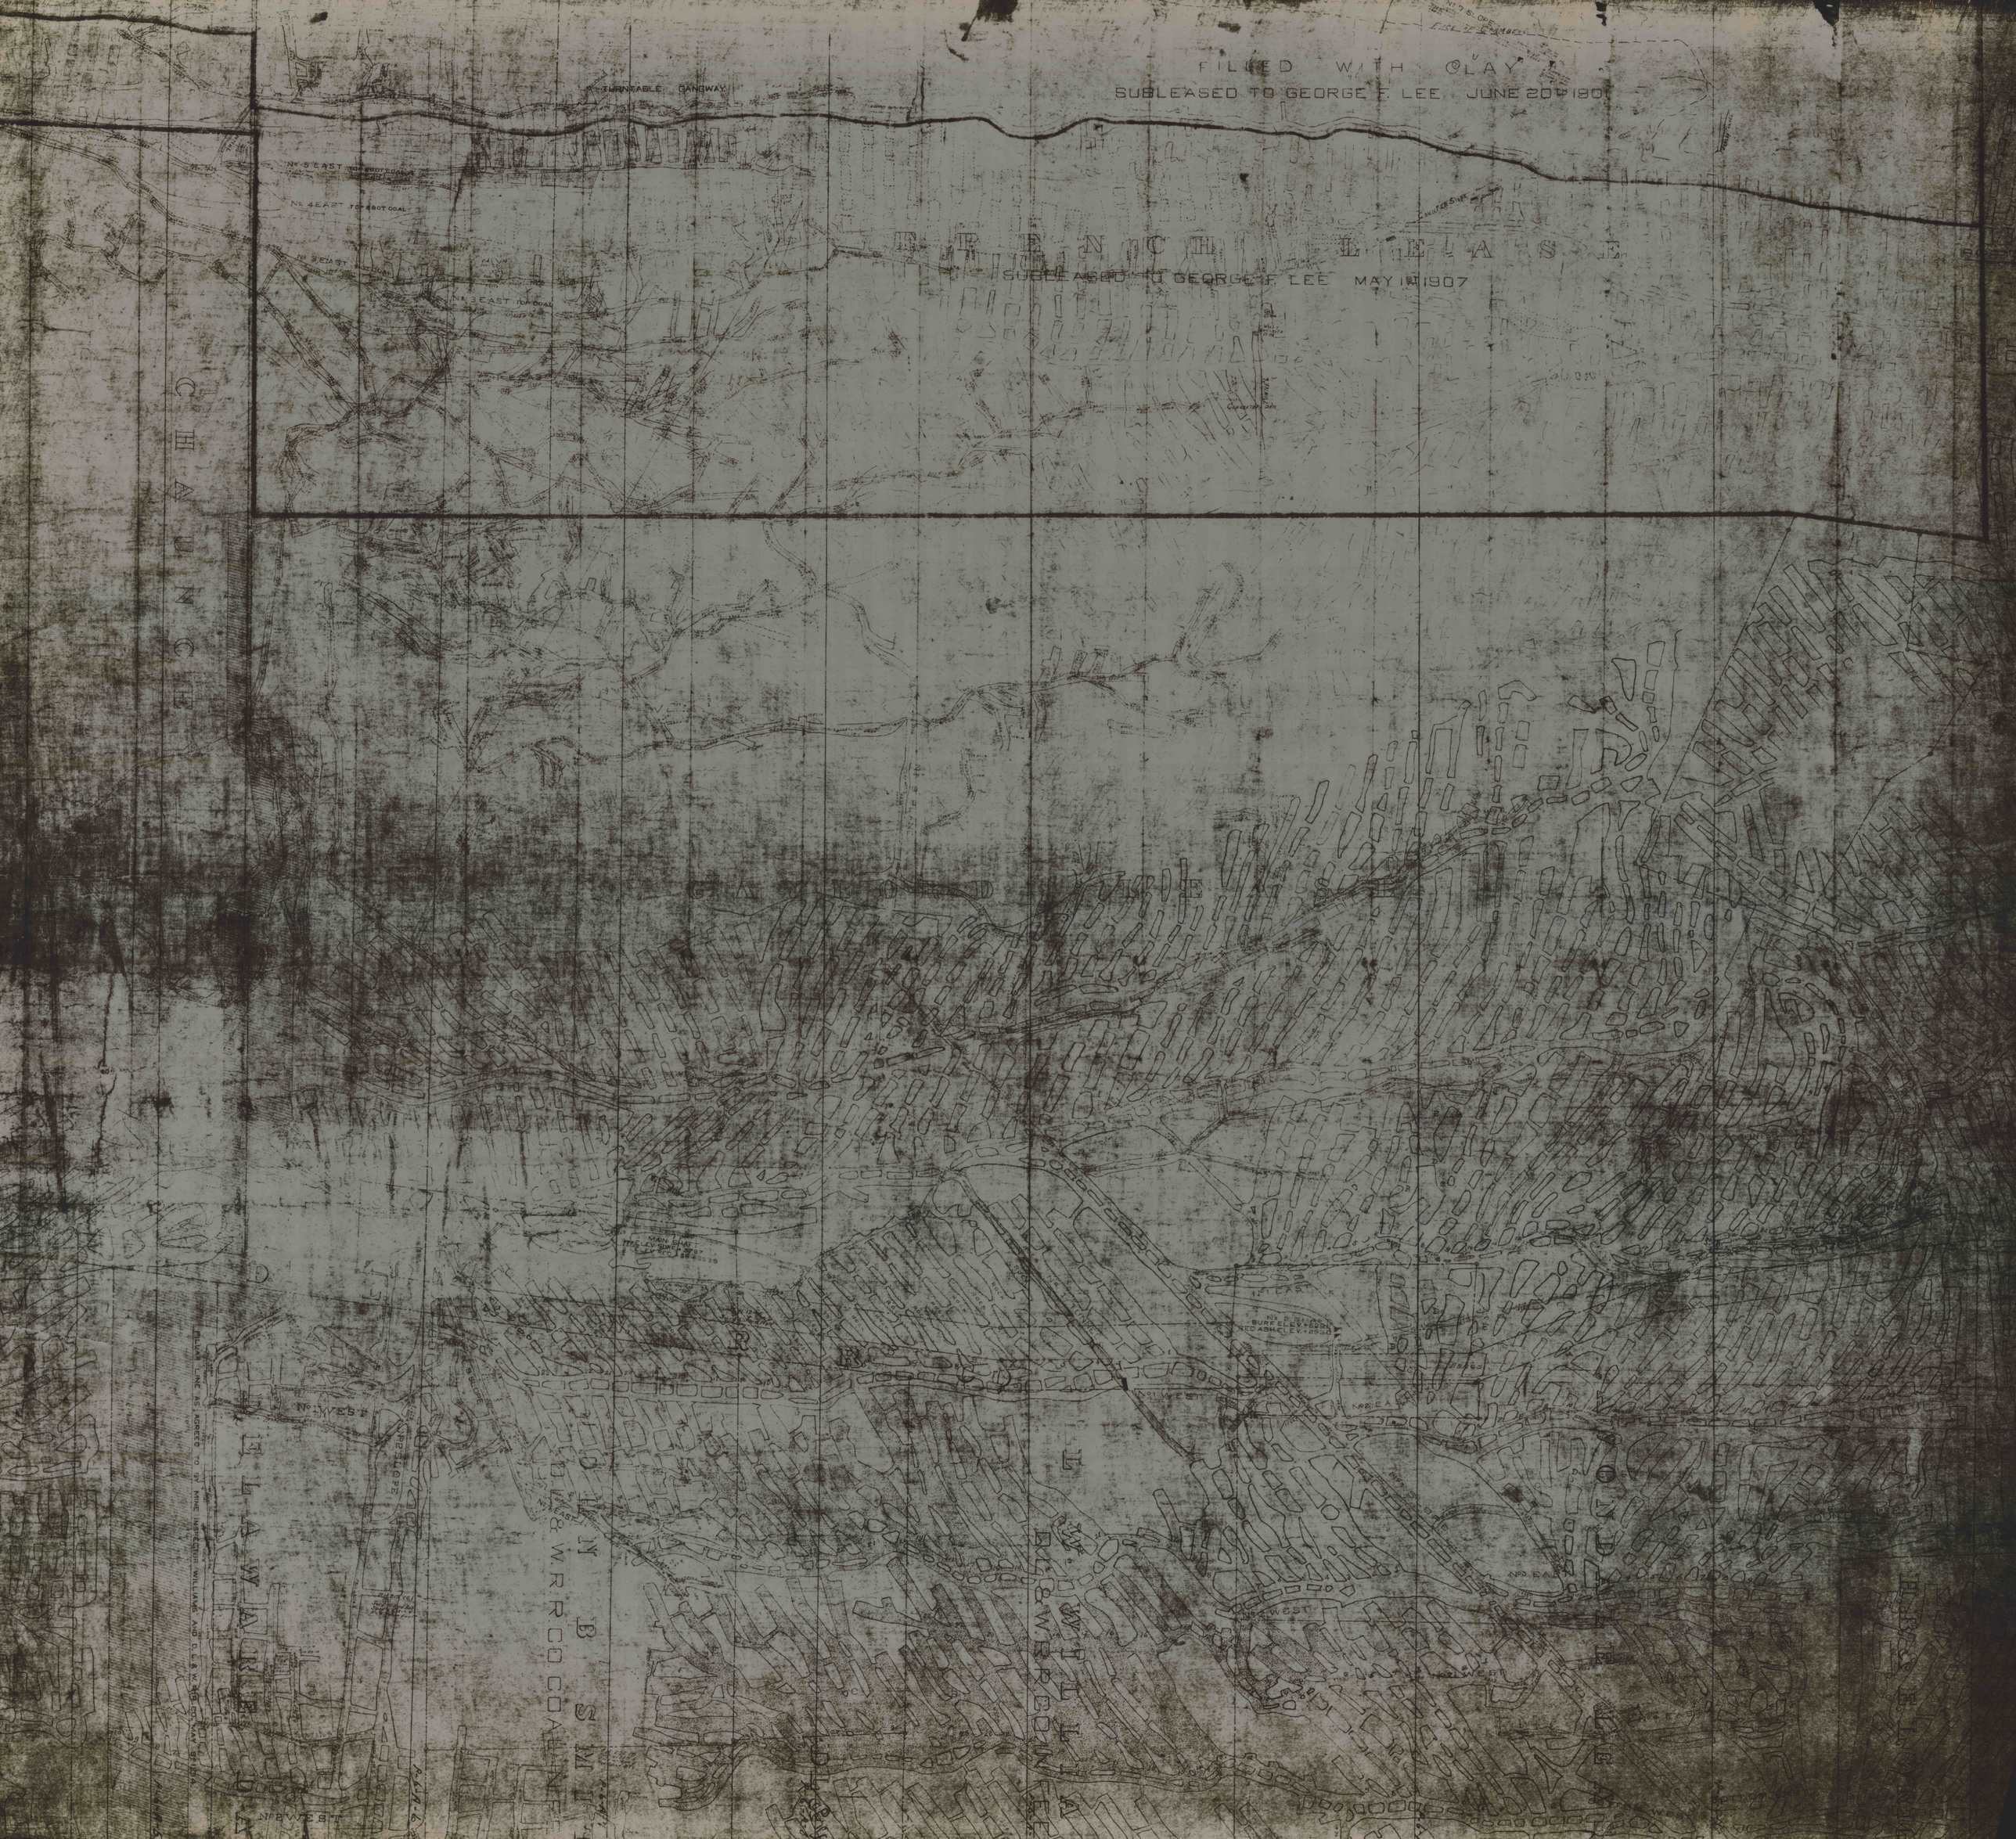
FILLED WITH CLAY
SUBLEASED TO GEORGE F. LEE JUNE 20TH 1907
TURNTABLE GANGWAY
No. 5 EAST TO FOOT COAL
No. 4 EAST TO FOOT COAL
No. 3 EAST TO COAL
FRENCH LEASE
SUBLEASED TO GEORGE F. LEE MAY 1ST 1907
CHAUNCEY
GALLOWAY
ELLA WATRE
No. 2 WEST
No. 1 WEST
No. 1 EAST
No. 2 EAST
No. 3 EAST
No. 4 EAST
No. 5 EAST
No. 6 EAST
No. 7 EAST
No. 8 EAST
No. 9 EAST
No. 10 EAST
No. 11 EAST
No. 12 EAST
No. 13 EAST
No.