

L. W. WILLIAMS NO. 2 LEASE.



FURNACE  
GLEN ALDEN COAL CO. COAL IN FEE.

L. W. WILLIAMS & D. L. B. W.  
GLEN ALDEN COAL CO. COAL IN FEE.

L. W. WILLIAMS NO. 2  
LEASE

J. B. SMITH  
GLEN ALDEN COAL CO. COAL IN FEE.

THOS. DARLING  
GLEN ALDEN COAL CO. COAL IN FEE.

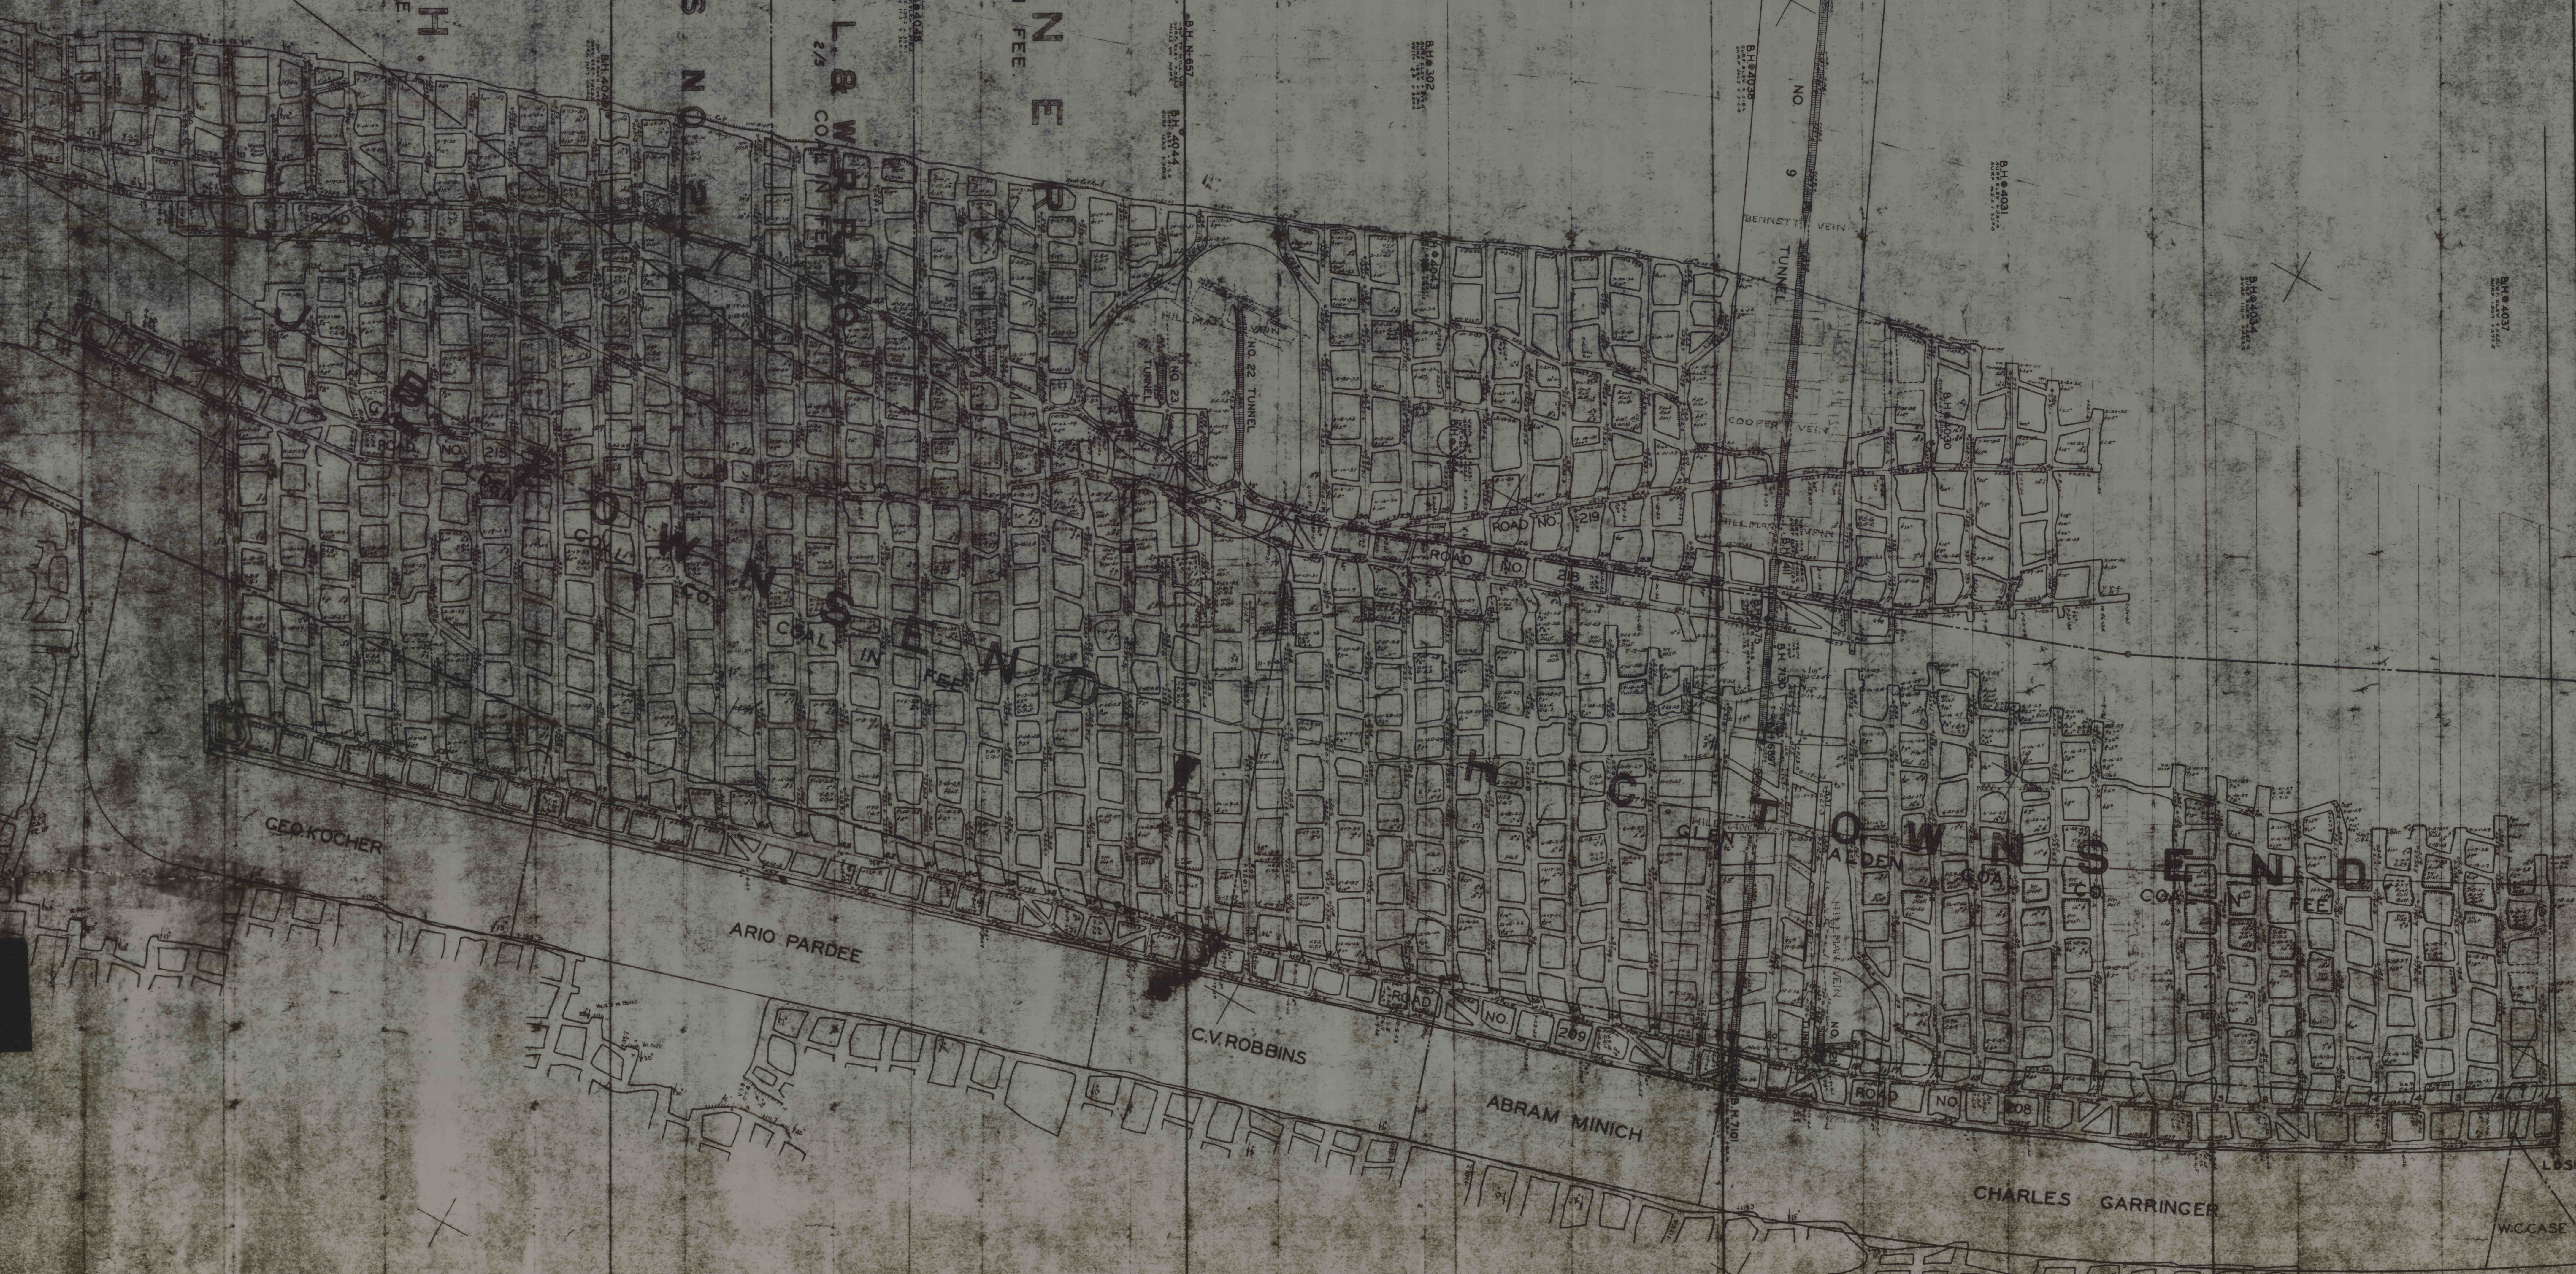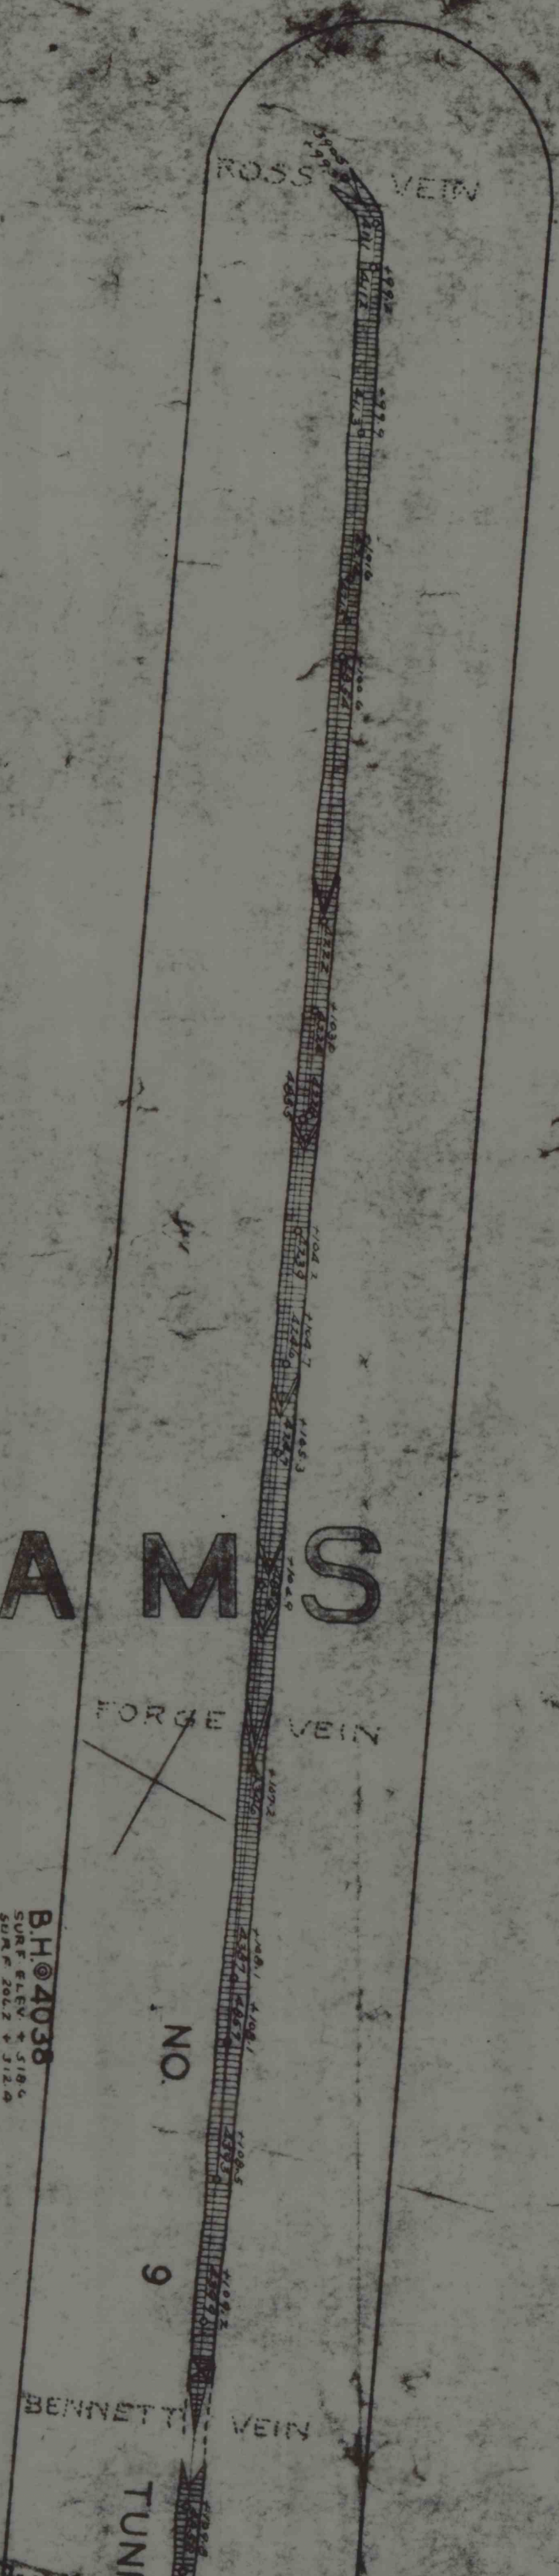

GED KOCHER

ARIO PARDEE

C.V. ROBBINS

ABRAM MINICH

CHARLES GARRINGER

L. SHOEMAKER  
NO. 3  
W. CASE

SECTION LINE E

SECTION LINE E

