


SUSQUEHANNA  
COAL  
CO.

POSTED  
In Service 1912  
May 23 1909 M  
Oct 1 1910 M  
April 2 1908 M  
April 2 1908 M

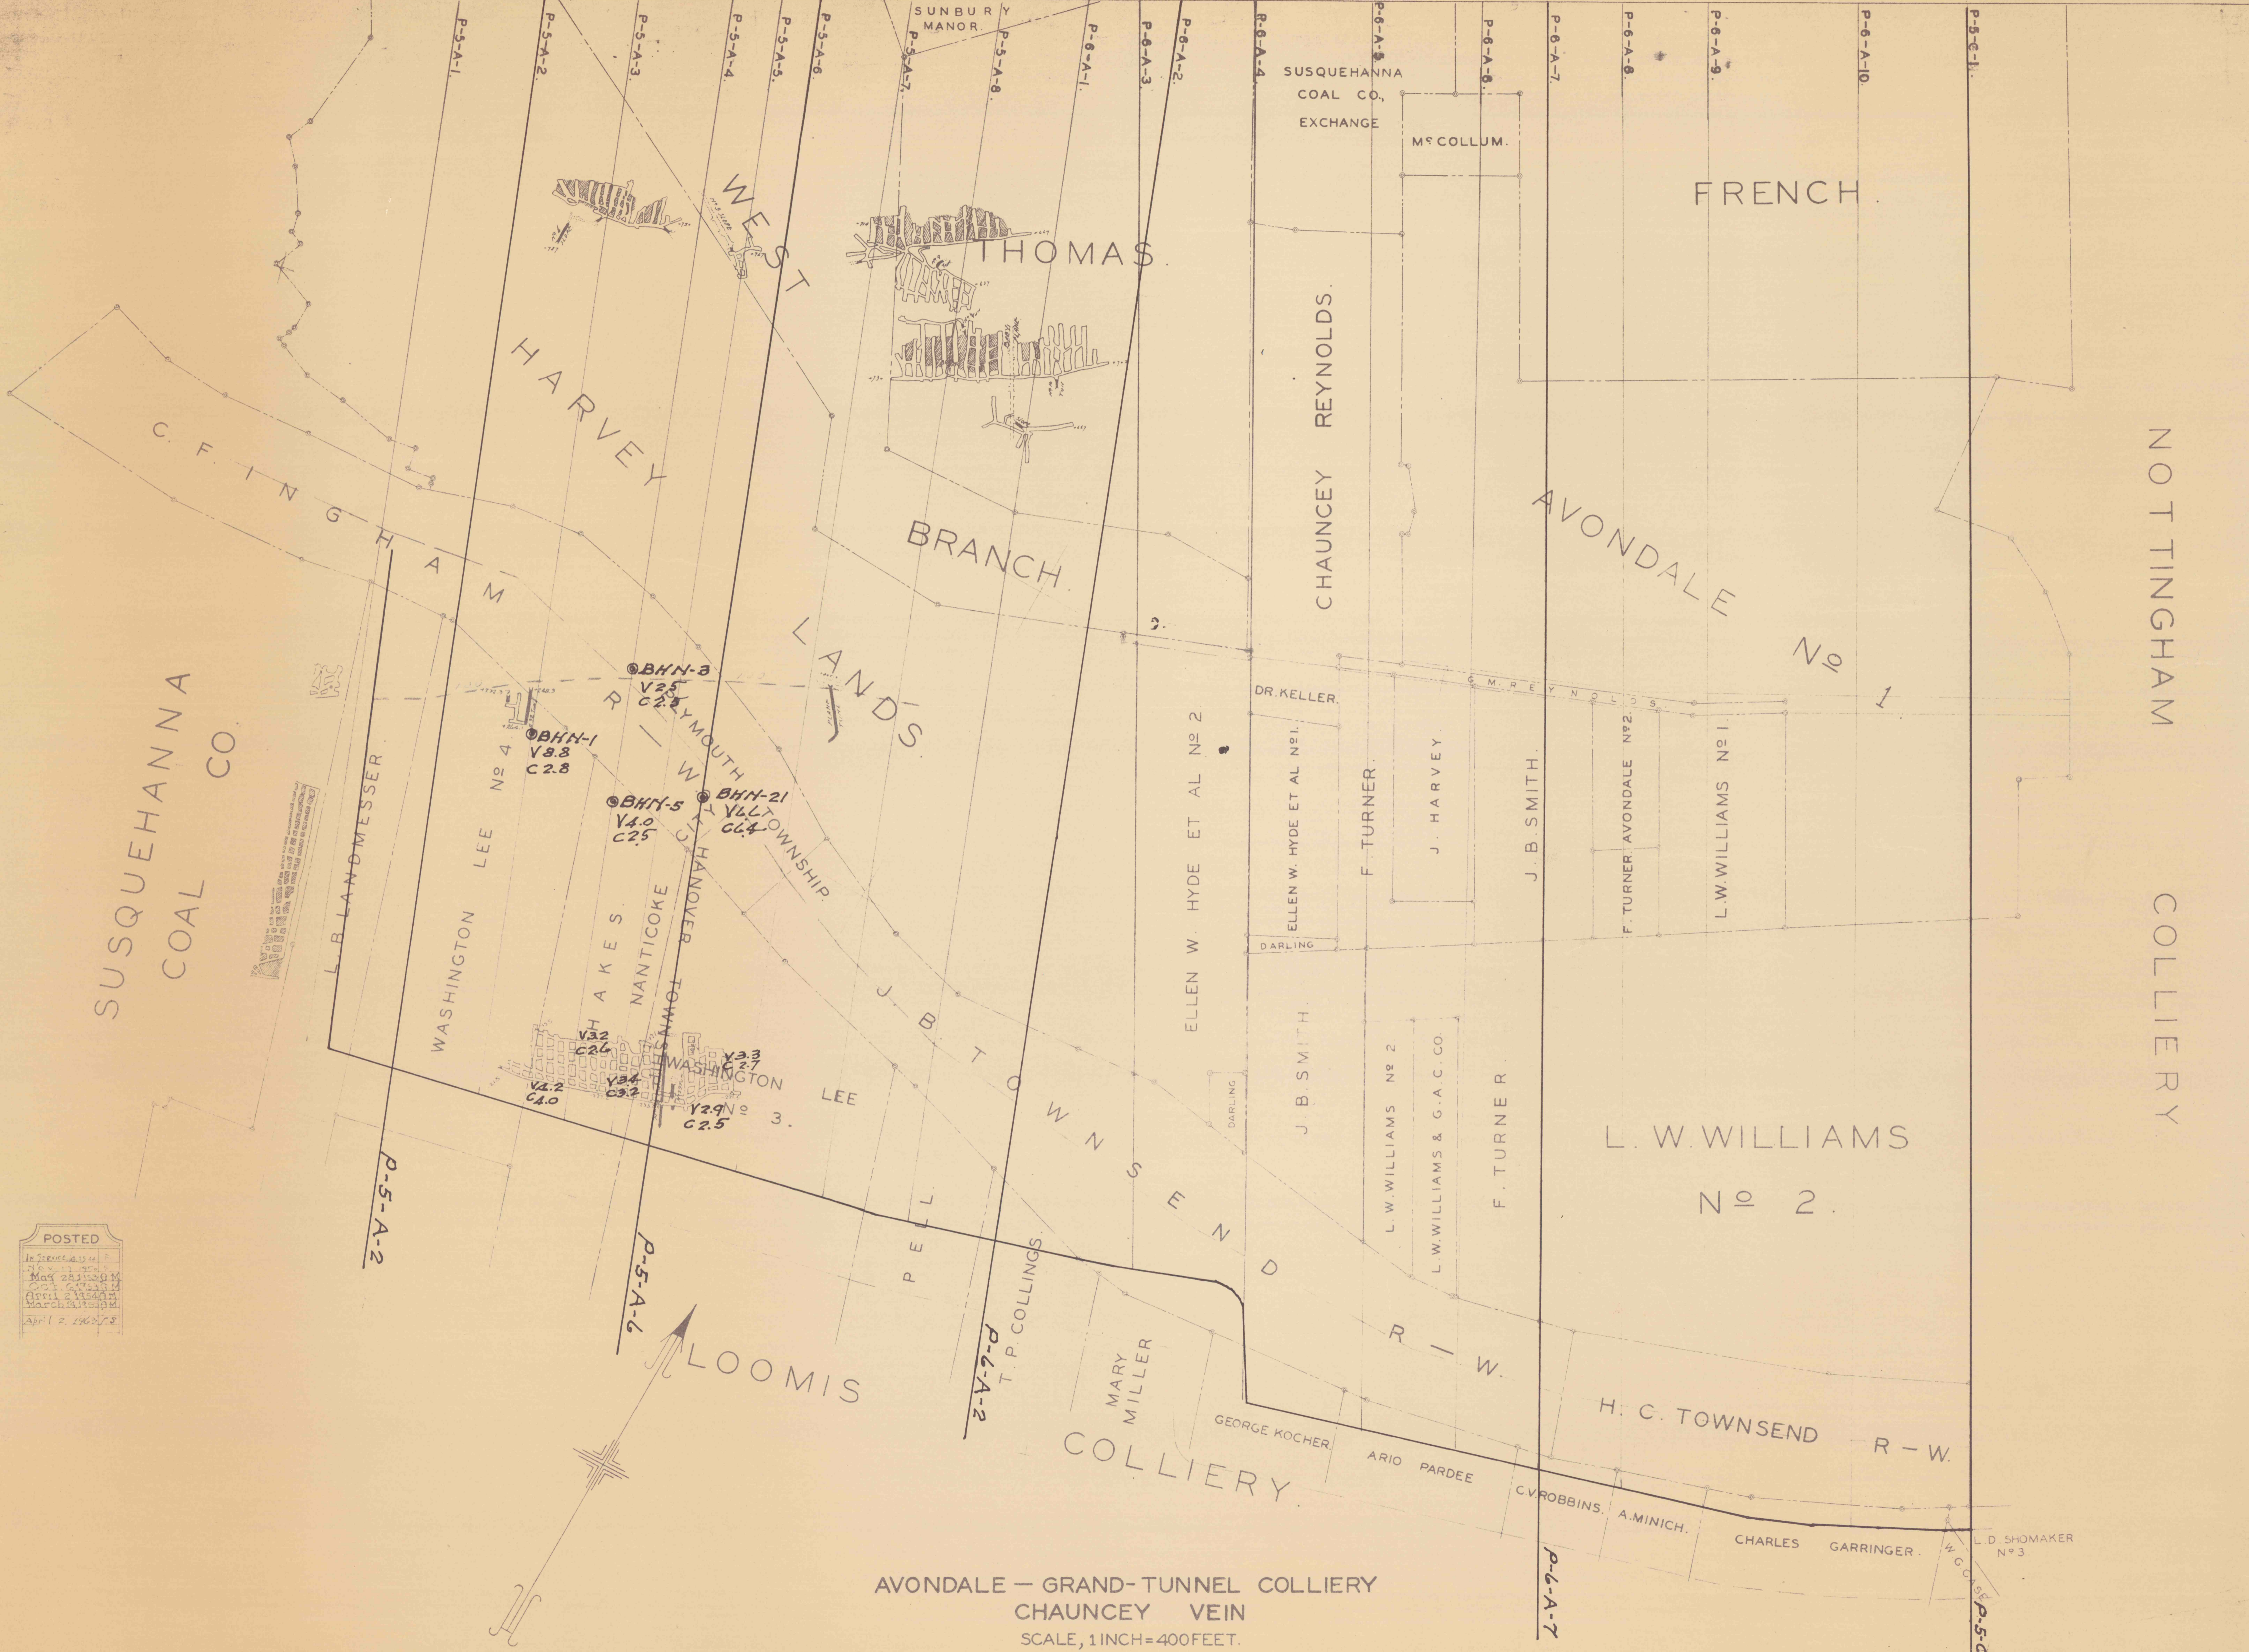

AVONDALE - GRAND-TUNNEL COLLIERY  
CHAUNCEY VEIN  
SCALE, 1 INCH = 400 FEET.

NOTTINGHAM

COLLIERY

FRENCH

THOMAS

HARVEY

WEST

BRANCH

LANDS

AVONDALE

No 1

WASHINGTON LEE No 4  
HAKES  
NANTICOKE  
WASHINGTON LEE No 3  
WASHINGTON LEE No 2

CHAUNCEY REYNOLDS

ELLEN W. HYDE ET AL No 2

DR. KELLER  
ELLEN W. HYDE ET AL No 1  
DARLING

F. TURNER

J. HARVEY

J. B. SMITH

F. TURNER AVONDALE No 2

L. W. WILLIAMS No 1

J. B. SMITH

L. W. WILLIAMS No 2

L. W. WILLIAMS & G. A. C. CO.

F. TURNER

L. W. WILLIAMS  
No 2

LOOMIS

MARY MILLER  
COLLIERY

H. C. TOWNSEND

R - W.

GEORGE KOCHER

ARIO PARDEE

C. V. ROBBINS

A. MINICH

CHARLES GARRINGER

L. D. SHOMAKER  
No 3

P-5-A-1

P-5-A-2

P-5-A-3

P-5-A-4

P-5-A-5

P-5-A-6

P-5-A-7

P-5-A-8

P-6-A-1

P-6-A-3

P-6-A-2

P-6-A-4

P-6-A-6

P-6-A-7

P-6-A-8

P-6-A-9

P-6-A-10

P-5-C-1

P-5-A-2

P-5-A-6

P-6-A-2

P-6-A-7

P-5-C-1