


NOTTINGHAM COLLIERY

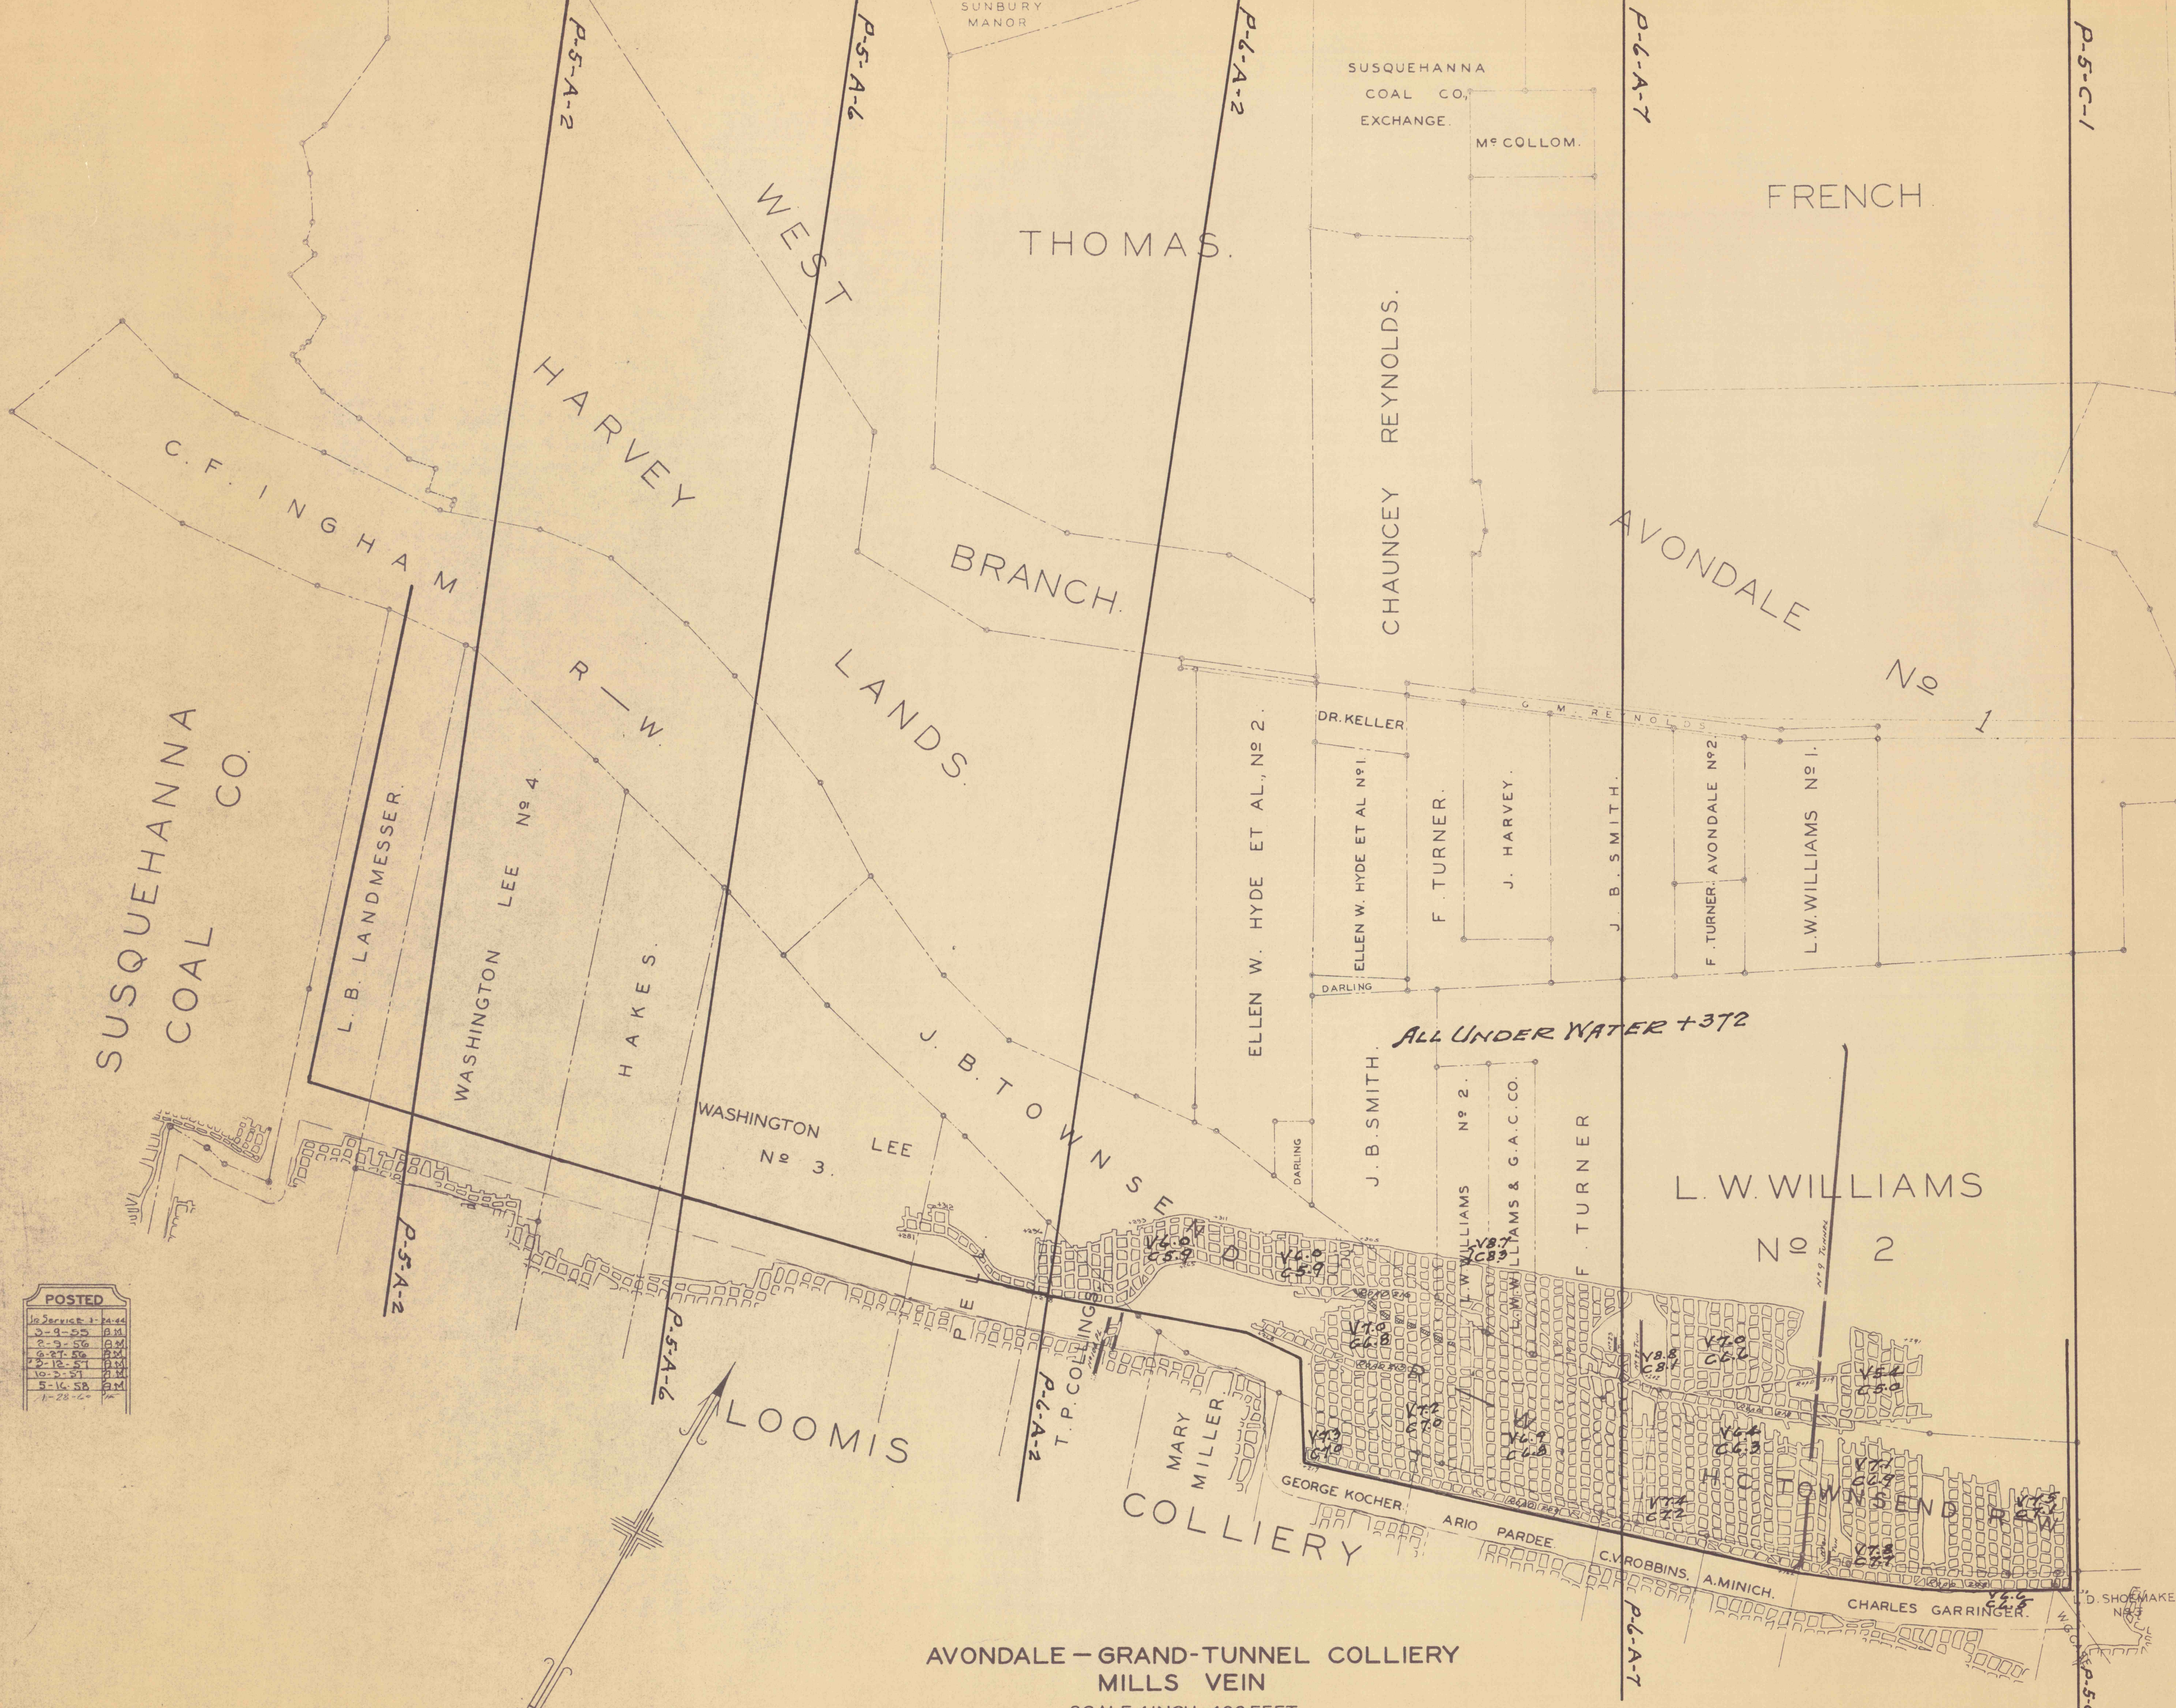

SUSQUEHANNA COAL CO.

THOMAS.

FRENCH.

HARVEY

BRANCH.

AVONDALE

LANDS.

No 1

WASHINGTON LEE No 4.

HAKES.

WASHINGTON LEE No 3.

J. B. TOWNSE

ALL UNDER WATER + 372

L. W. WILLIAMS No 2

POSTED	
10 Service	1-1-11
1-9-11	1-1-11
2-9-11	1-1-11
LOOMIS

MARY MILLER COLLIERY

AVONDALE - GRAND-TUNNEL COLLIERY MILLS VEIN

SCALE, 1 INCH = 400 FEET.