


SUSQUEHANNA
COAL
CO.

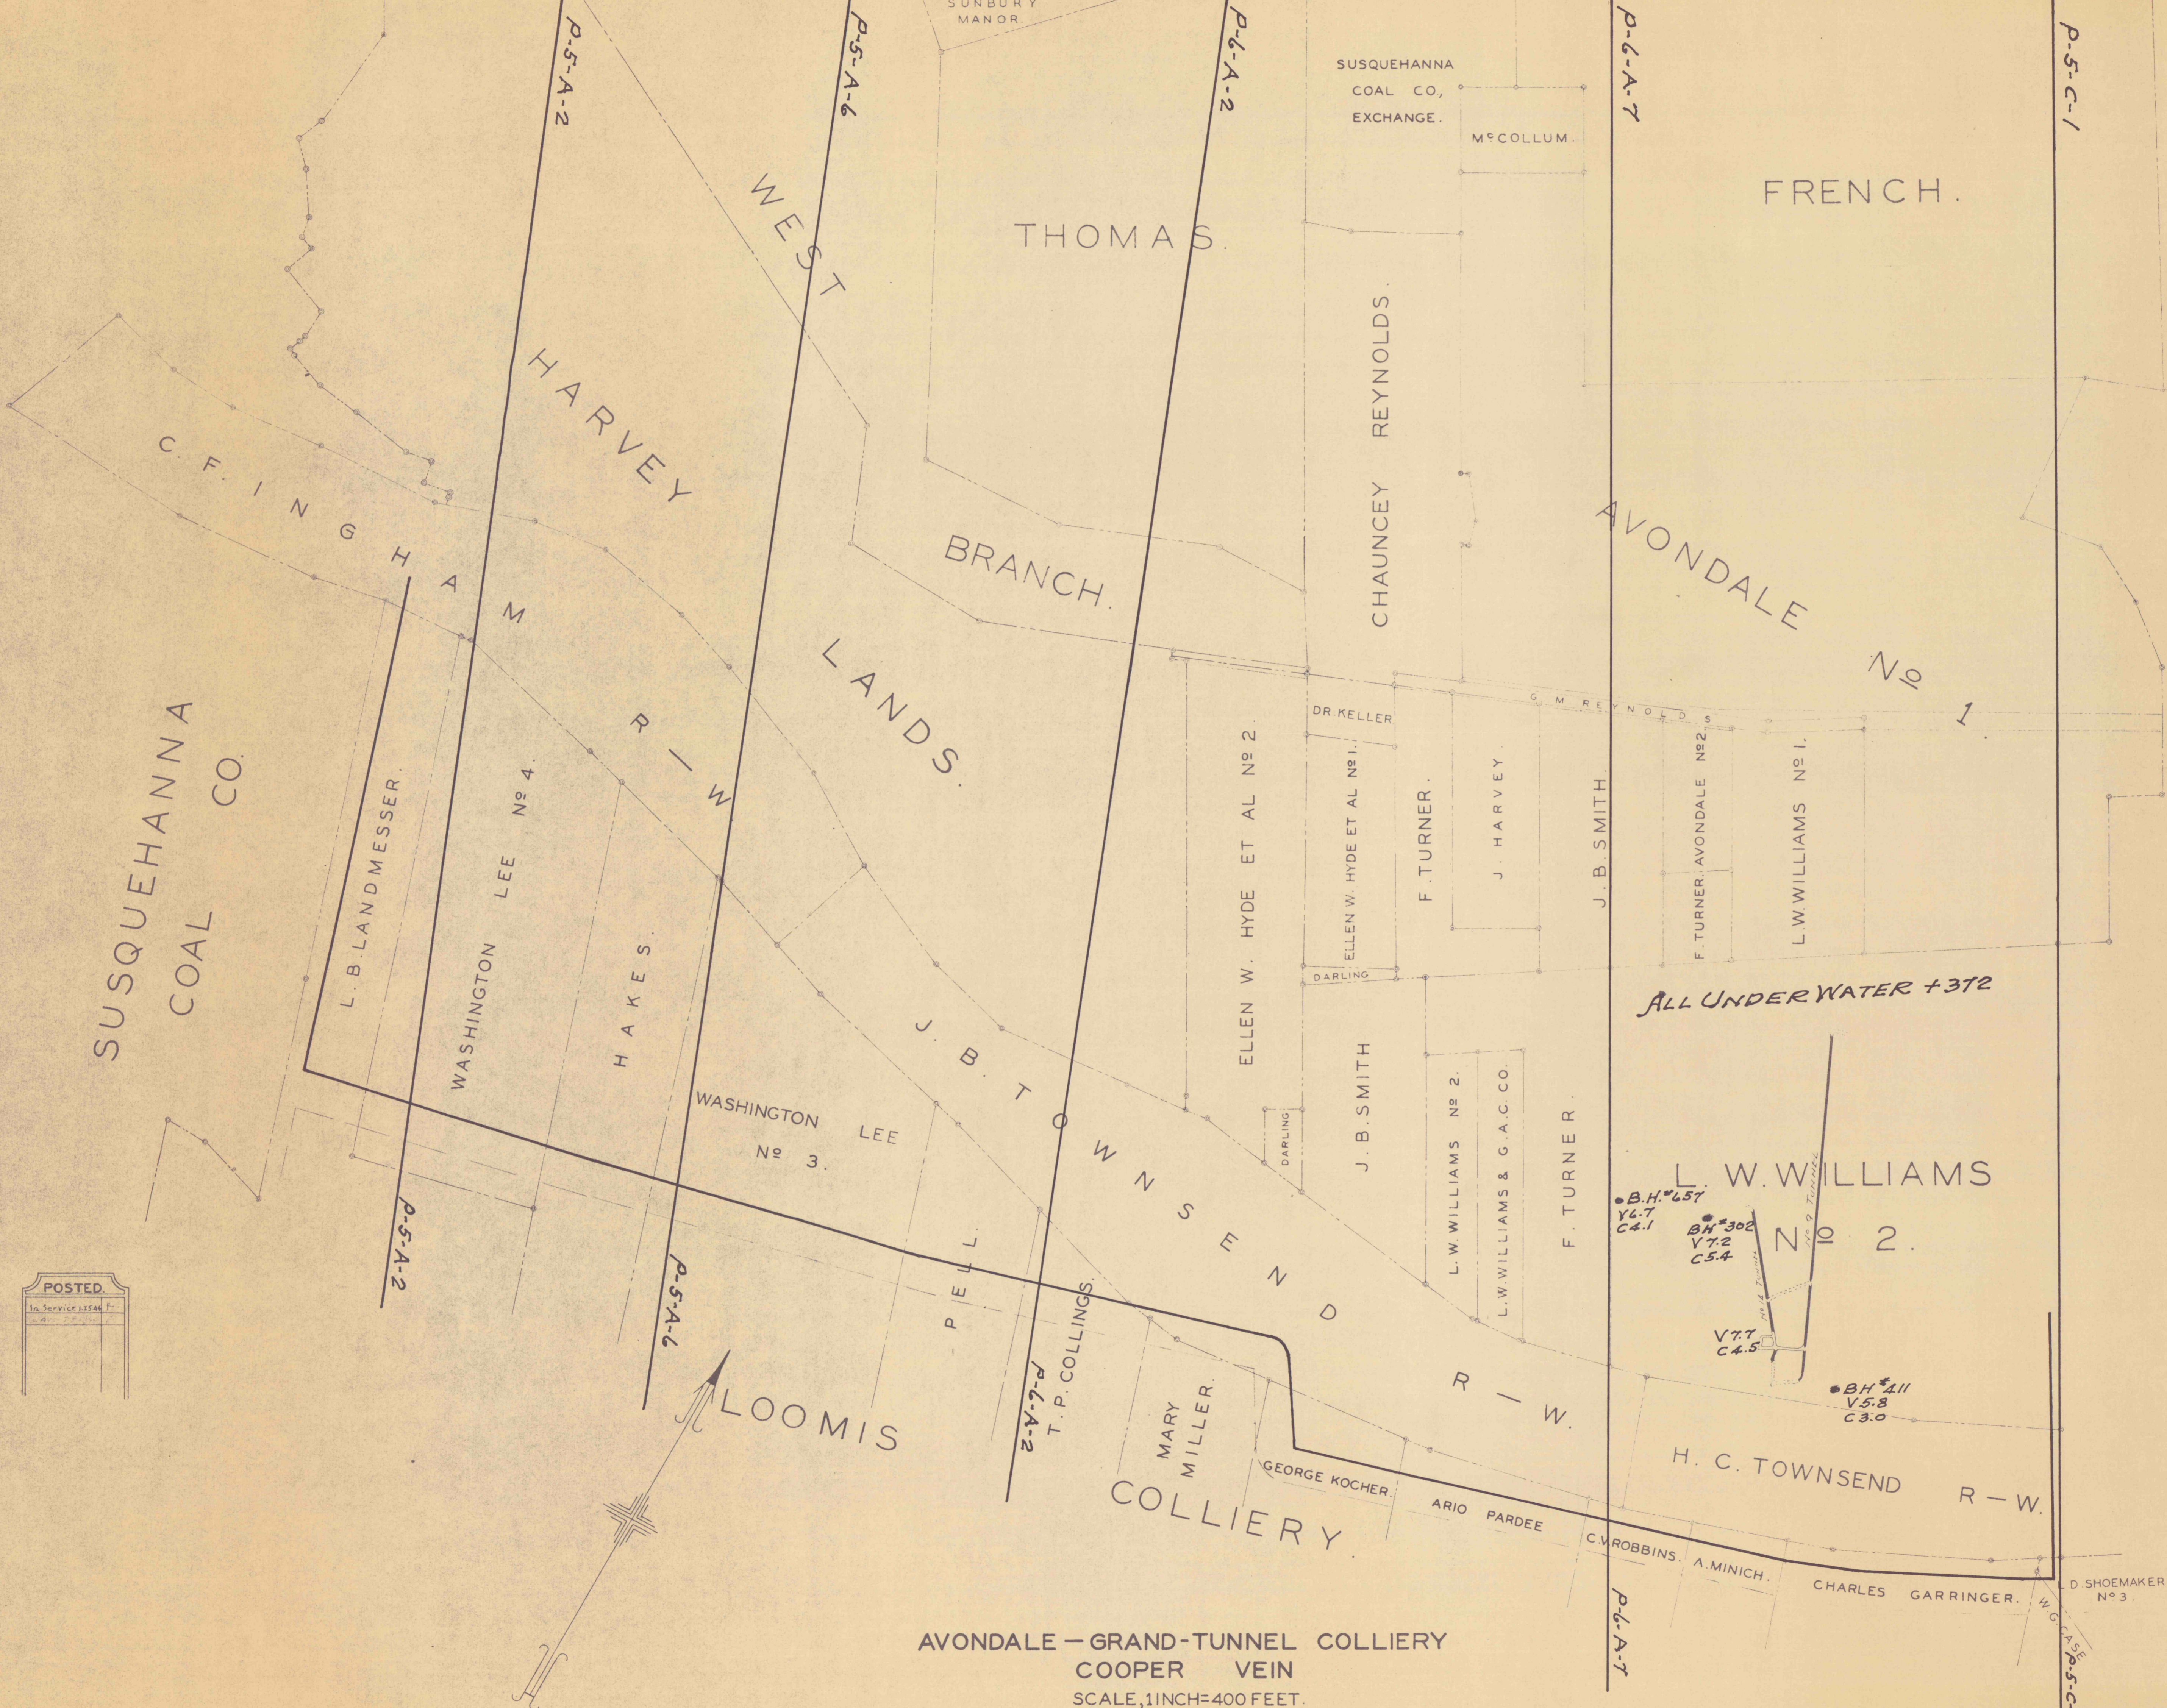

NOTTINGHAM
COLLIERY

AVONDALE - GRAND-TUNNEL COLLIERY
COOPER VEIN
SCALE, 1 INCH = 400 FEET.