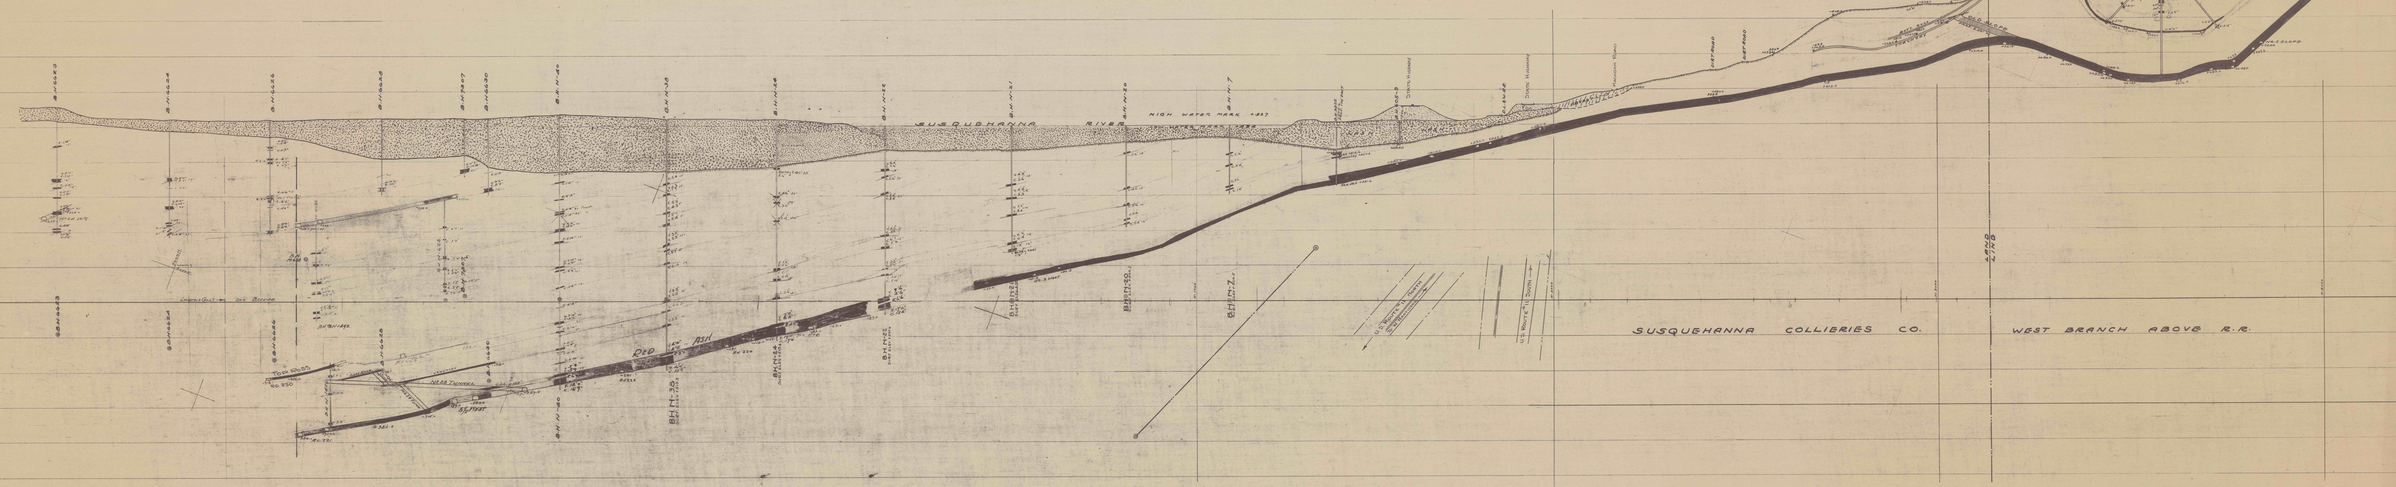SECTION LINE
"70"
P-5-A-6.