

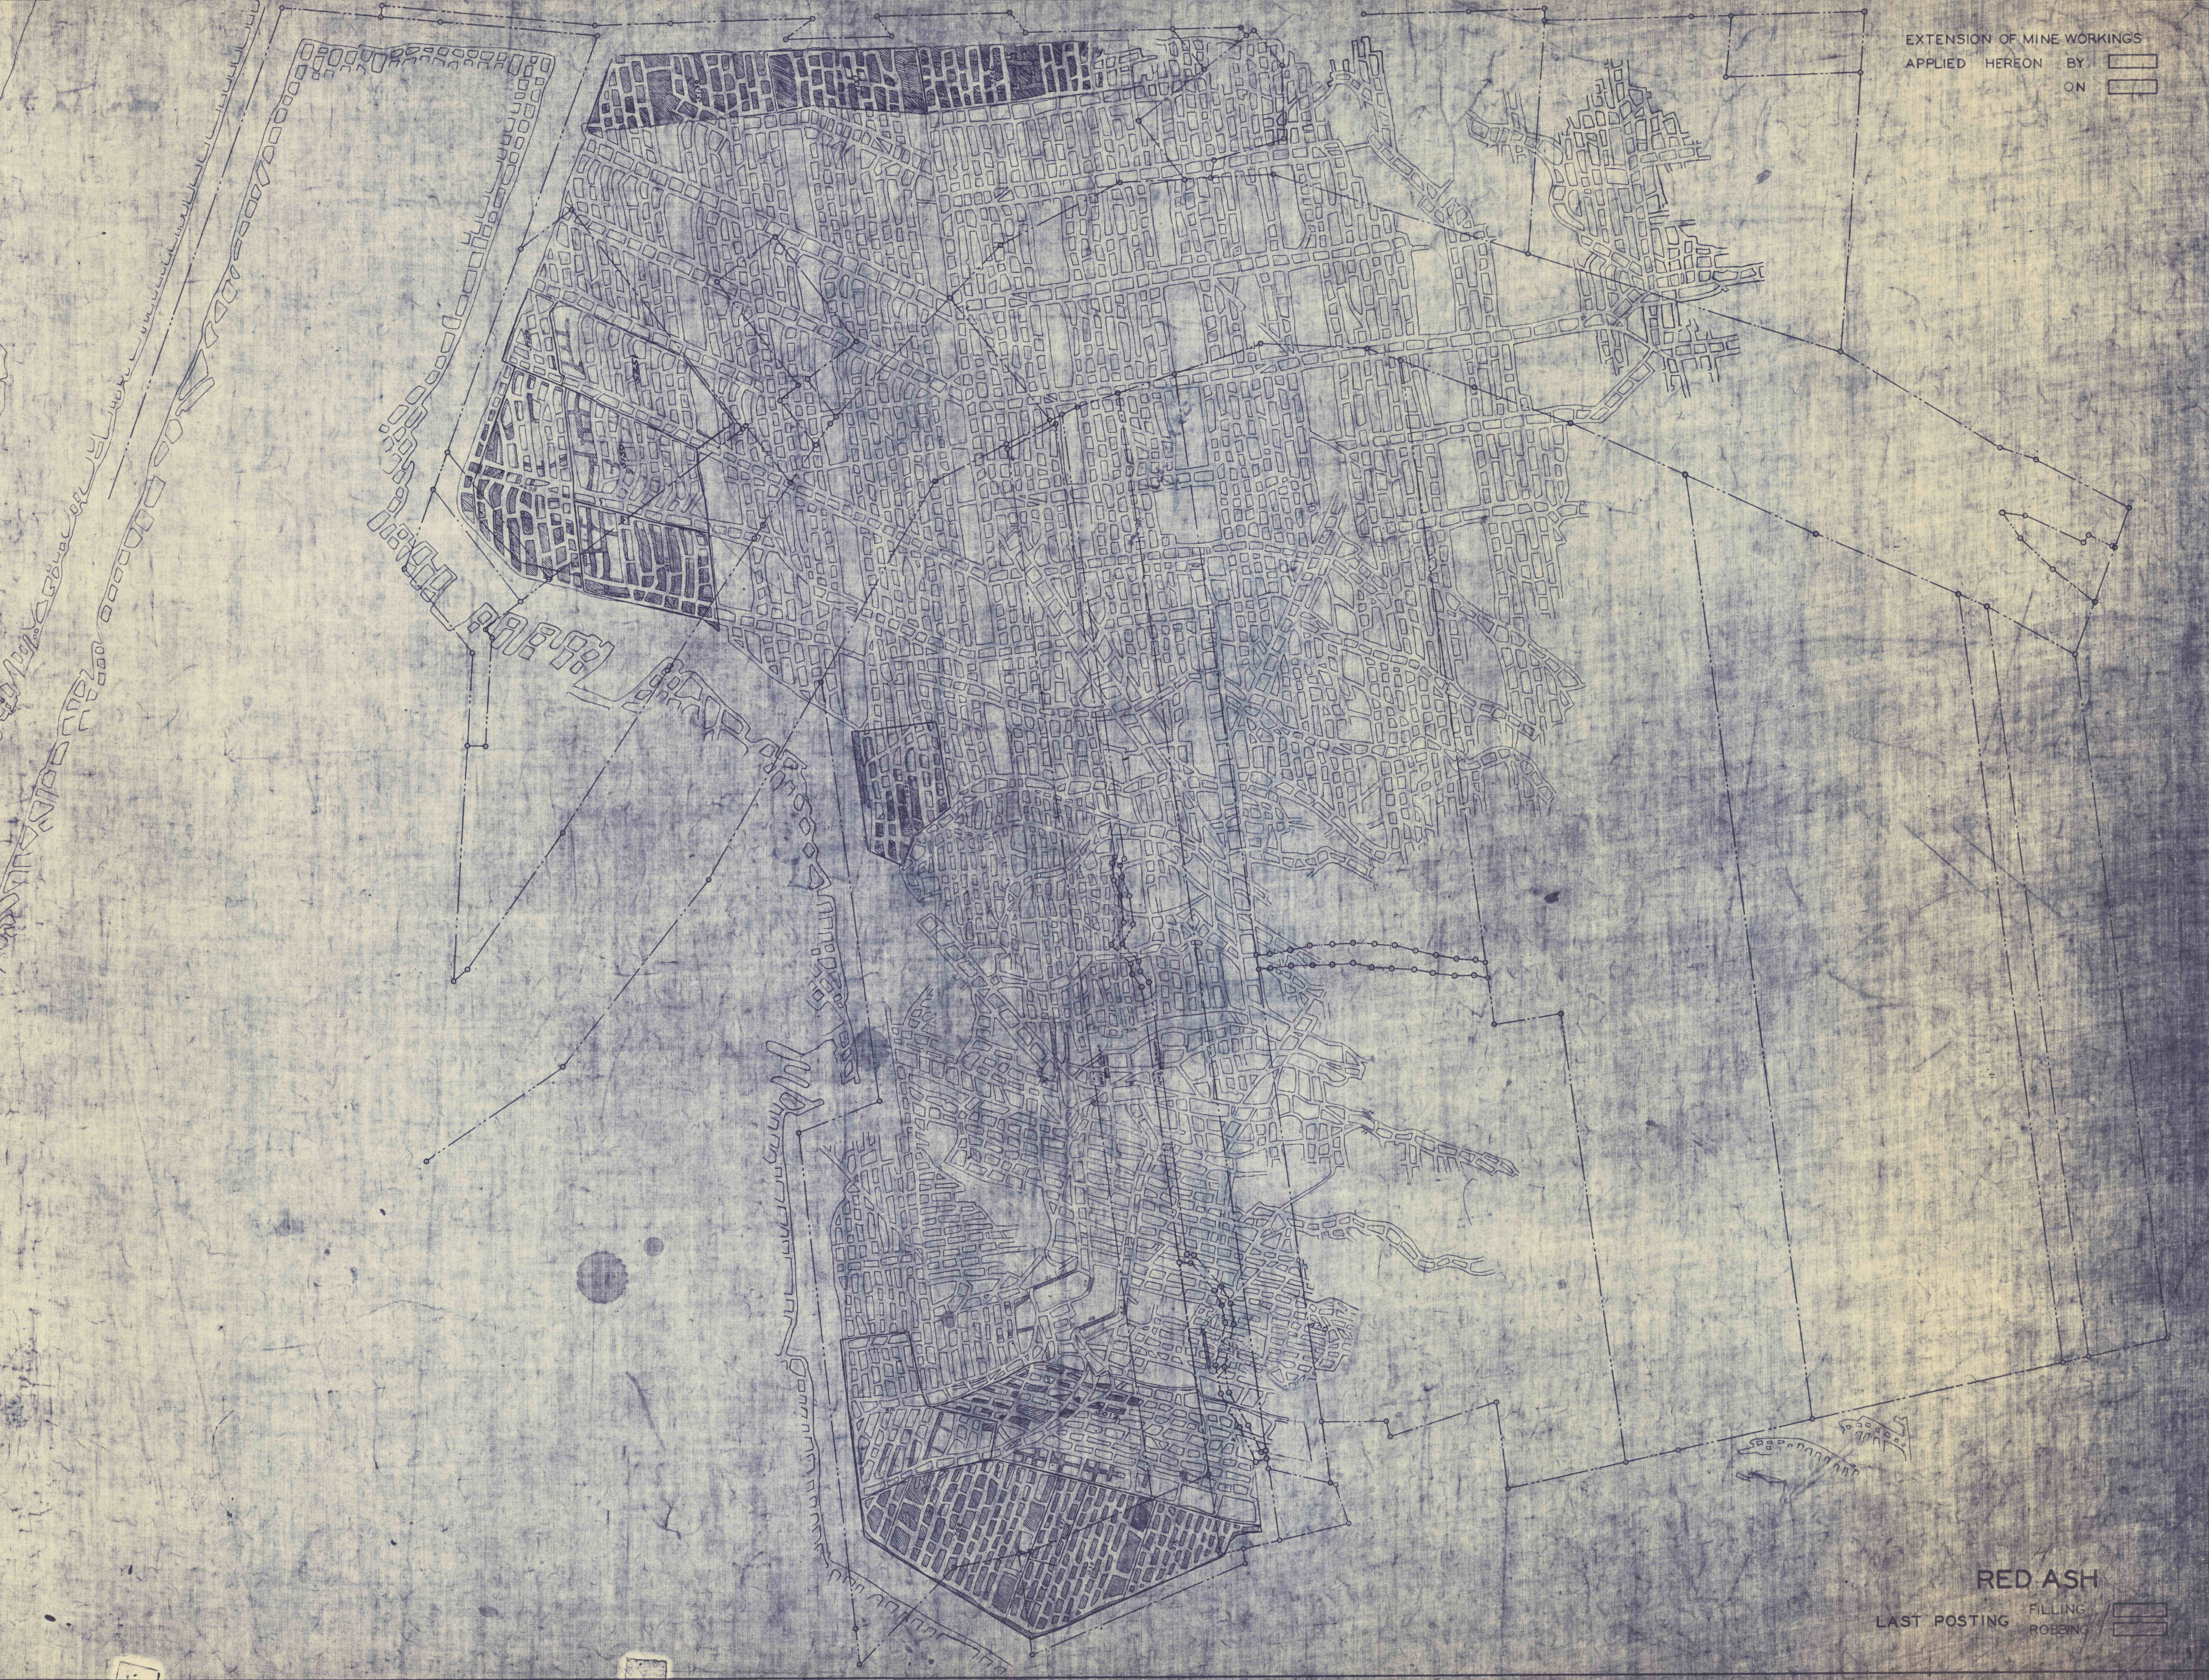


EXTENSION OF MINE WORKINGS  
APPLIED HEREON BY  BY  
ON  ON



RED ASH  
LAST POSTING  FILLING  
ROBBING  ROBBING