


EXTENSION OF MINE WORKINGS  
APPLIED HEREON BY   
ON 

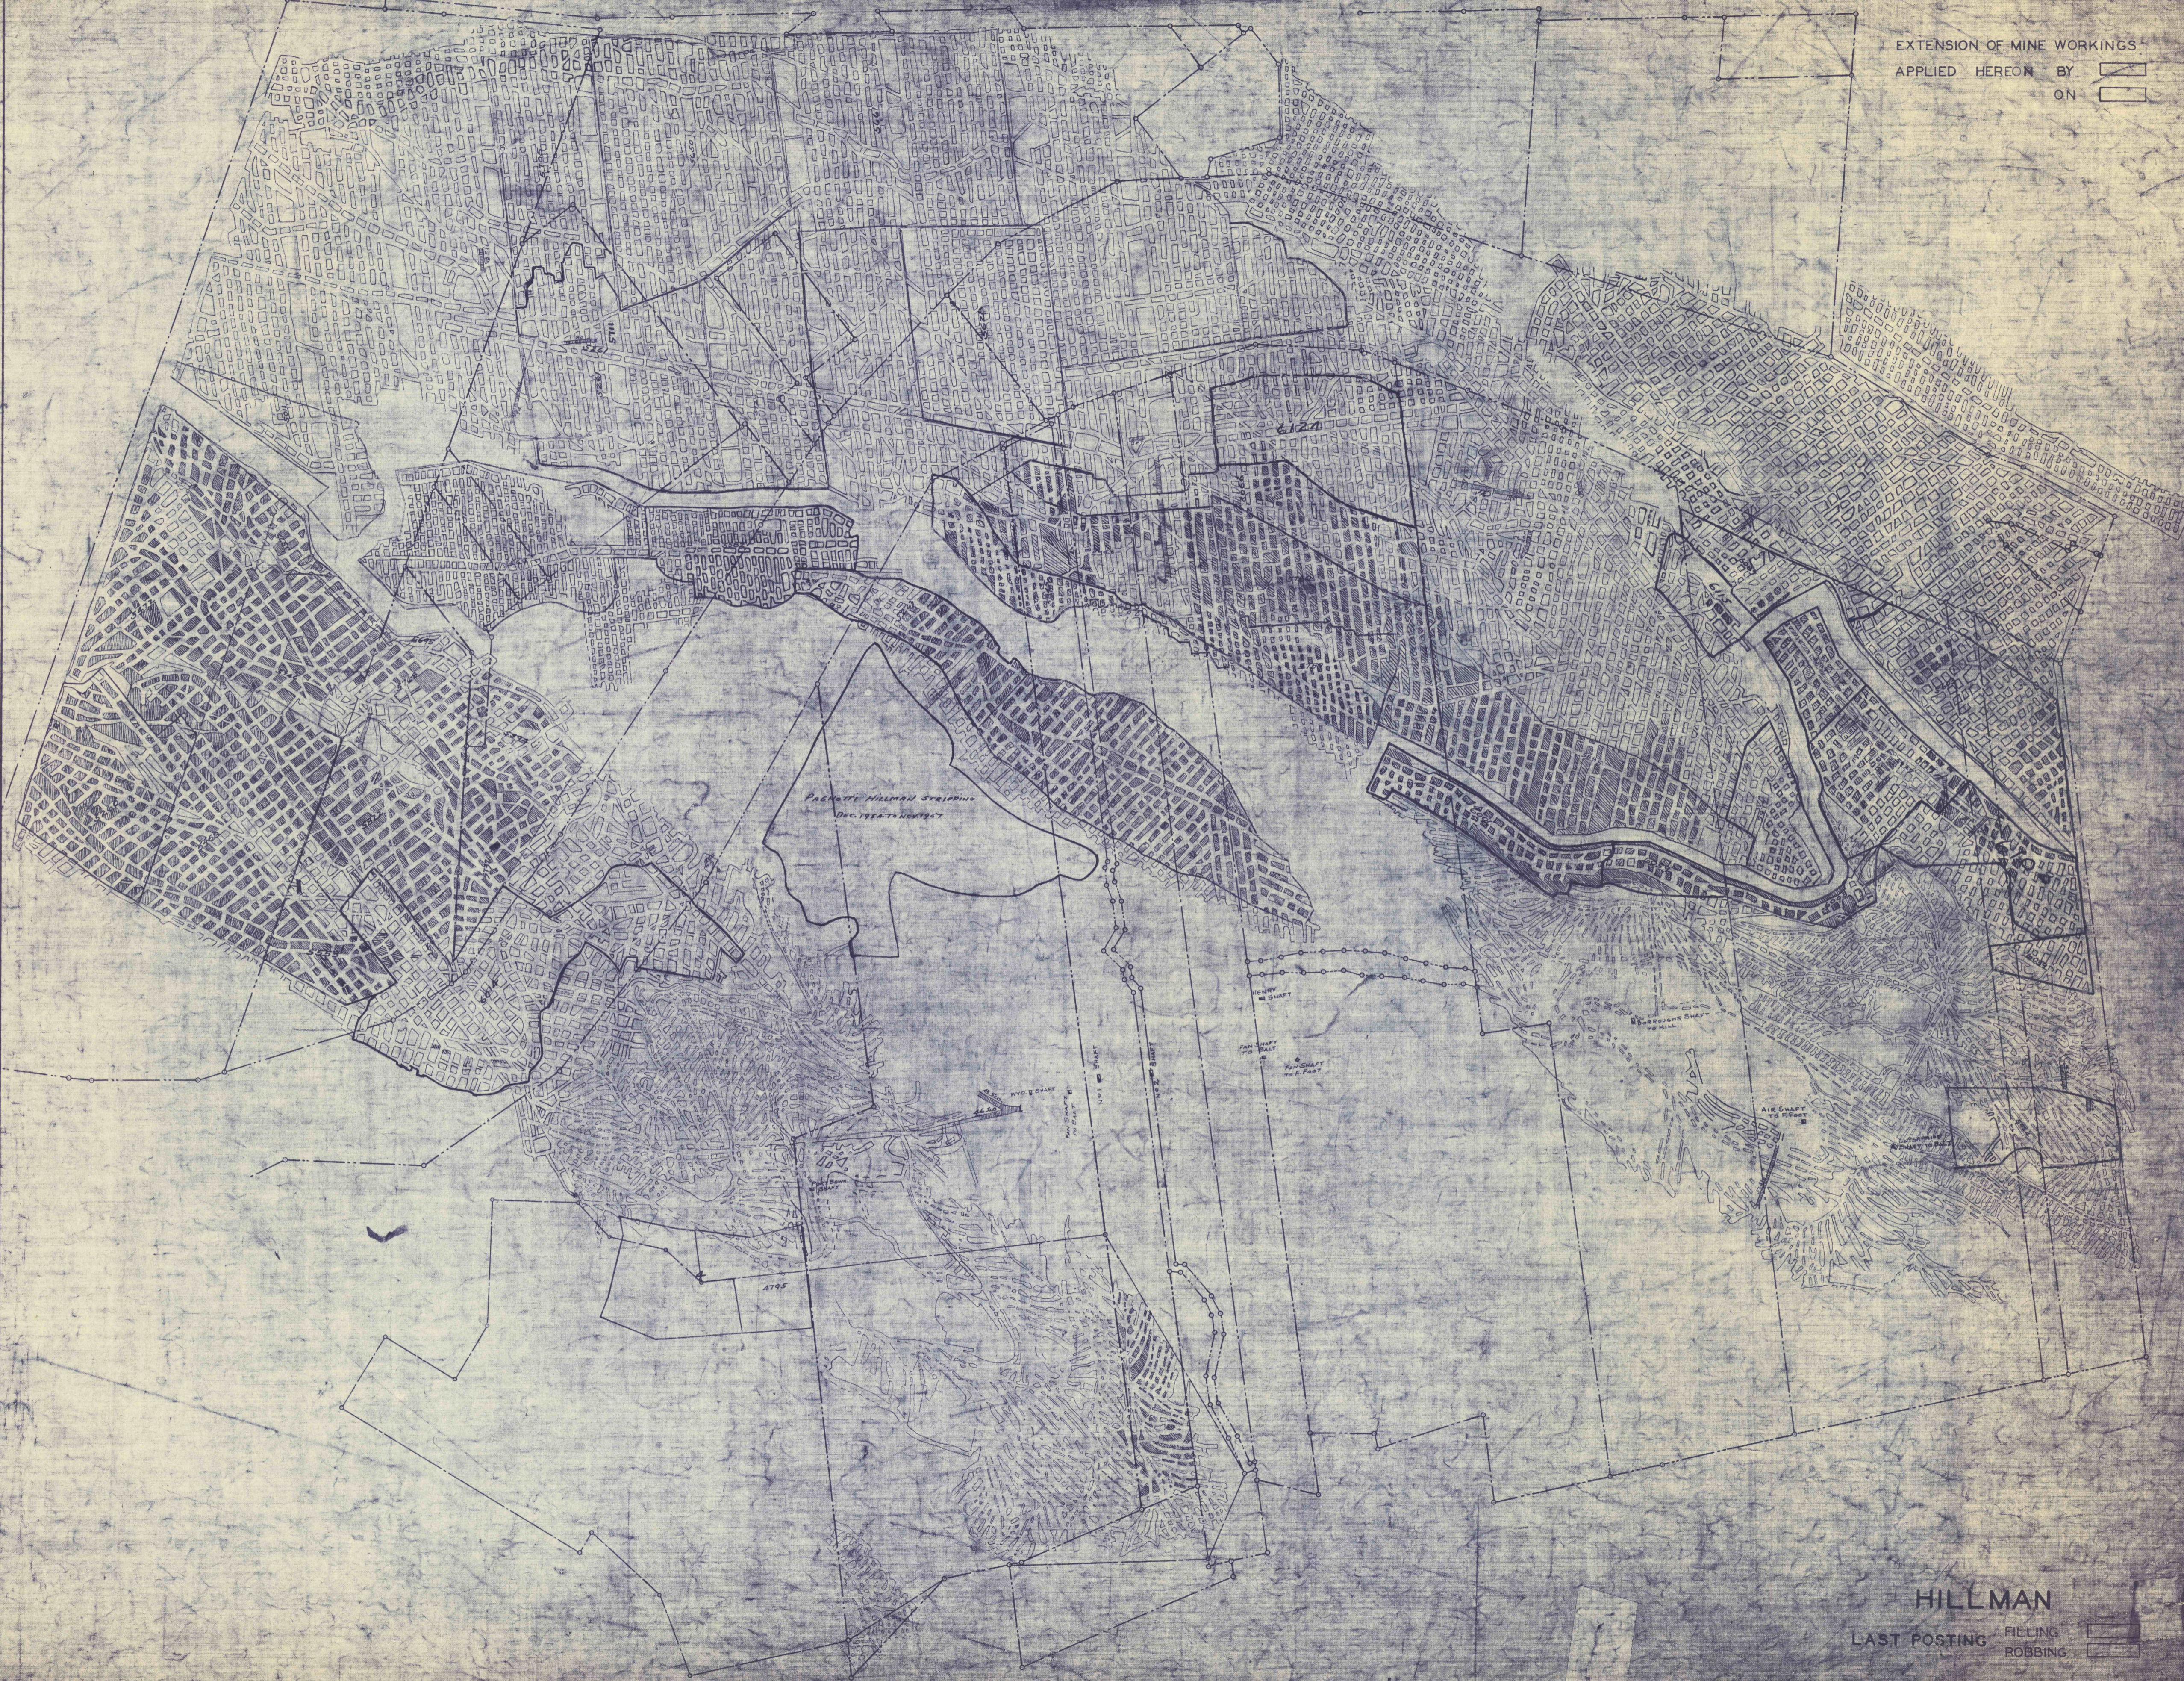

PACOTT HILLMAN SERIES  
DEC 1944 TO NOV 1947

HILLMAN

LAST POSTING FILLING  
ROBBING

