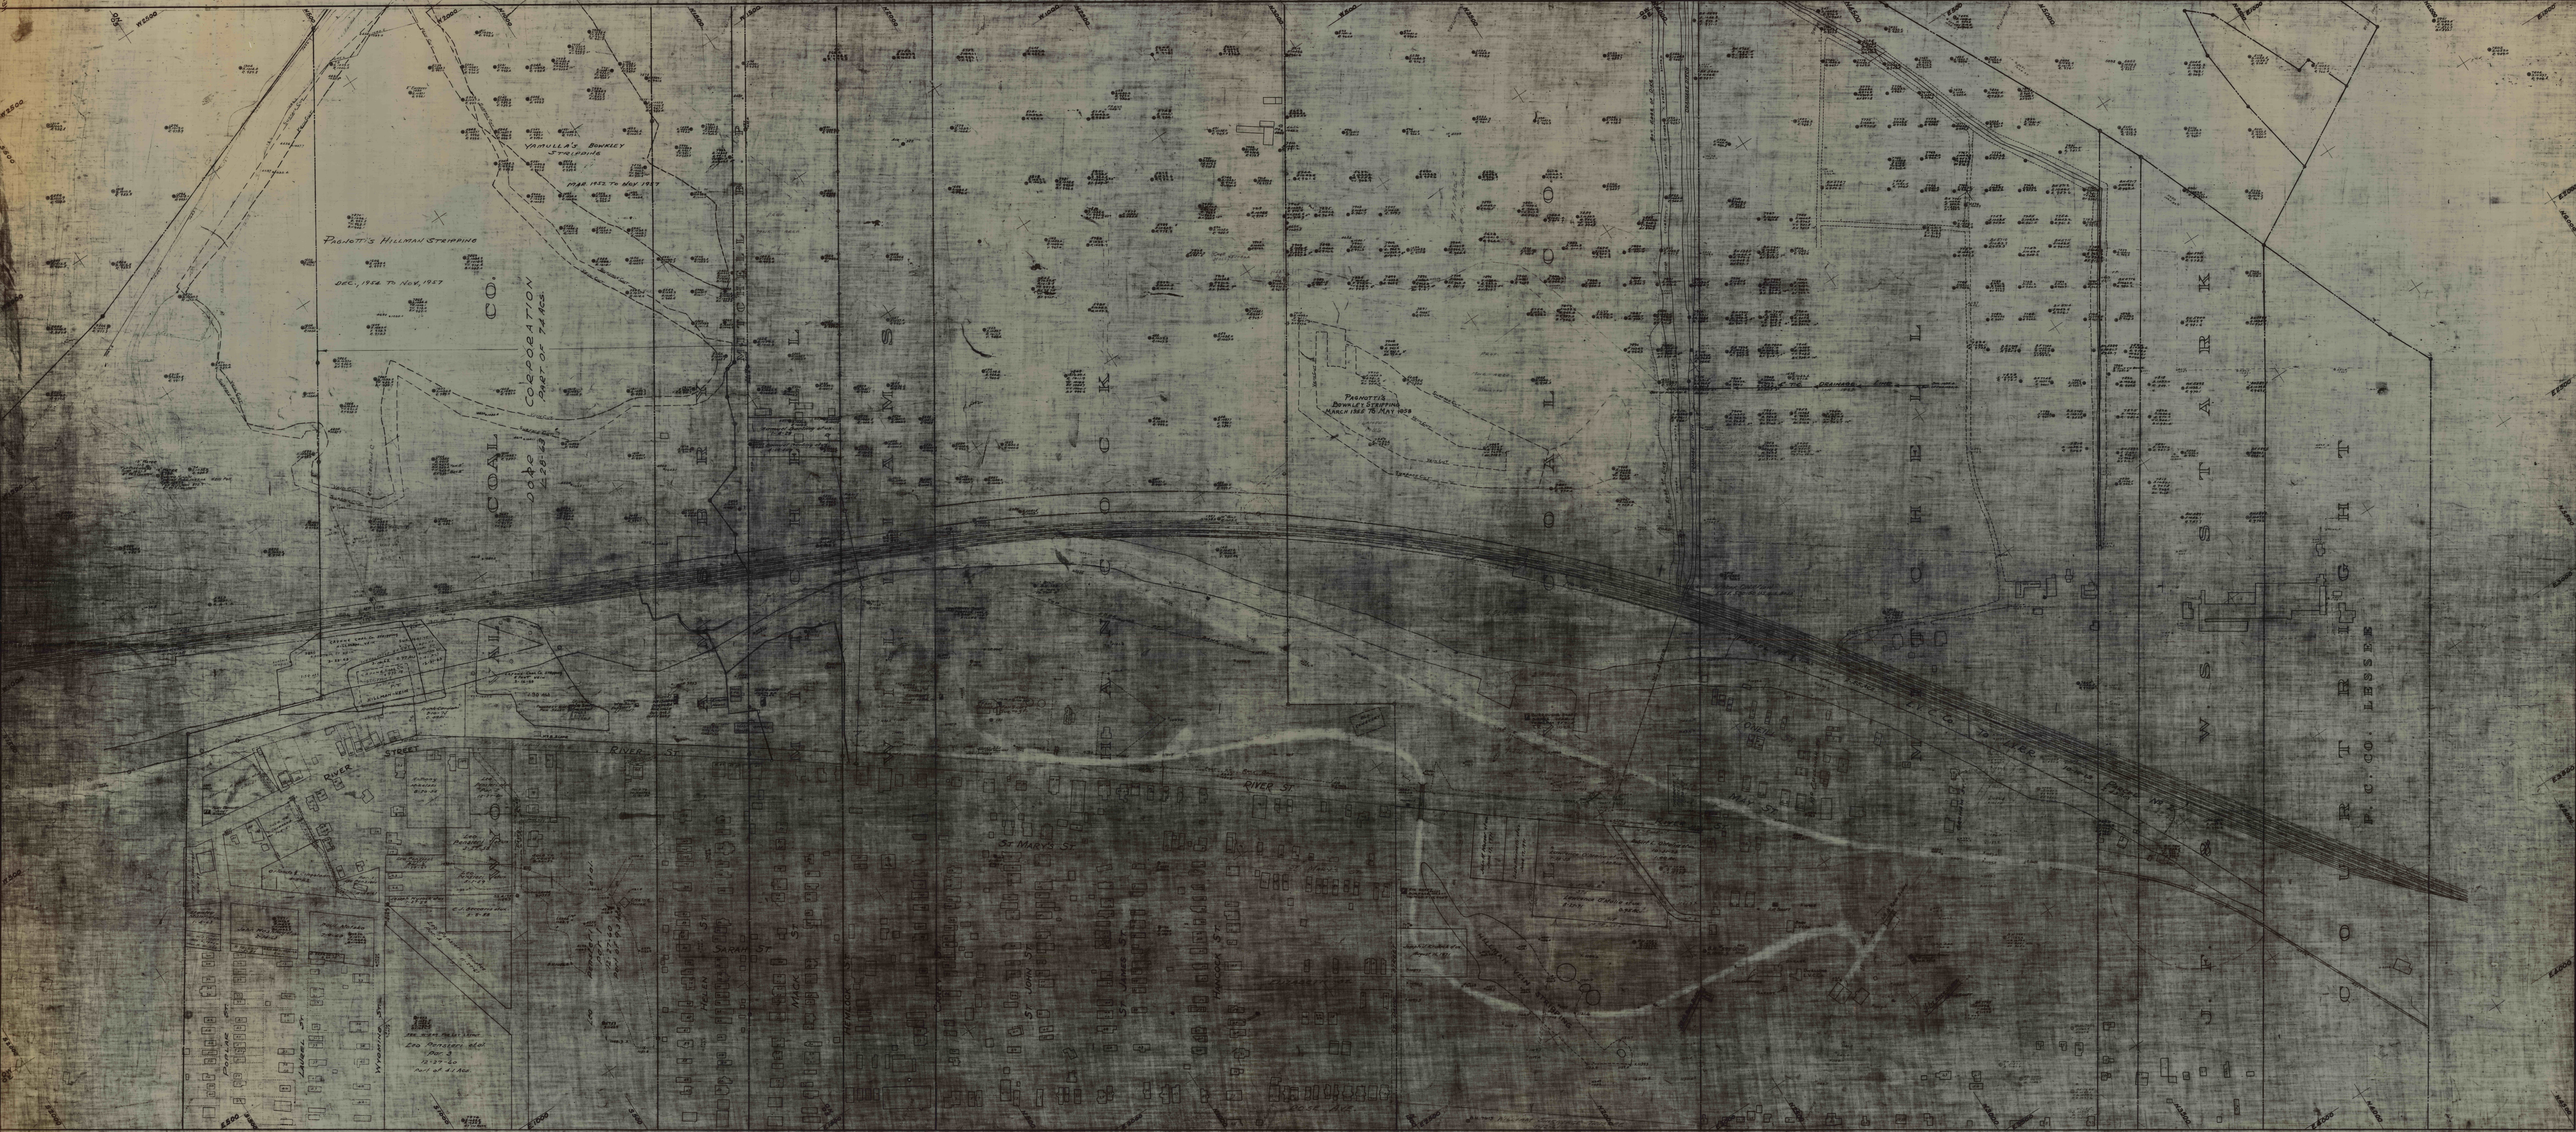
VANULLA'S BUNKLEY STRIPPING
MAR. 1927 TO NOV. 1927
PAGNOTTI'S HILLMAN STRIPPING
DEC., 1926 TO NOV. 1927
COAL CO.
CORPORATION
PART OF 74 ACS.
PAGNOTTI'S BUNKLE'S STRIPPING
MARCH 1928 TO MAY 1928
RIVER ST.
ST MARY'S ST.
ST LOUIS ST.
MAIN ST.
SARAH ST.
MACK ST.
LAUREL ST.
WASHINGTON ST.
PENNSYLVANIA R.R. CO. LESSEE