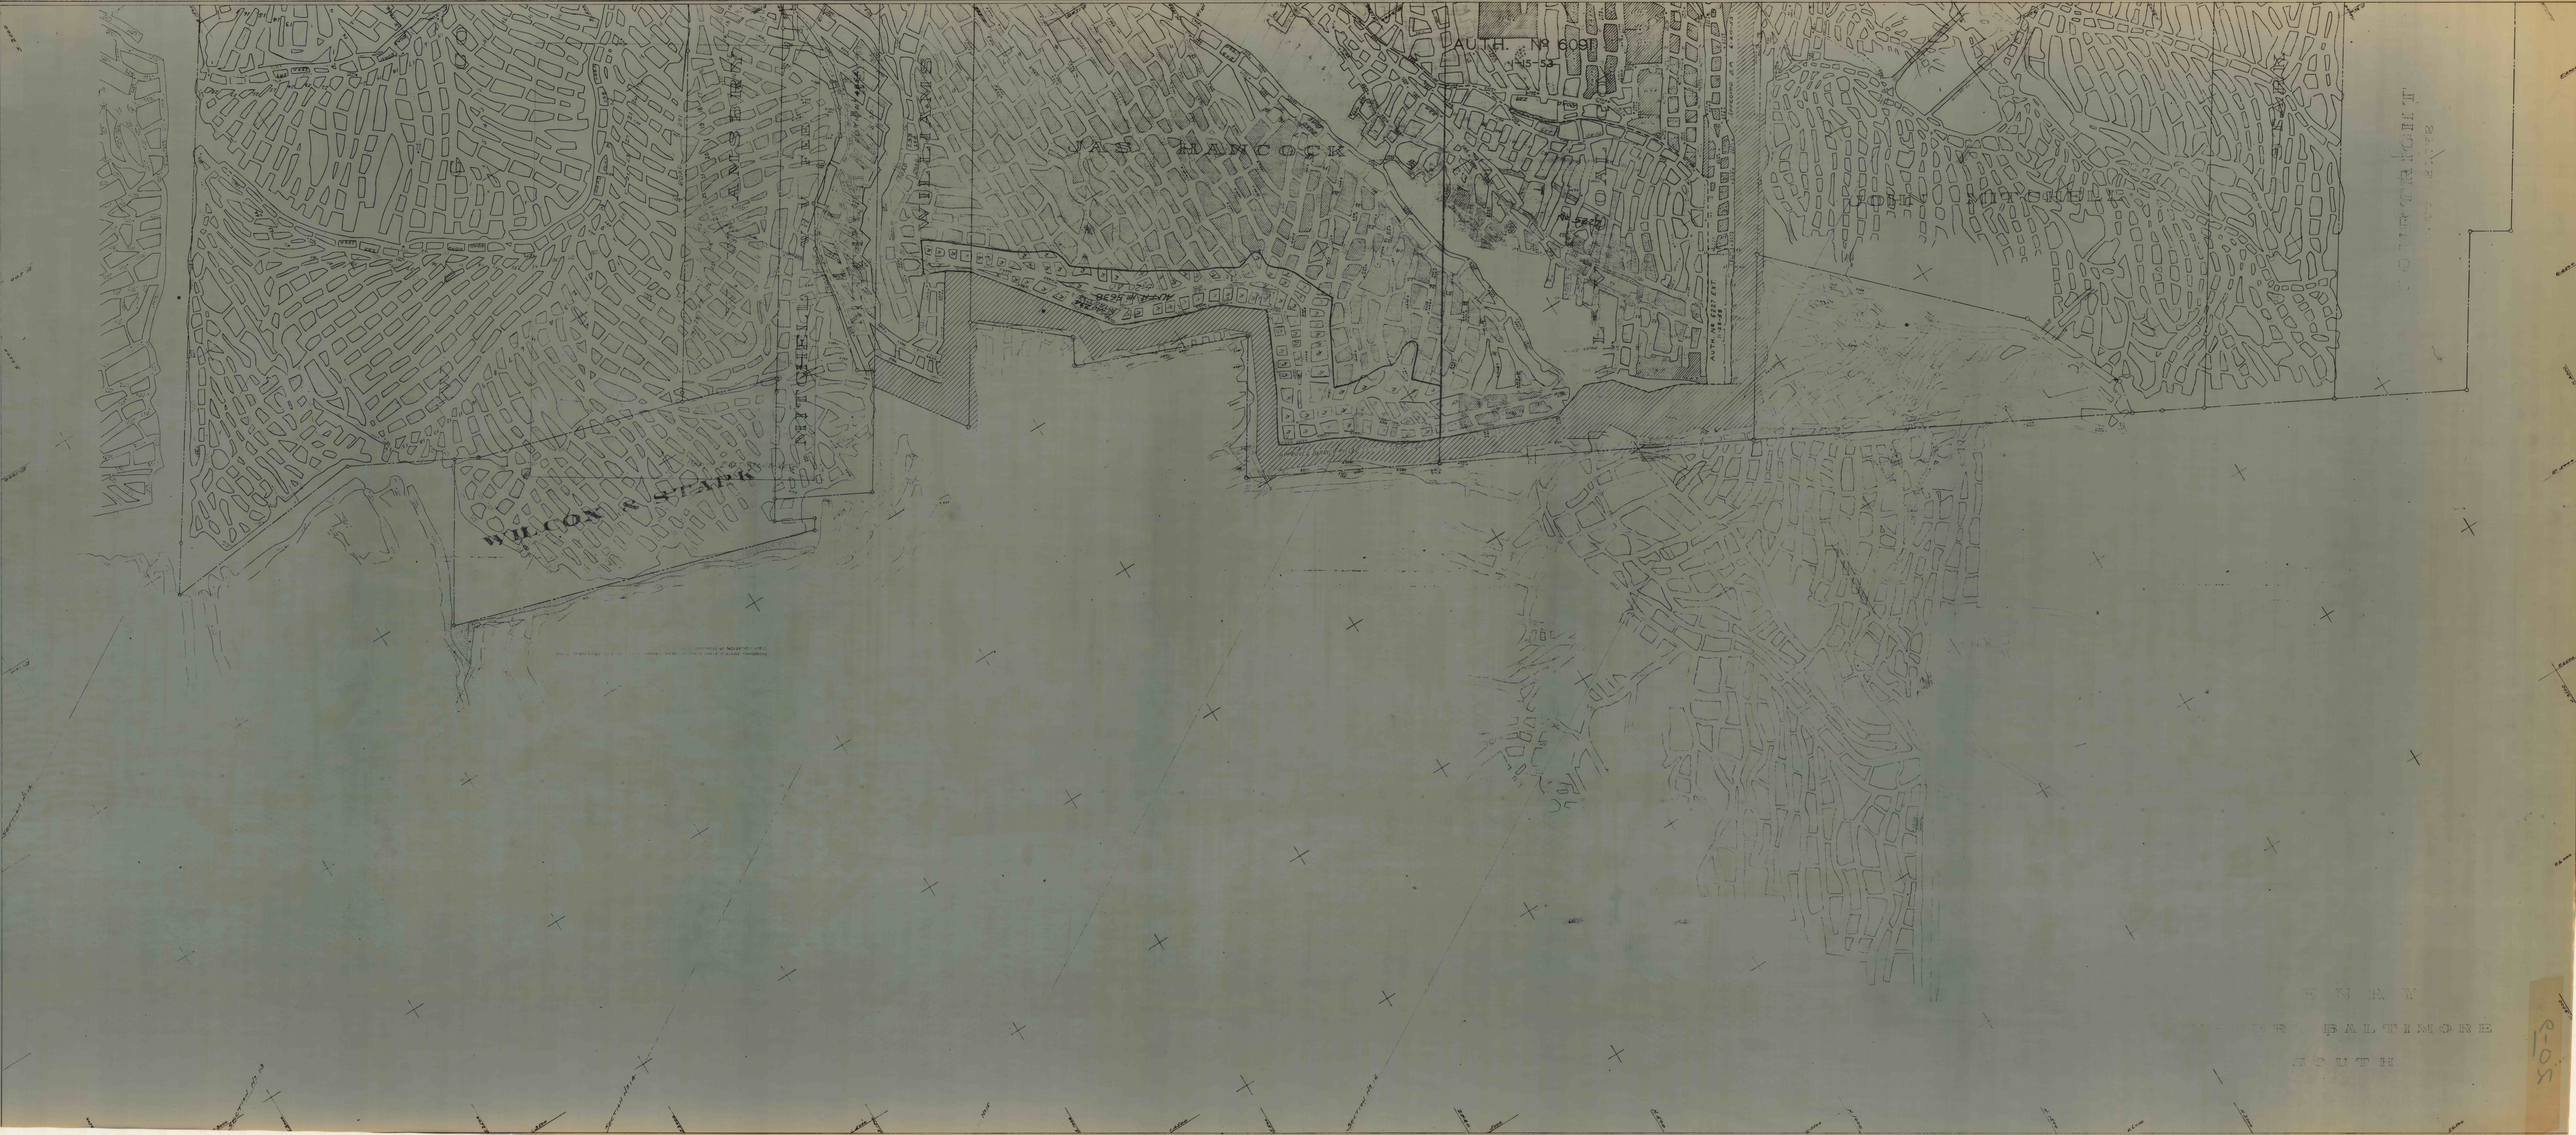
AUTH. Nº 6091
JAS. HANCOCK
WILCON & STARK
BALTIMORE
SOUTH