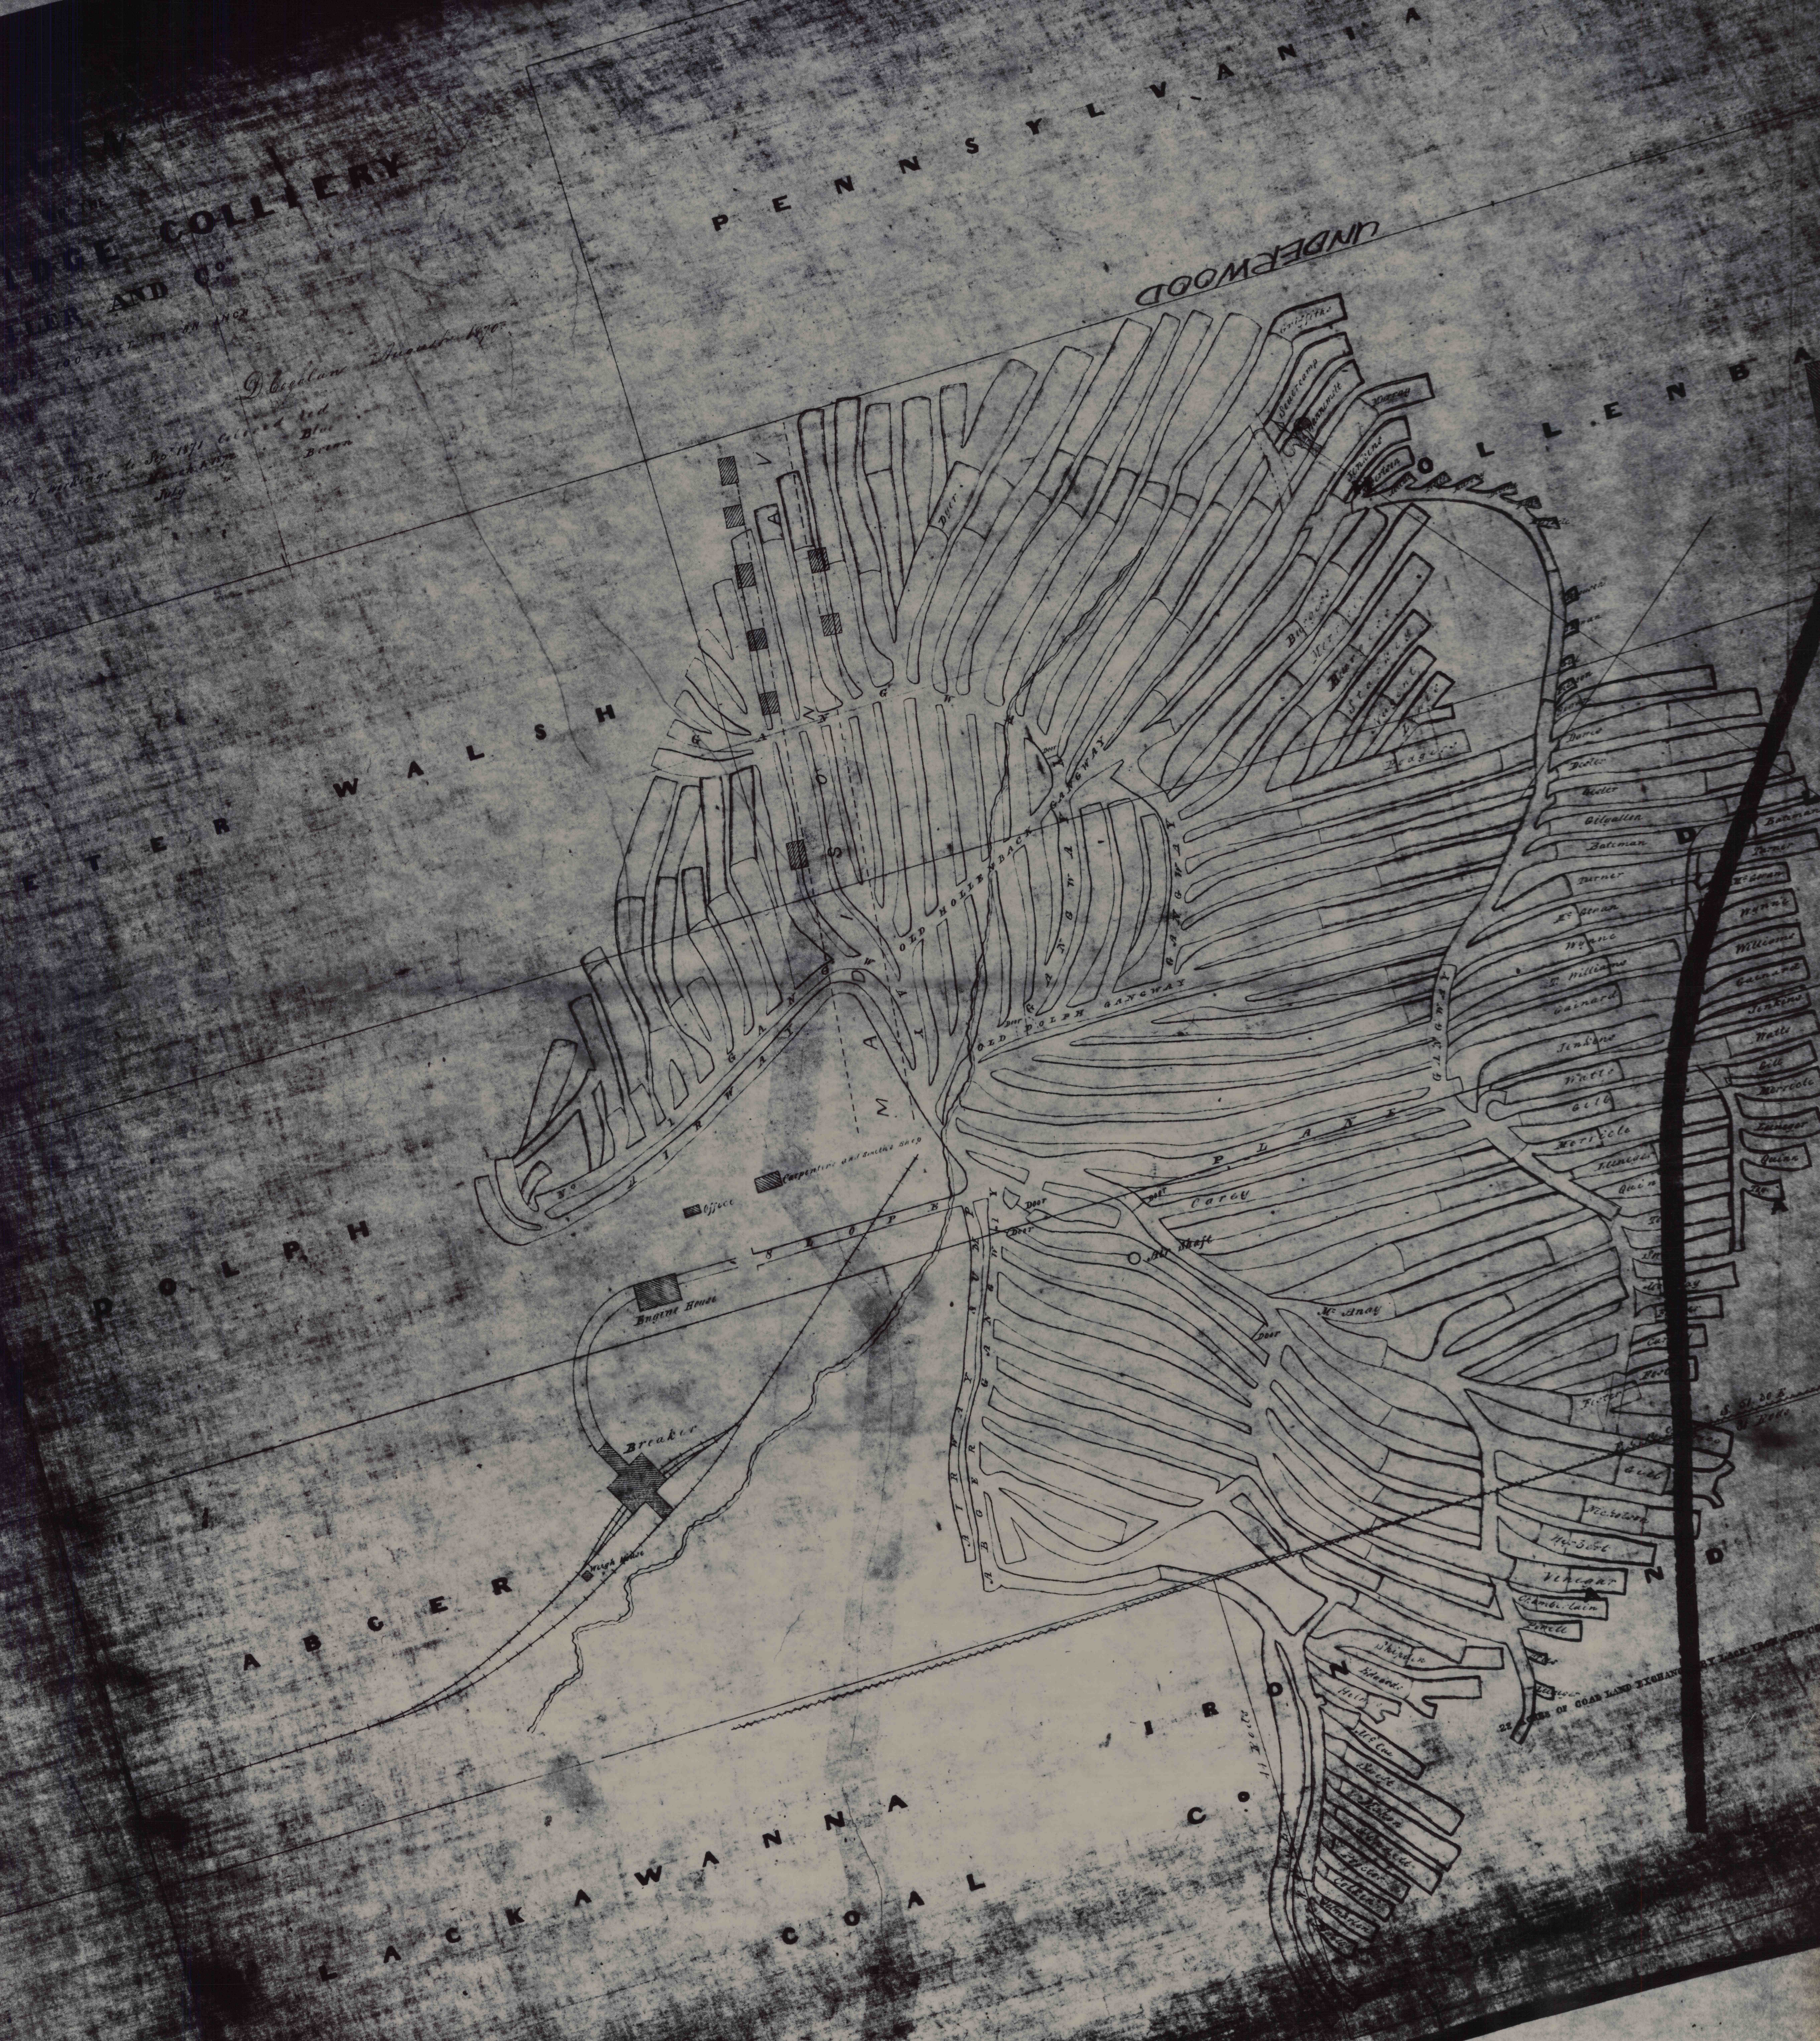
IDGE COLLIERY
LER AND Co.
100 FEET TO AN INCH
D. Coghlan August 1870
of workings to Sep 1871 Colored Red
Blue
Brown
July
PENNSYLVANIA
UNDERWOOD
OLLENBA
ETER WALSH
DOLPH
ABGER
LACKAWANNA COAL Co.
IRON
AND
OLD HOLLENBACK GANGWAY
OLD DOLPH GANGWAY
AIRWAY
GANGWAY
PLANE
SLOPE
Engine House
Breaker
Weigh House
Office
Carpenters and Smiths Shop
Air Shaft
Door
Carey
Mc Anay
Griffiths
Murray
Jenkins
Dane
Deeter
Gilgallen
Bateman
Turner
Wynne
T. Williams
Williams
Gainard
Jenkins
Watts
Gill
Merricle
Quinn
Nicholson
Herbert
Vinegar
Chamberlain
Edwards
Mc Cue
Scott
S. 51 30 E
31 Rods
22 ACRES OF COAL LAND EXCHANGED BY LACK IRON AND C