


MAP APPROVED
WORKINGS
GREEN RIDGE
COAL CO.
H. D. WILSON

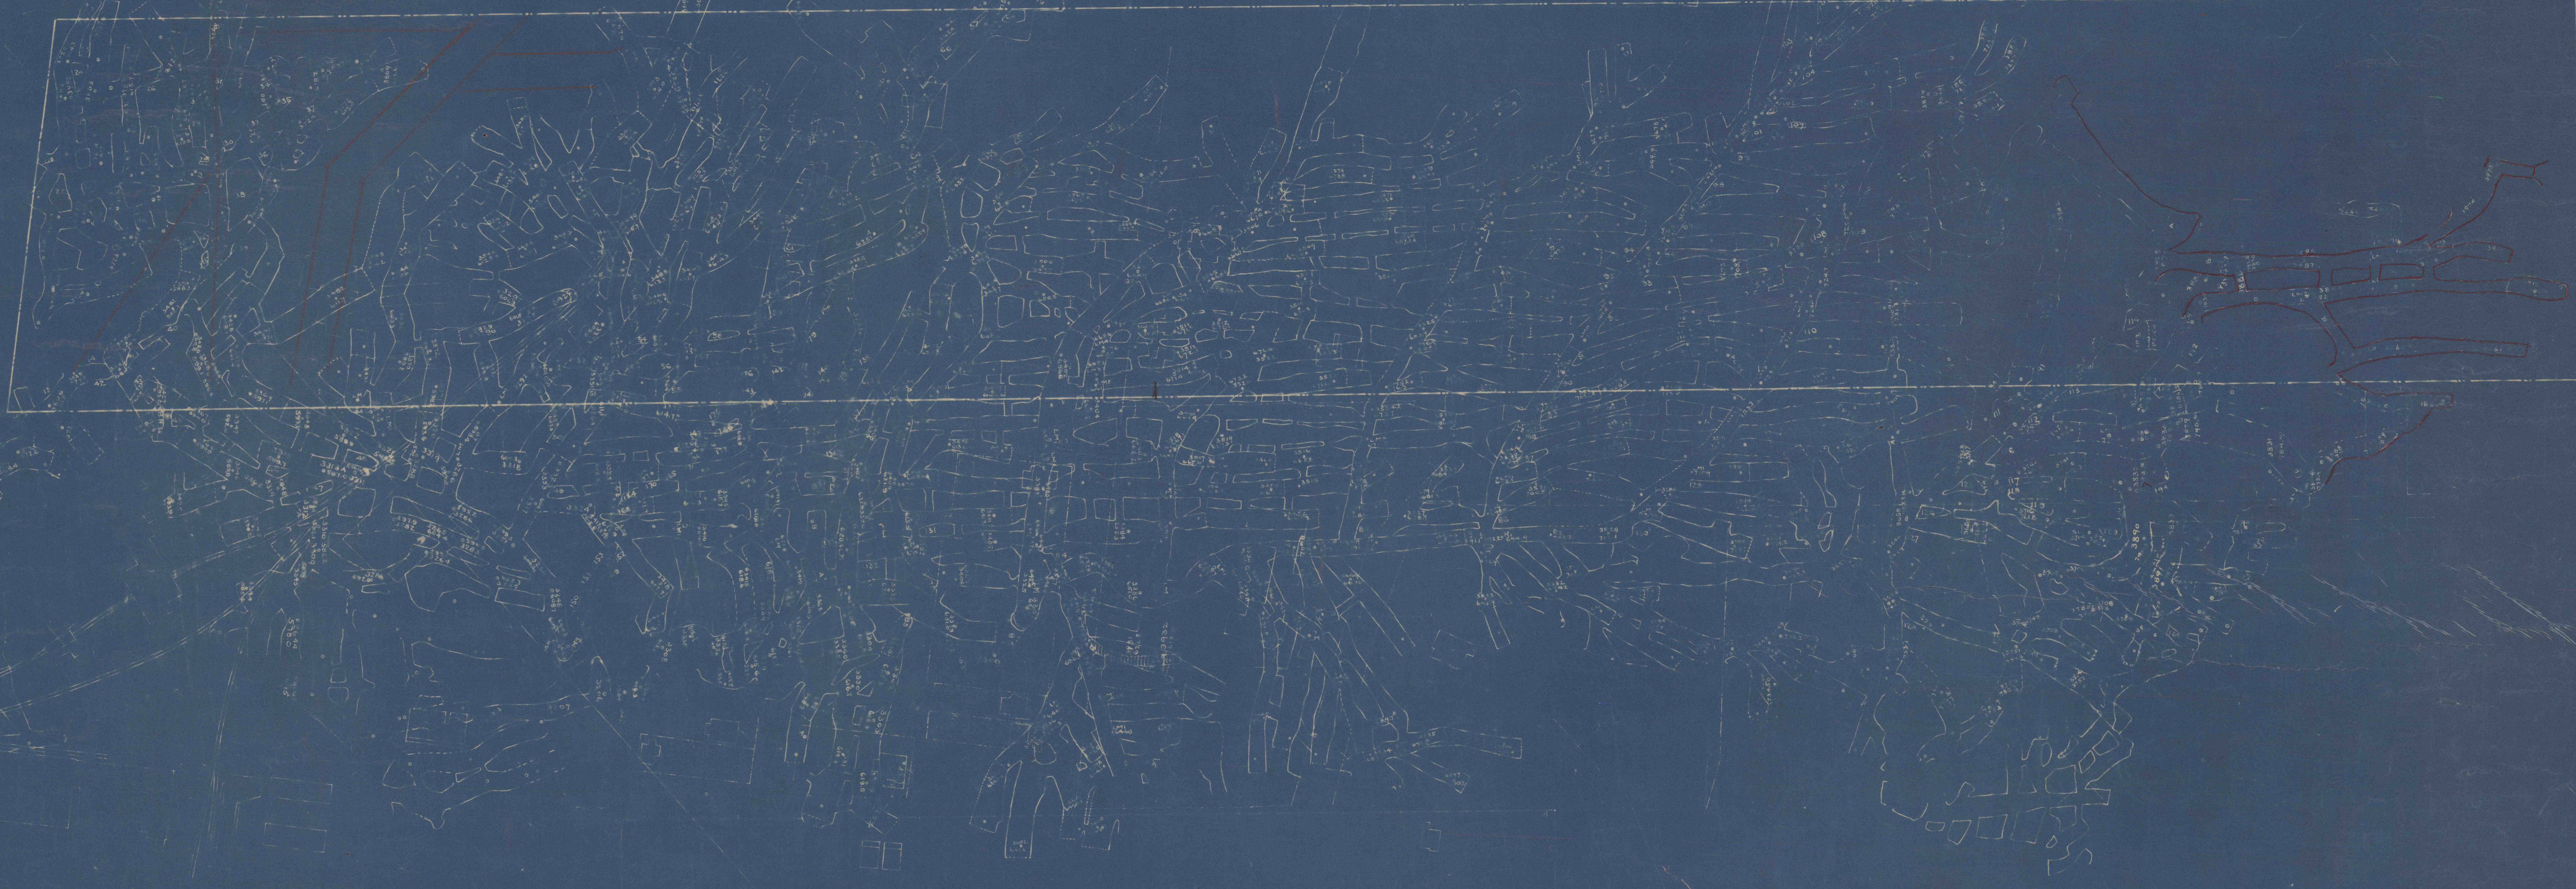

Map
showing
Green Ridge Coal Co's