


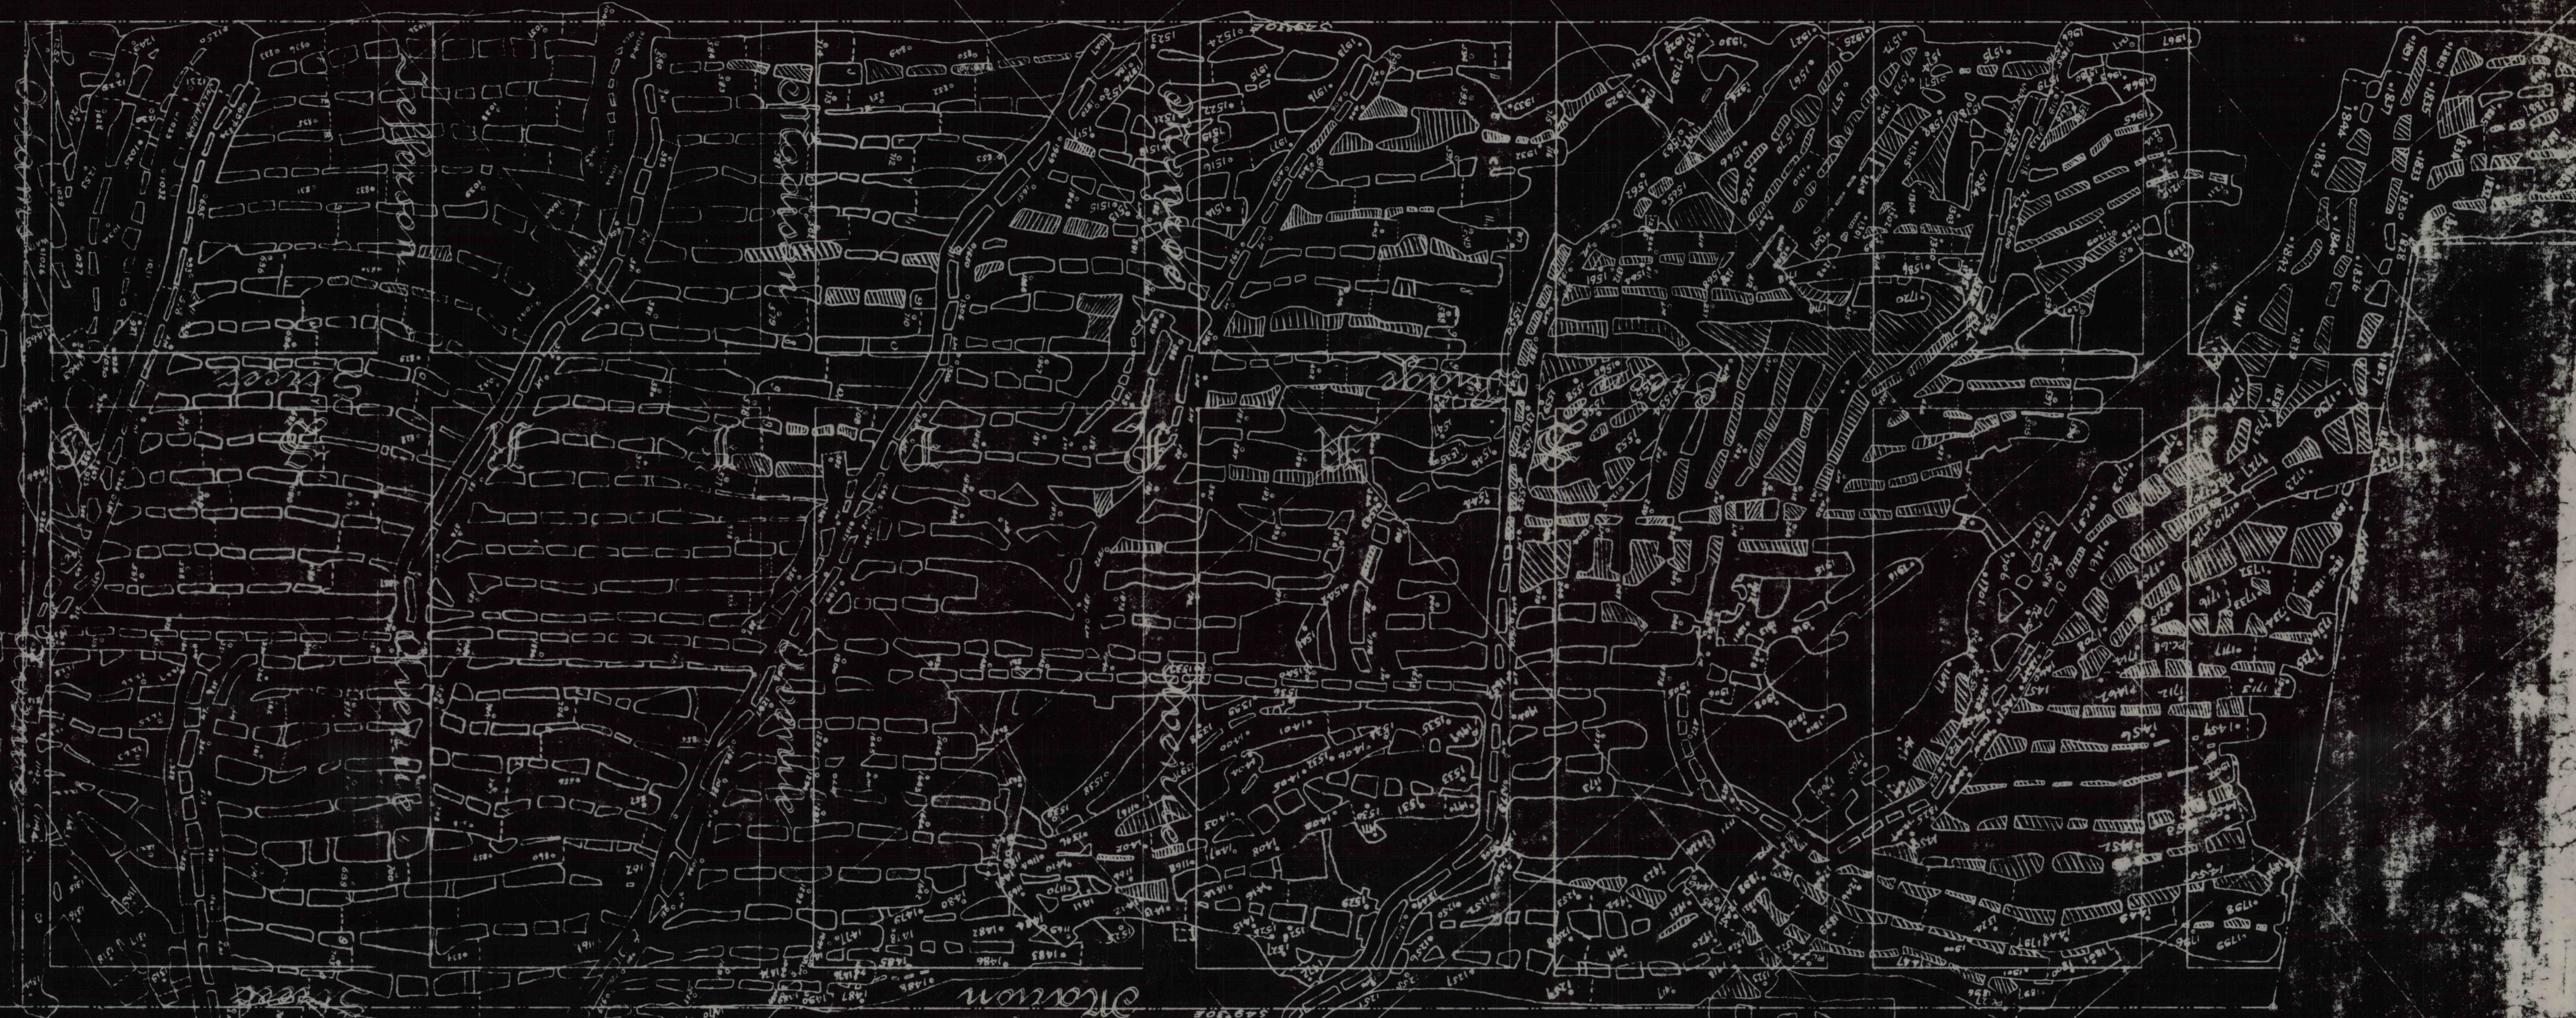

Wilmington

Adams

Oranston



22




