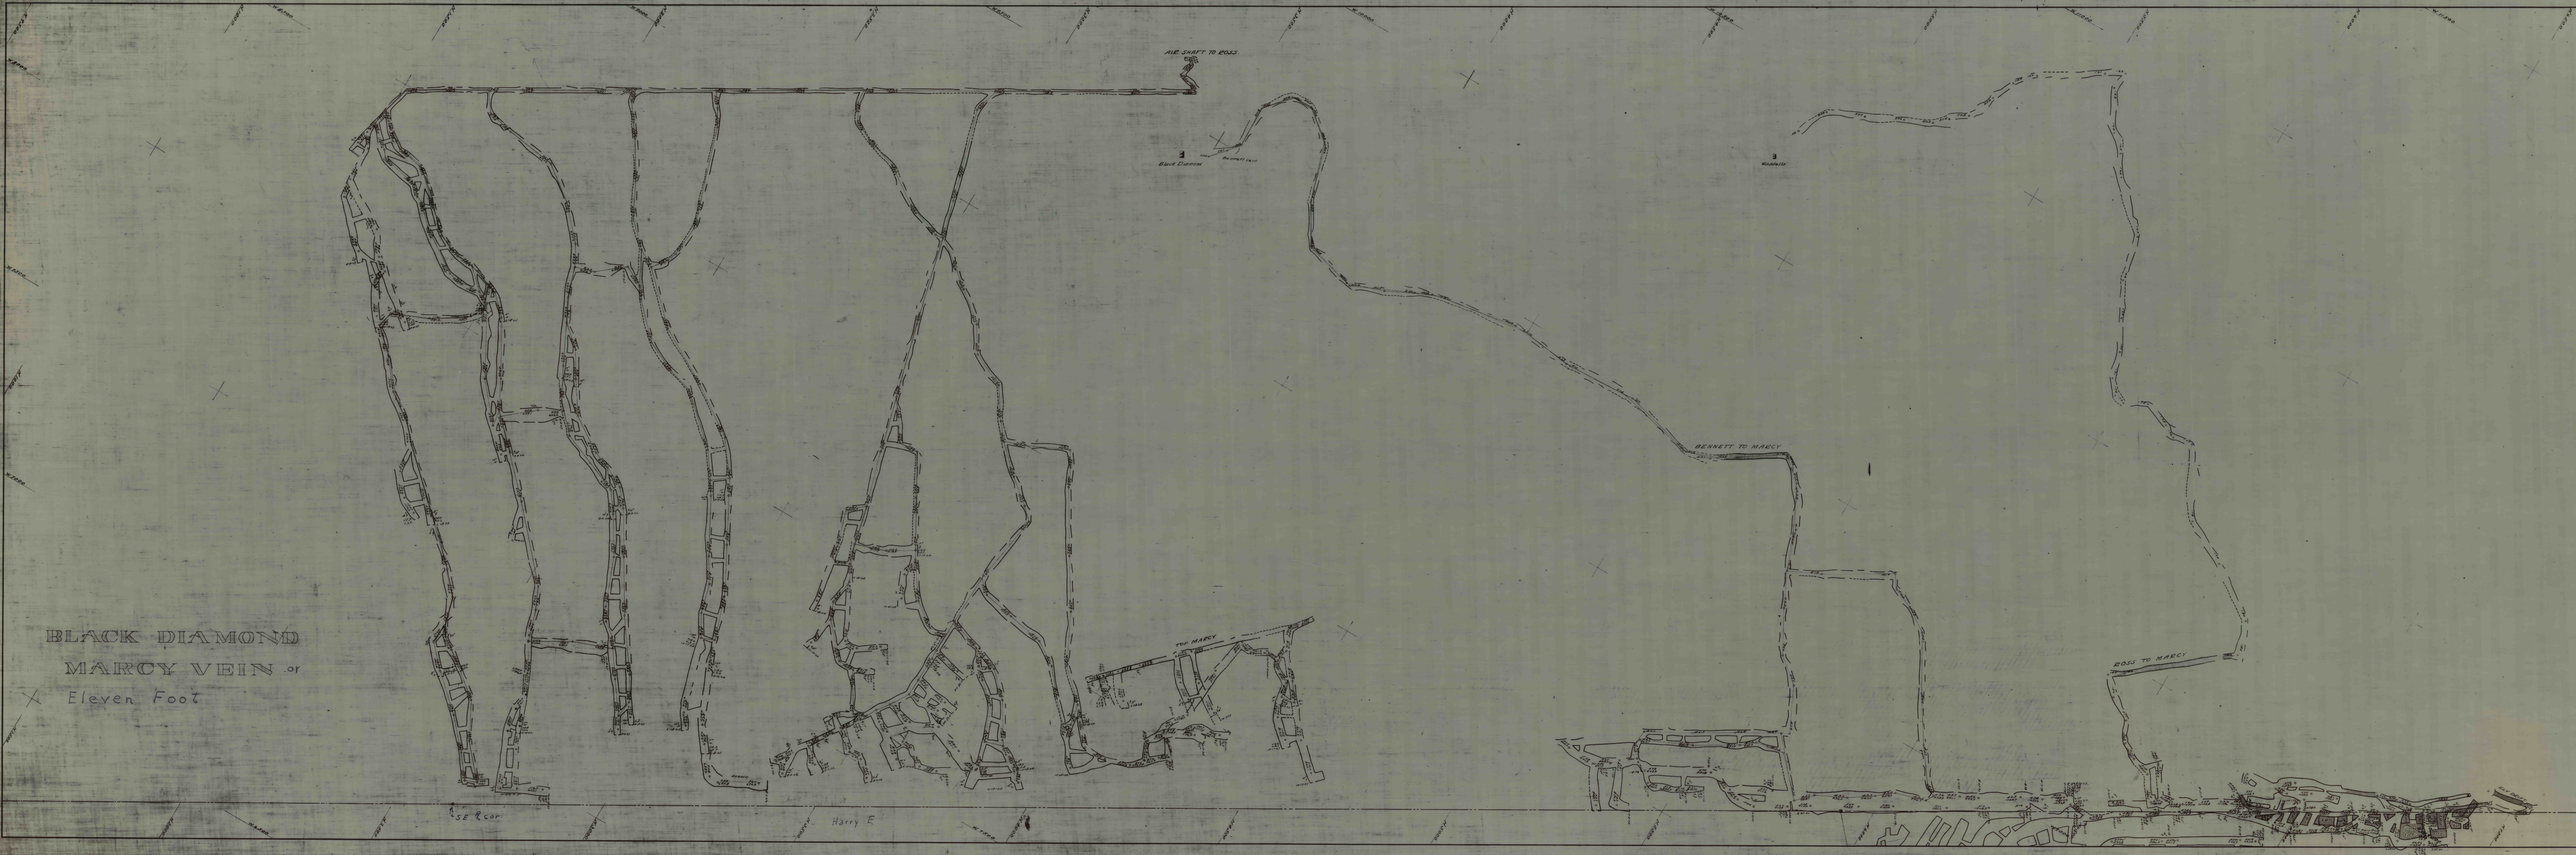
BLACK DIAMOND
MARCY VEIN or
Eleven Foot
AIR SHAFT TO BOSS
BENNETT TO MARCY
BOSS TO MARCY
Harry E