


Map of Thos Maddell's Mill Hollow Colliery &
Ross Vein

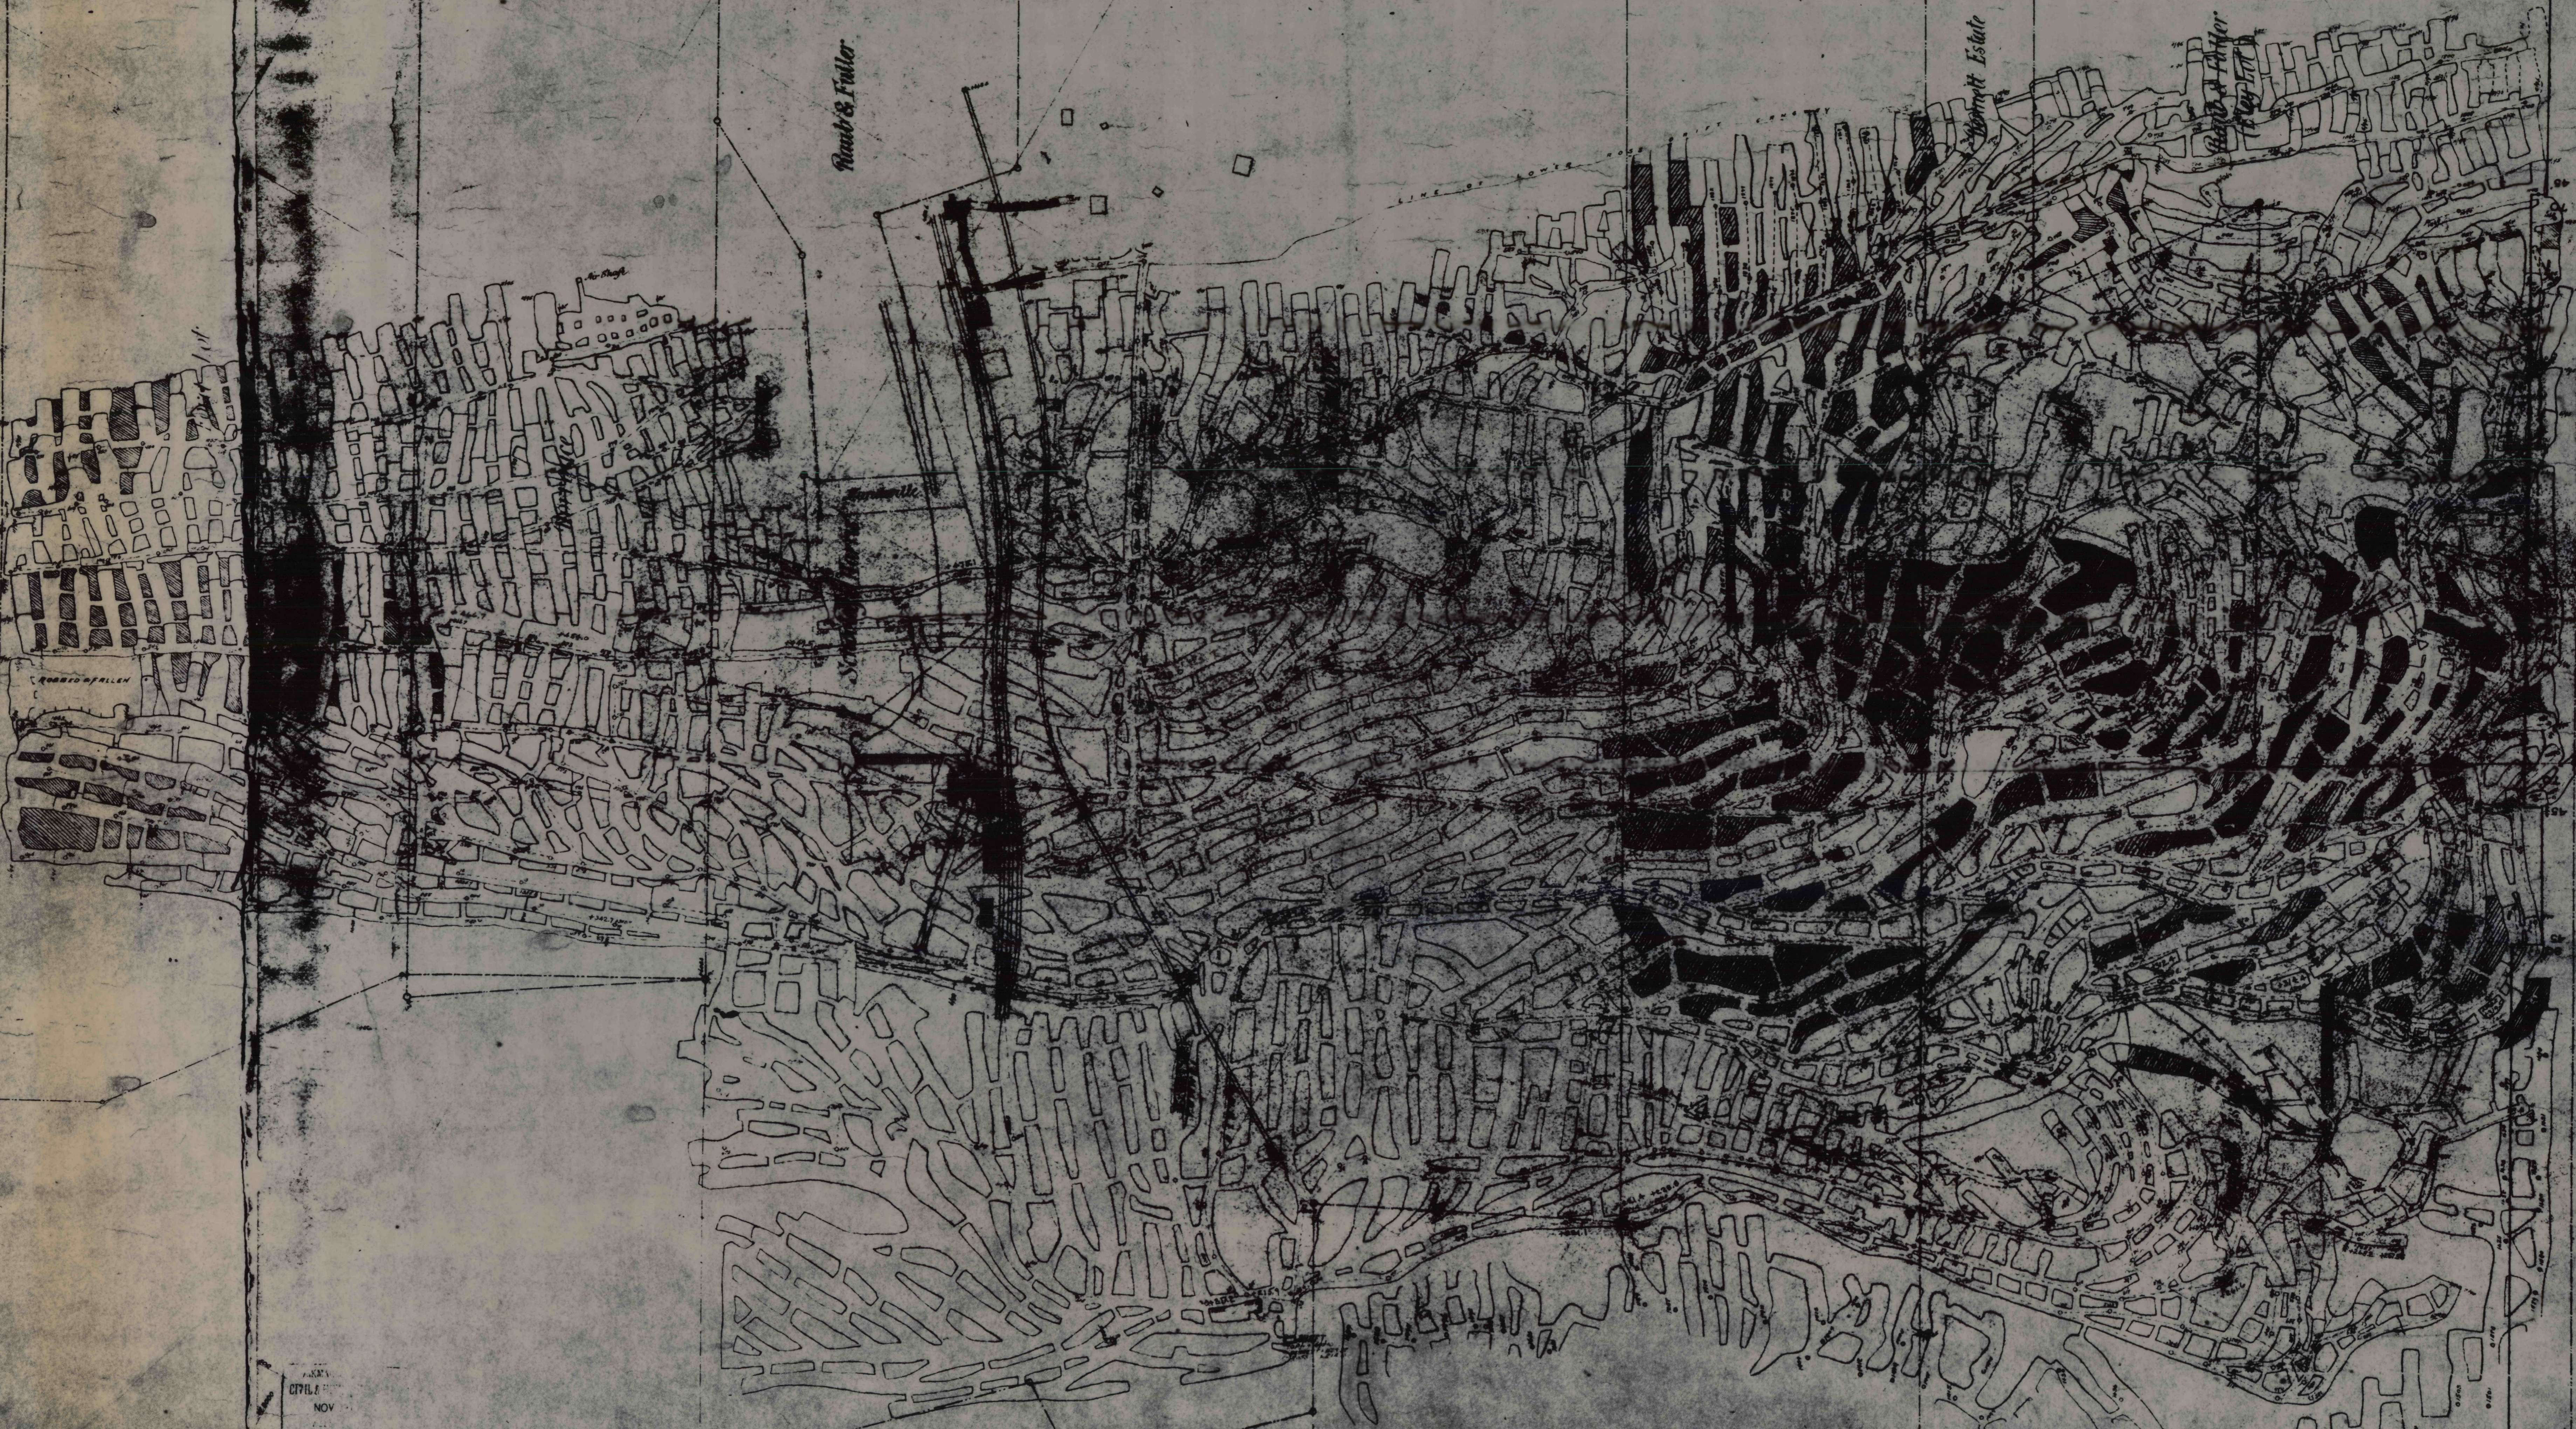

NOV