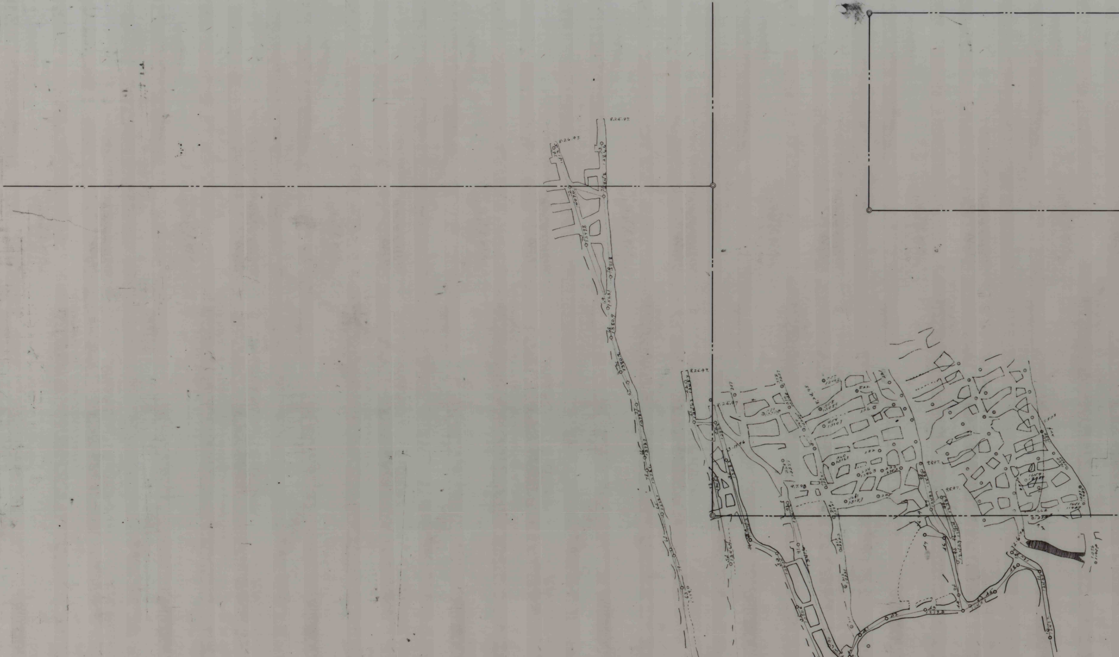
8.26.97.
8.25.97.
8.26.97.
1407.0
1347.8

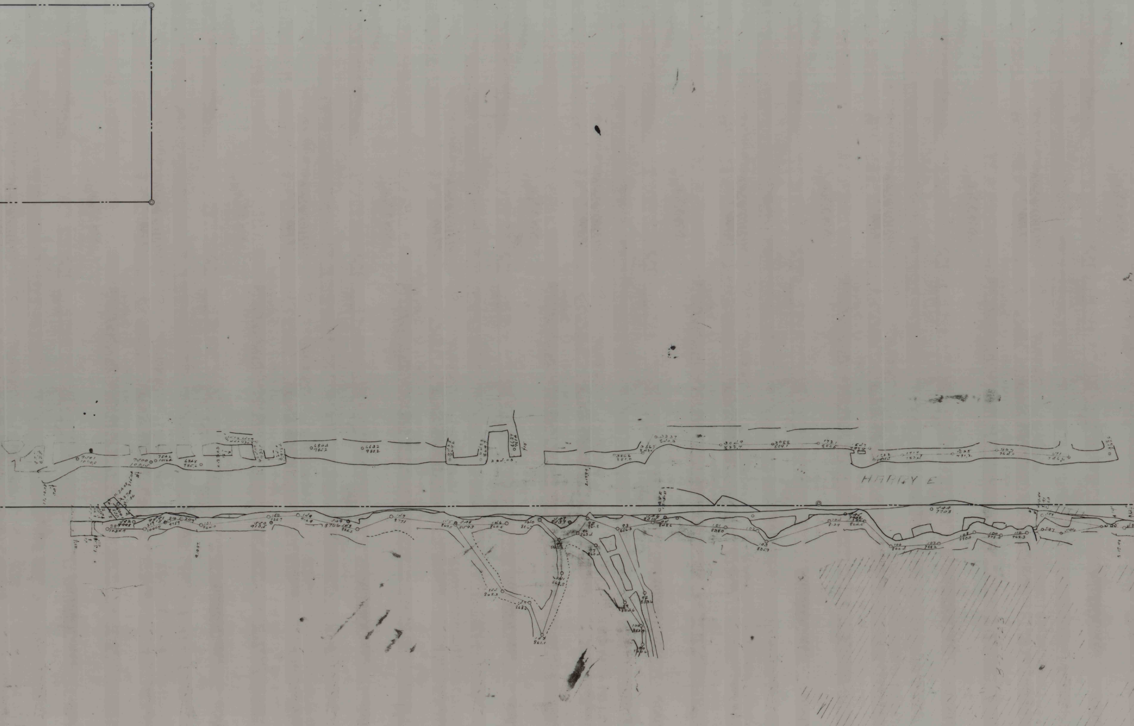
HARRY E.

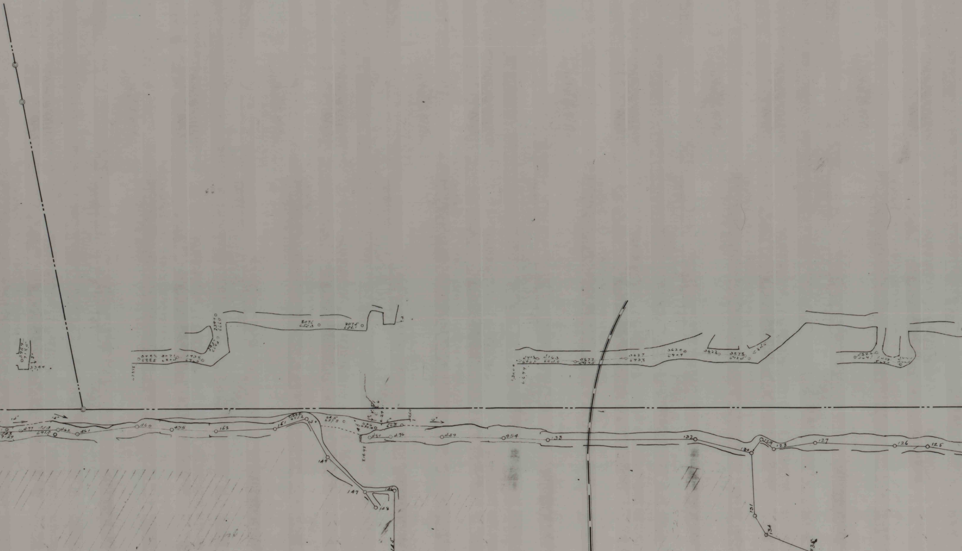12°
15°
161
160
455
152
151
150
149
147
148
146
145
8076
655.3
8075
656.1
10°
150
476
459
454
133
132
130
129
128
127
126
125
131
134
135
3627
3620
3622
3878

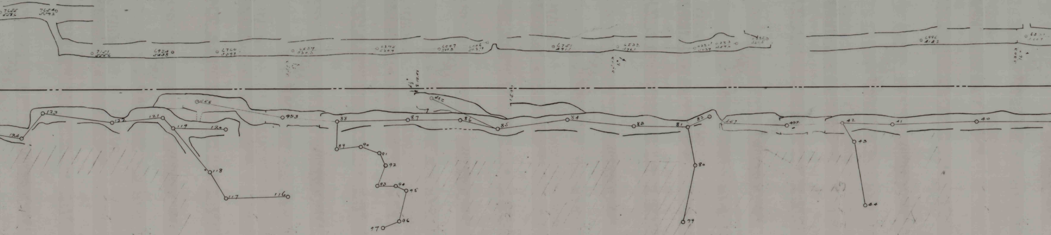
7655
558.6
7654
559.2
7151
555.6
6924
543.8
6760
539.1
6007
511.8
6751
491.1
6996
414.2
124
123
122
121
119
120
118
117
116
458
453
88
87
86
452
85
89
90
91
92
93
94
95
96
97
84
83
82
81
80
79
451
457
42
41
40
43
44

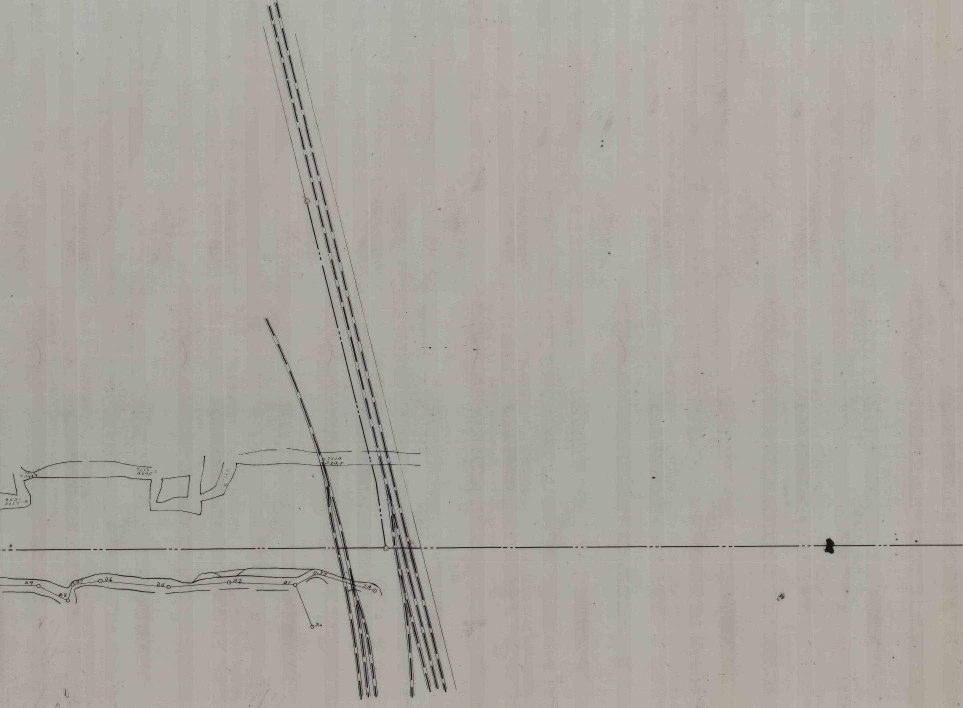
7617
384.9
7616
360.5
7612
6530
3857
7614
323.5
39
38
37
36
35
32
31
33
34
30

No. 33°