


PENNA. COAL CO. COLLIERY

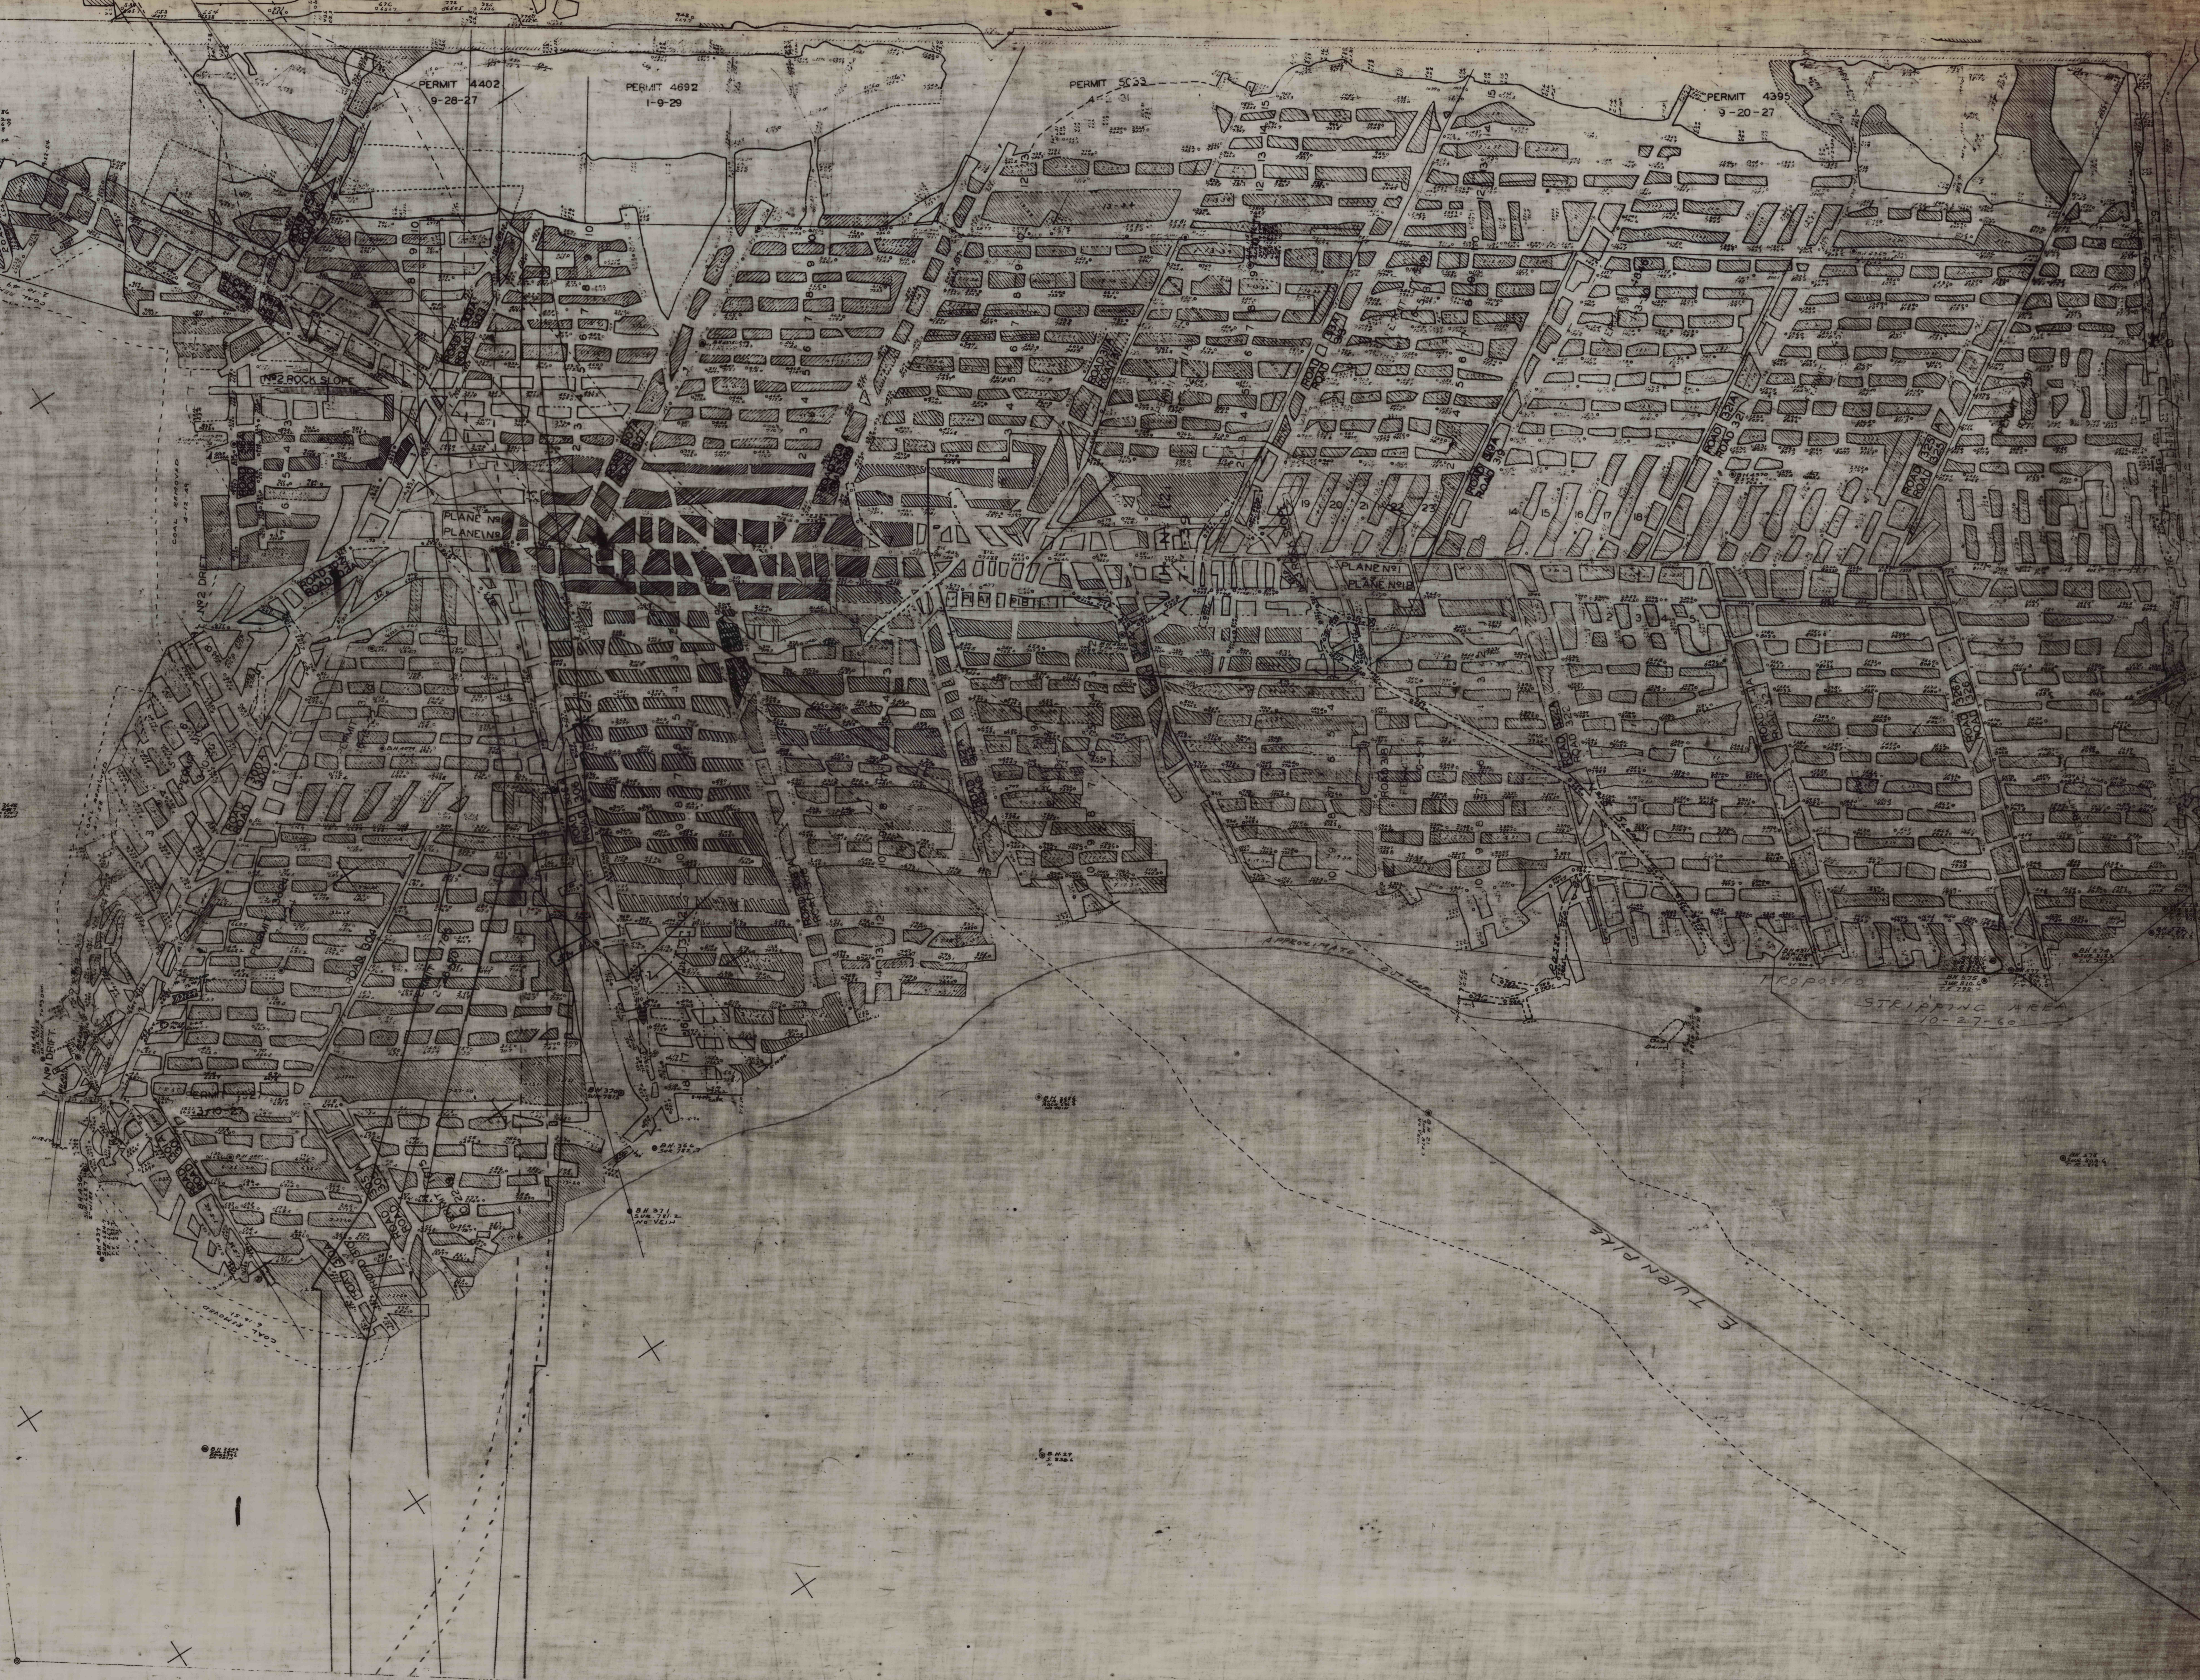

BROADWELL

TOP RED ASH VEIN

BOTTOM SPLIT

LACKAWANNA L.V.C.C. ENGINEER  
SCALE 1:100 JAN 1932

DATUM = ICE