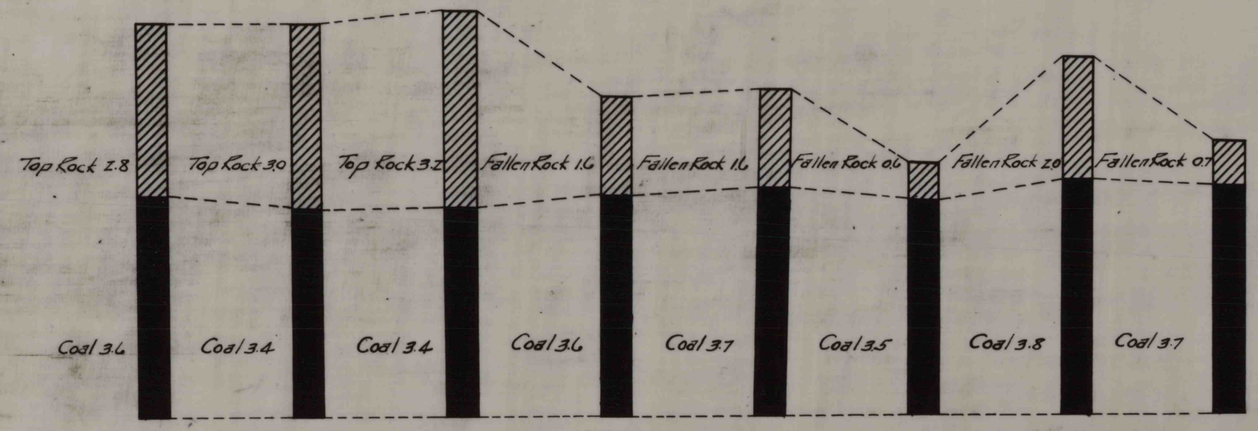

Road No.	300							
Chamber No.	2 off 12	3 off 12	4 off 12	14½	15½	16½	17½	18½
Miners No.	338	330	342	333	341	335	346	347

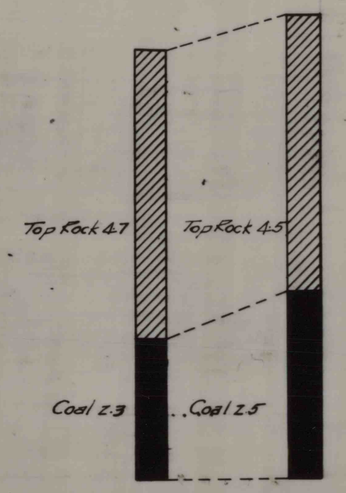

	321	321A
	319	301

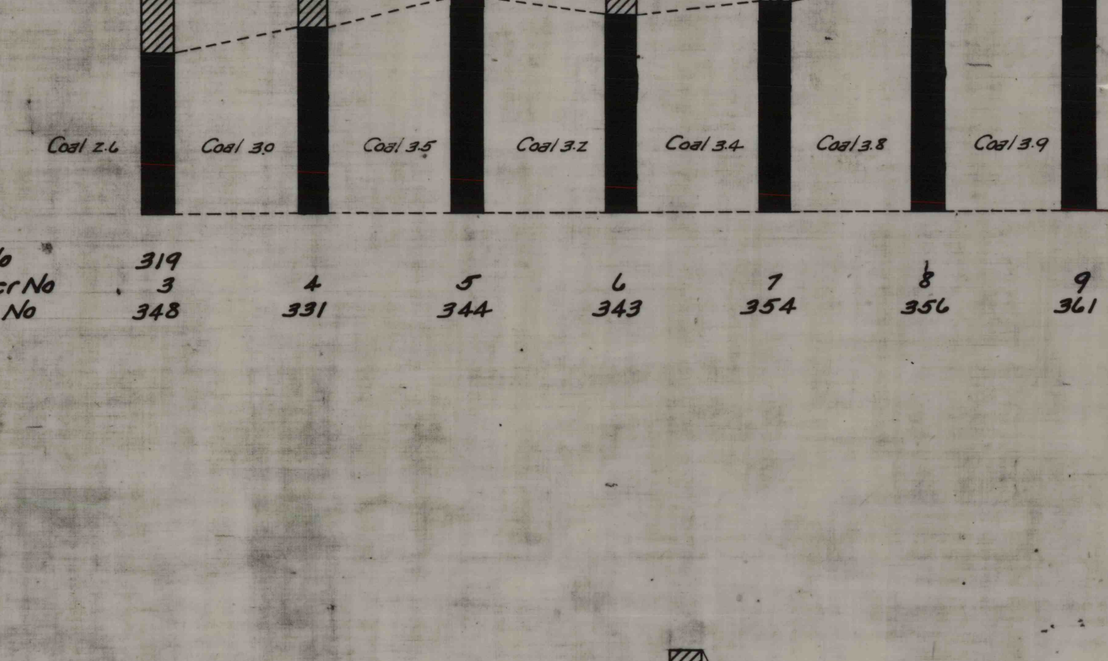

Road No.	313						
Chamber No.	4	5	7	8	9	10	14
Miners No.	339	334	336	349	332	358	337

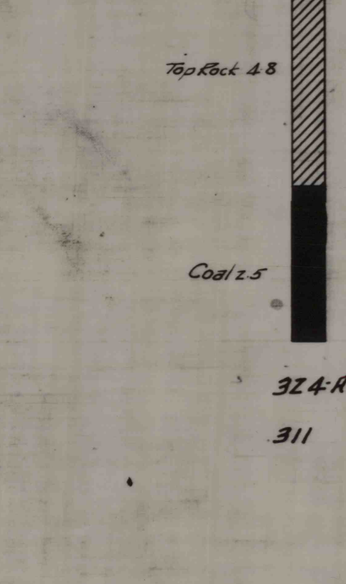

	322	322-A
	302	303

Road No	319									319
Chamber No	3	4	5	6	7	8	9	10		
Miners No	348	331	344	343	354	356	361	360		306

	324-A
	311

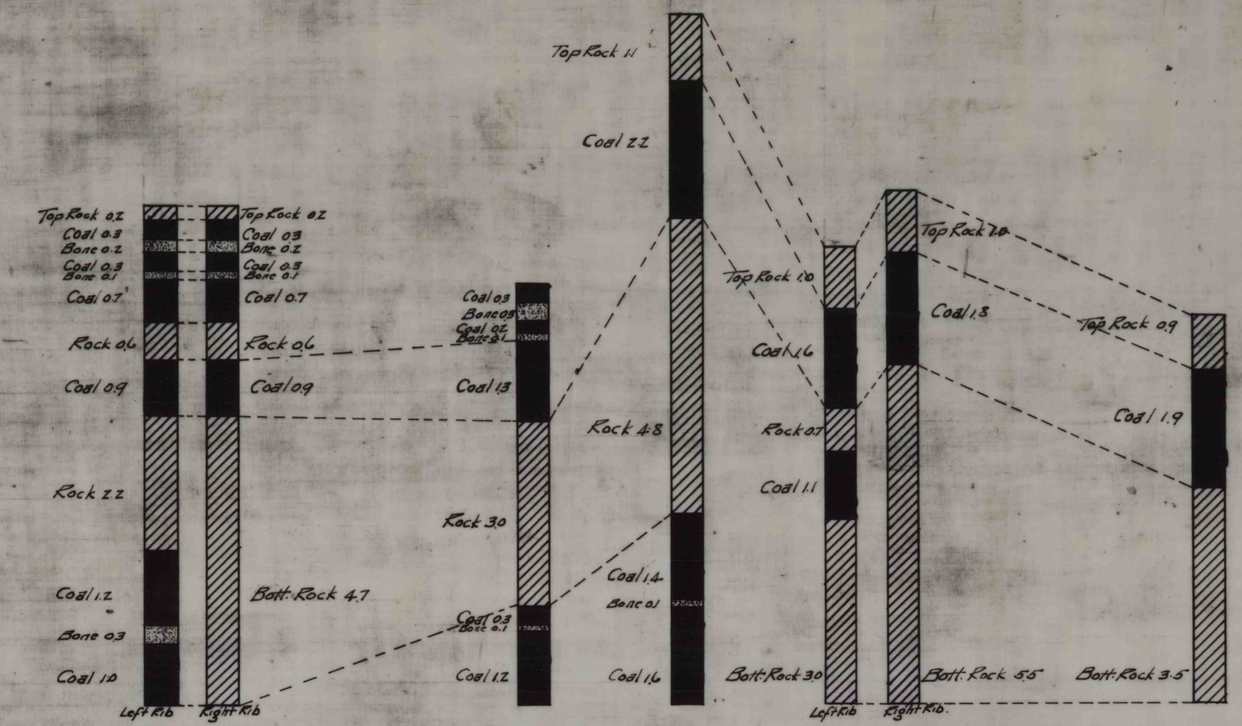

Road No	402		6	9	12	13
Chamber No	3					
Miners No	233		245	238	236	237

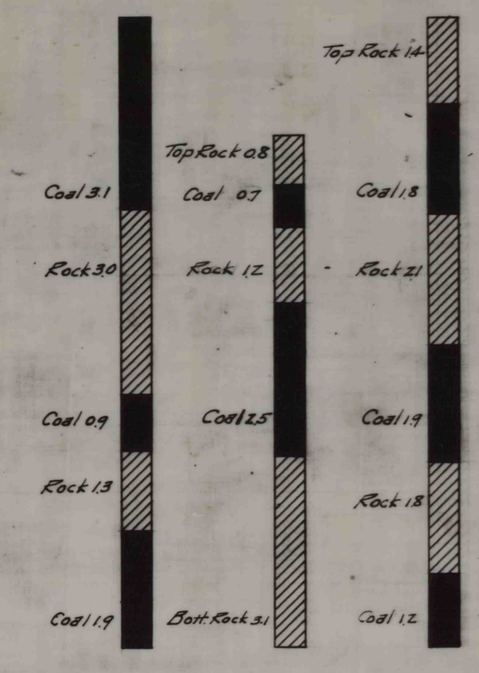

Road No	405		409	417
Chamber No	0	2	3	
Miners No	205	234	232	208