


Road No	313												
Chamber No	2	3	4	5	6	7	8	9	10	12	13	14	
Miners No	356	360	339	334	369	336	345	332	358	361	354	337	

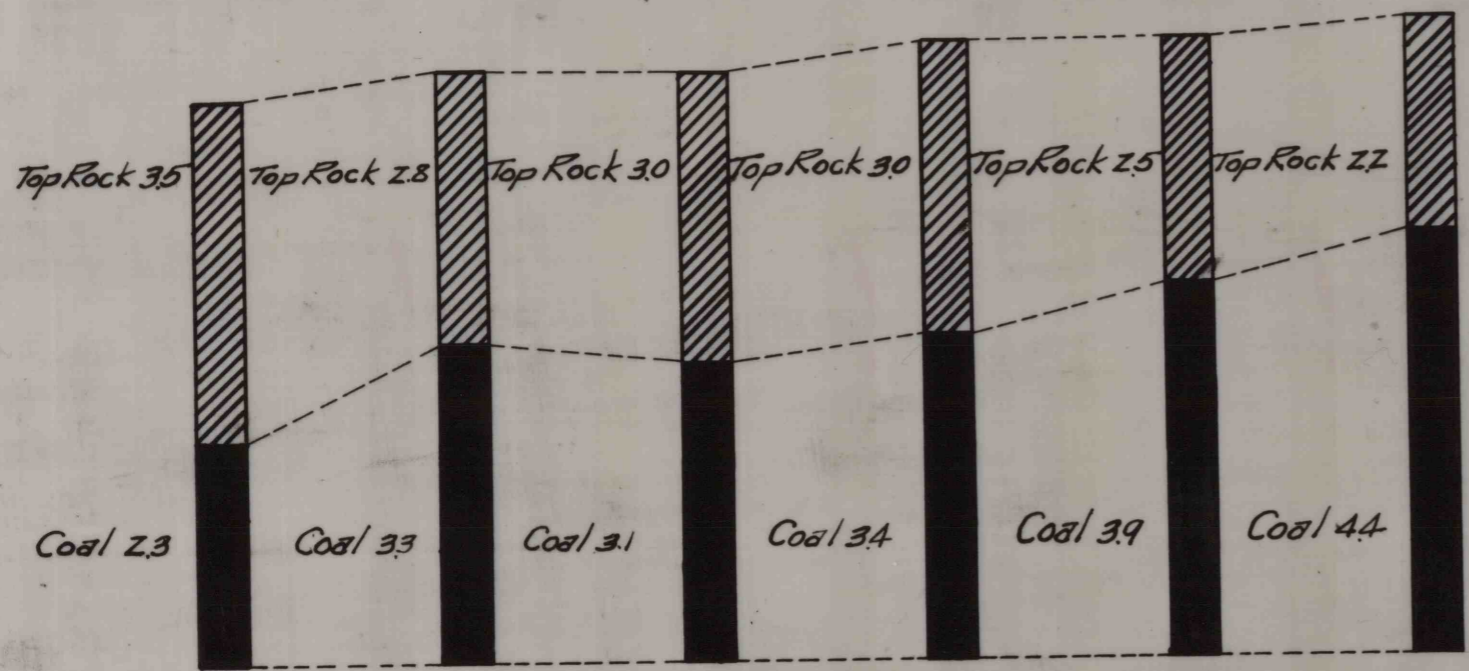

Road No.	319				319R	319
Chamber No.	2	3	4	5	311	306
Miners No.	343	333	331	344		