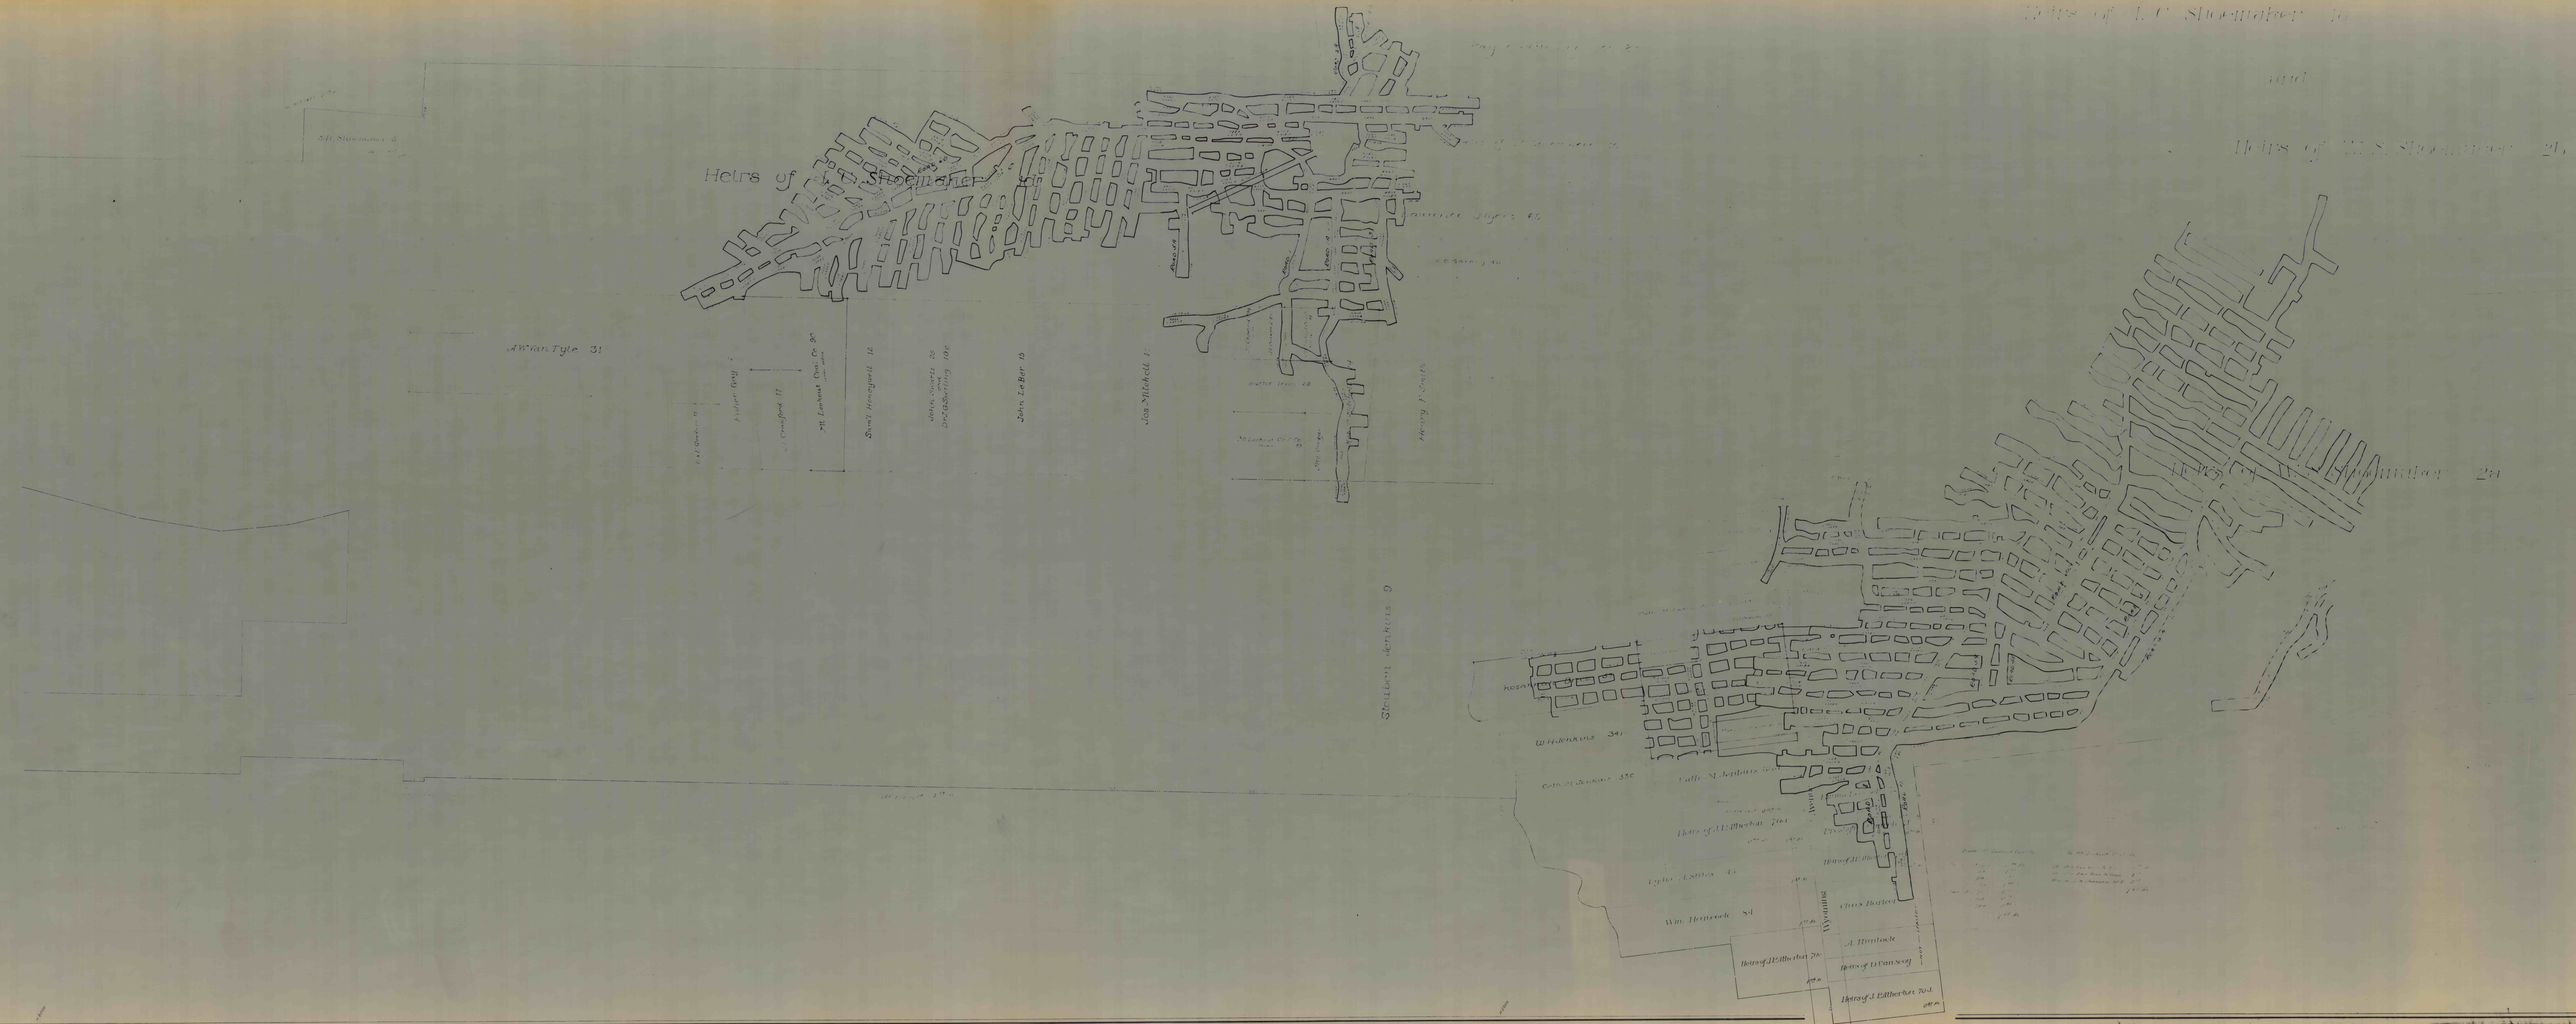
Heirs of L. T. Stoemaker 7a
Heirs of L. C. Stoemaker 7c
and
Heirs of W. S. Stoemaker 2b
Heirs of W. W. Stoemaker 2a
A. Wian Tyle 31
Fisher Geig 1
Crosford 17
Saml Hengwell 12
John Sparks 28
Dr. Goldring 10c
John LeBer 15
Jos Mitchell 11
Henry F. Smith
Stoebert Jenkins 9
W. Hendricks 34
Colin St. Jenkins
Taylor Lattin 1a
Wm. Hennock 8d
Chas Butler
A. Hoolande
Heirs of J. Litherbar 7b
Heirs of D. Van Seej
Heirs of J. Litherbar 7bd