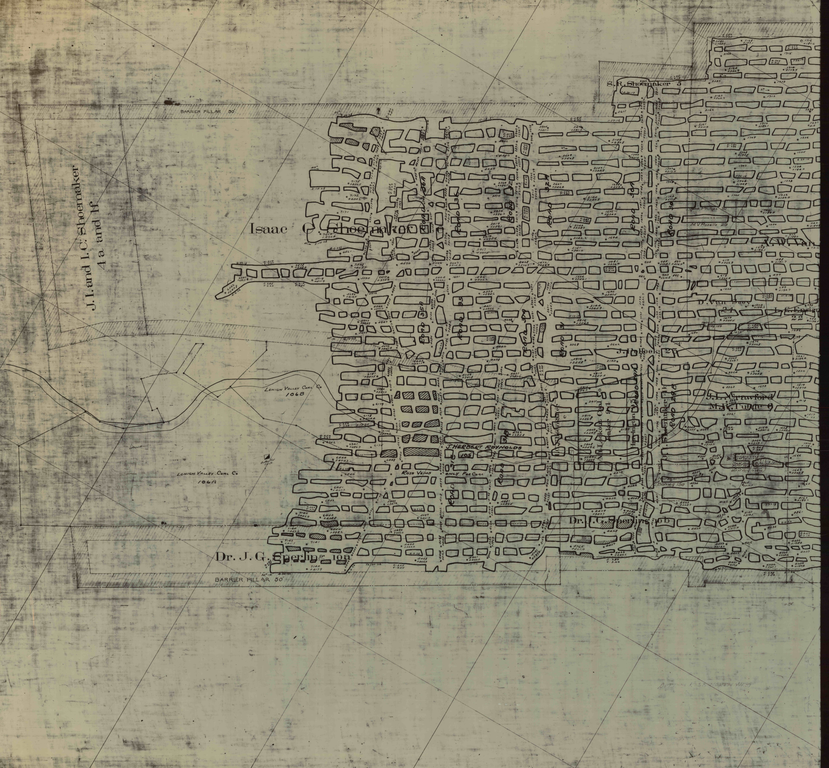

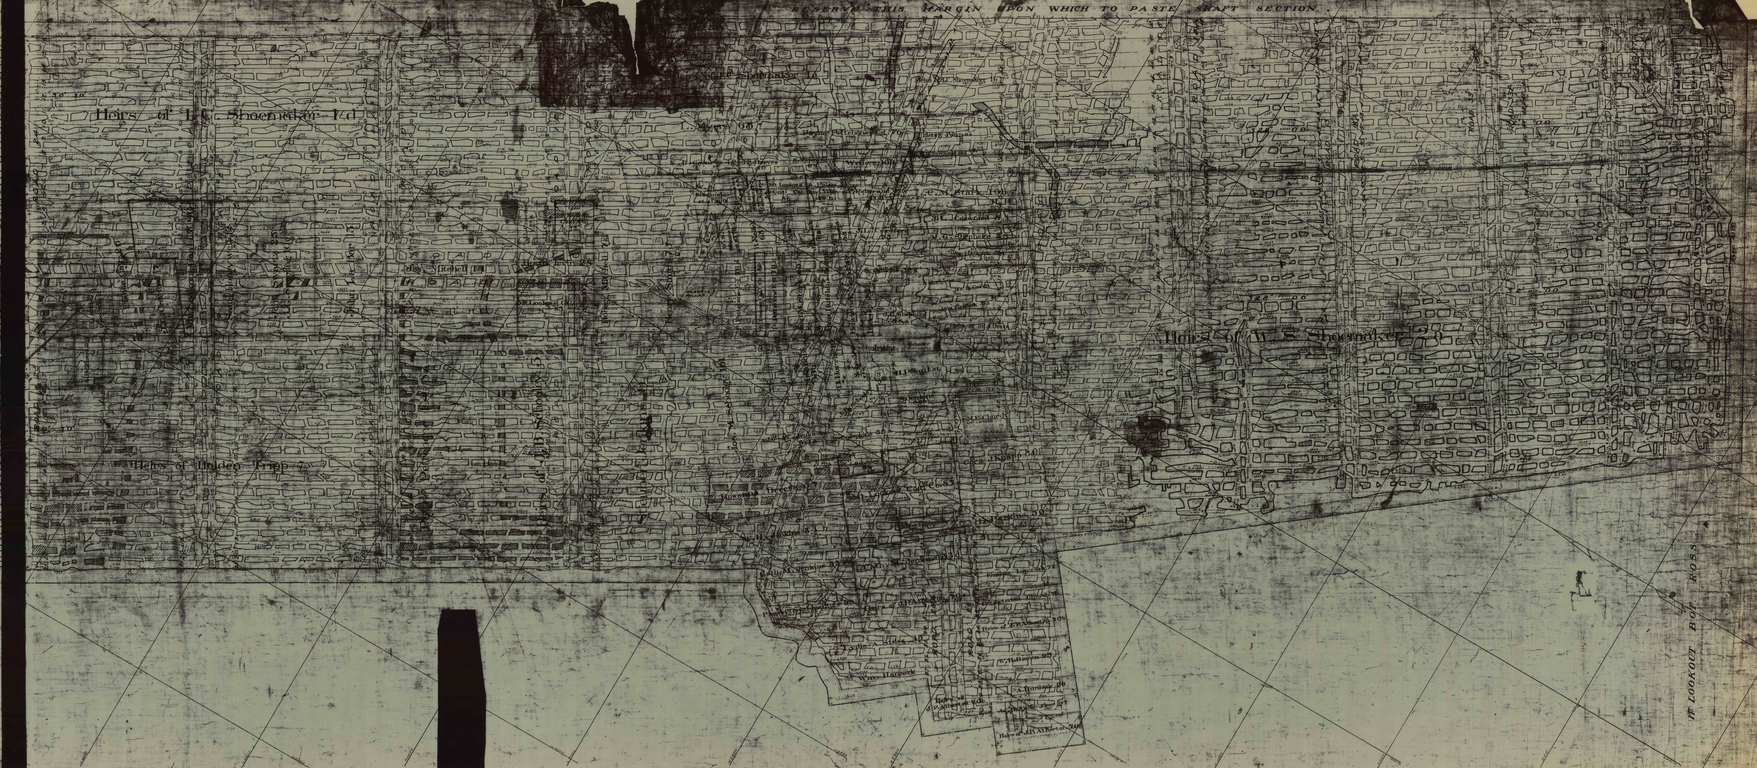
Heirs of I. C. Shoemaker Ltd
Heirs of Hilden Trapp
Heirs of W. S. Shoemaker
RESERVE THIS MARGIN UPON WHICH TO PASTE DRAFT SECTION.
IF LOOKOUT BUT NOT