The Mt. Lookout Colliery

RED ASH VEIN

MOUNT LOOKOUT COAL COMPANY.

WYOMING AND EXETER

BOROUGHS,

LUZERNE COUNTY, PENNA.

Scale
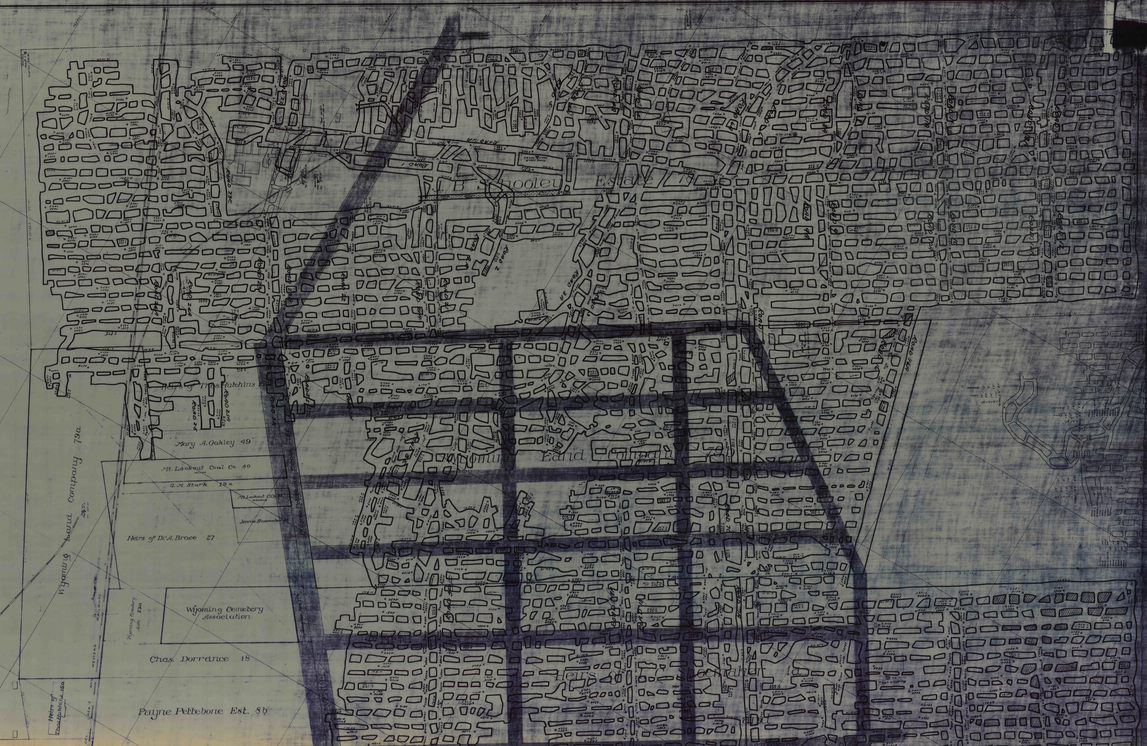
Date of Surveys