

CHECKERS

01-45


CHECKER VEIN
CONSOLIDATED COLLY

Scale 100 ft = 1 in

Mineral located and surveyed
 Survey of November 1905
 Robbing to " "
 Robbing to September 1906
 Robbing to July 1907
 Robbing to Jan. 1908

AVOCA COAL CO

ANGELIFFE COAL CO

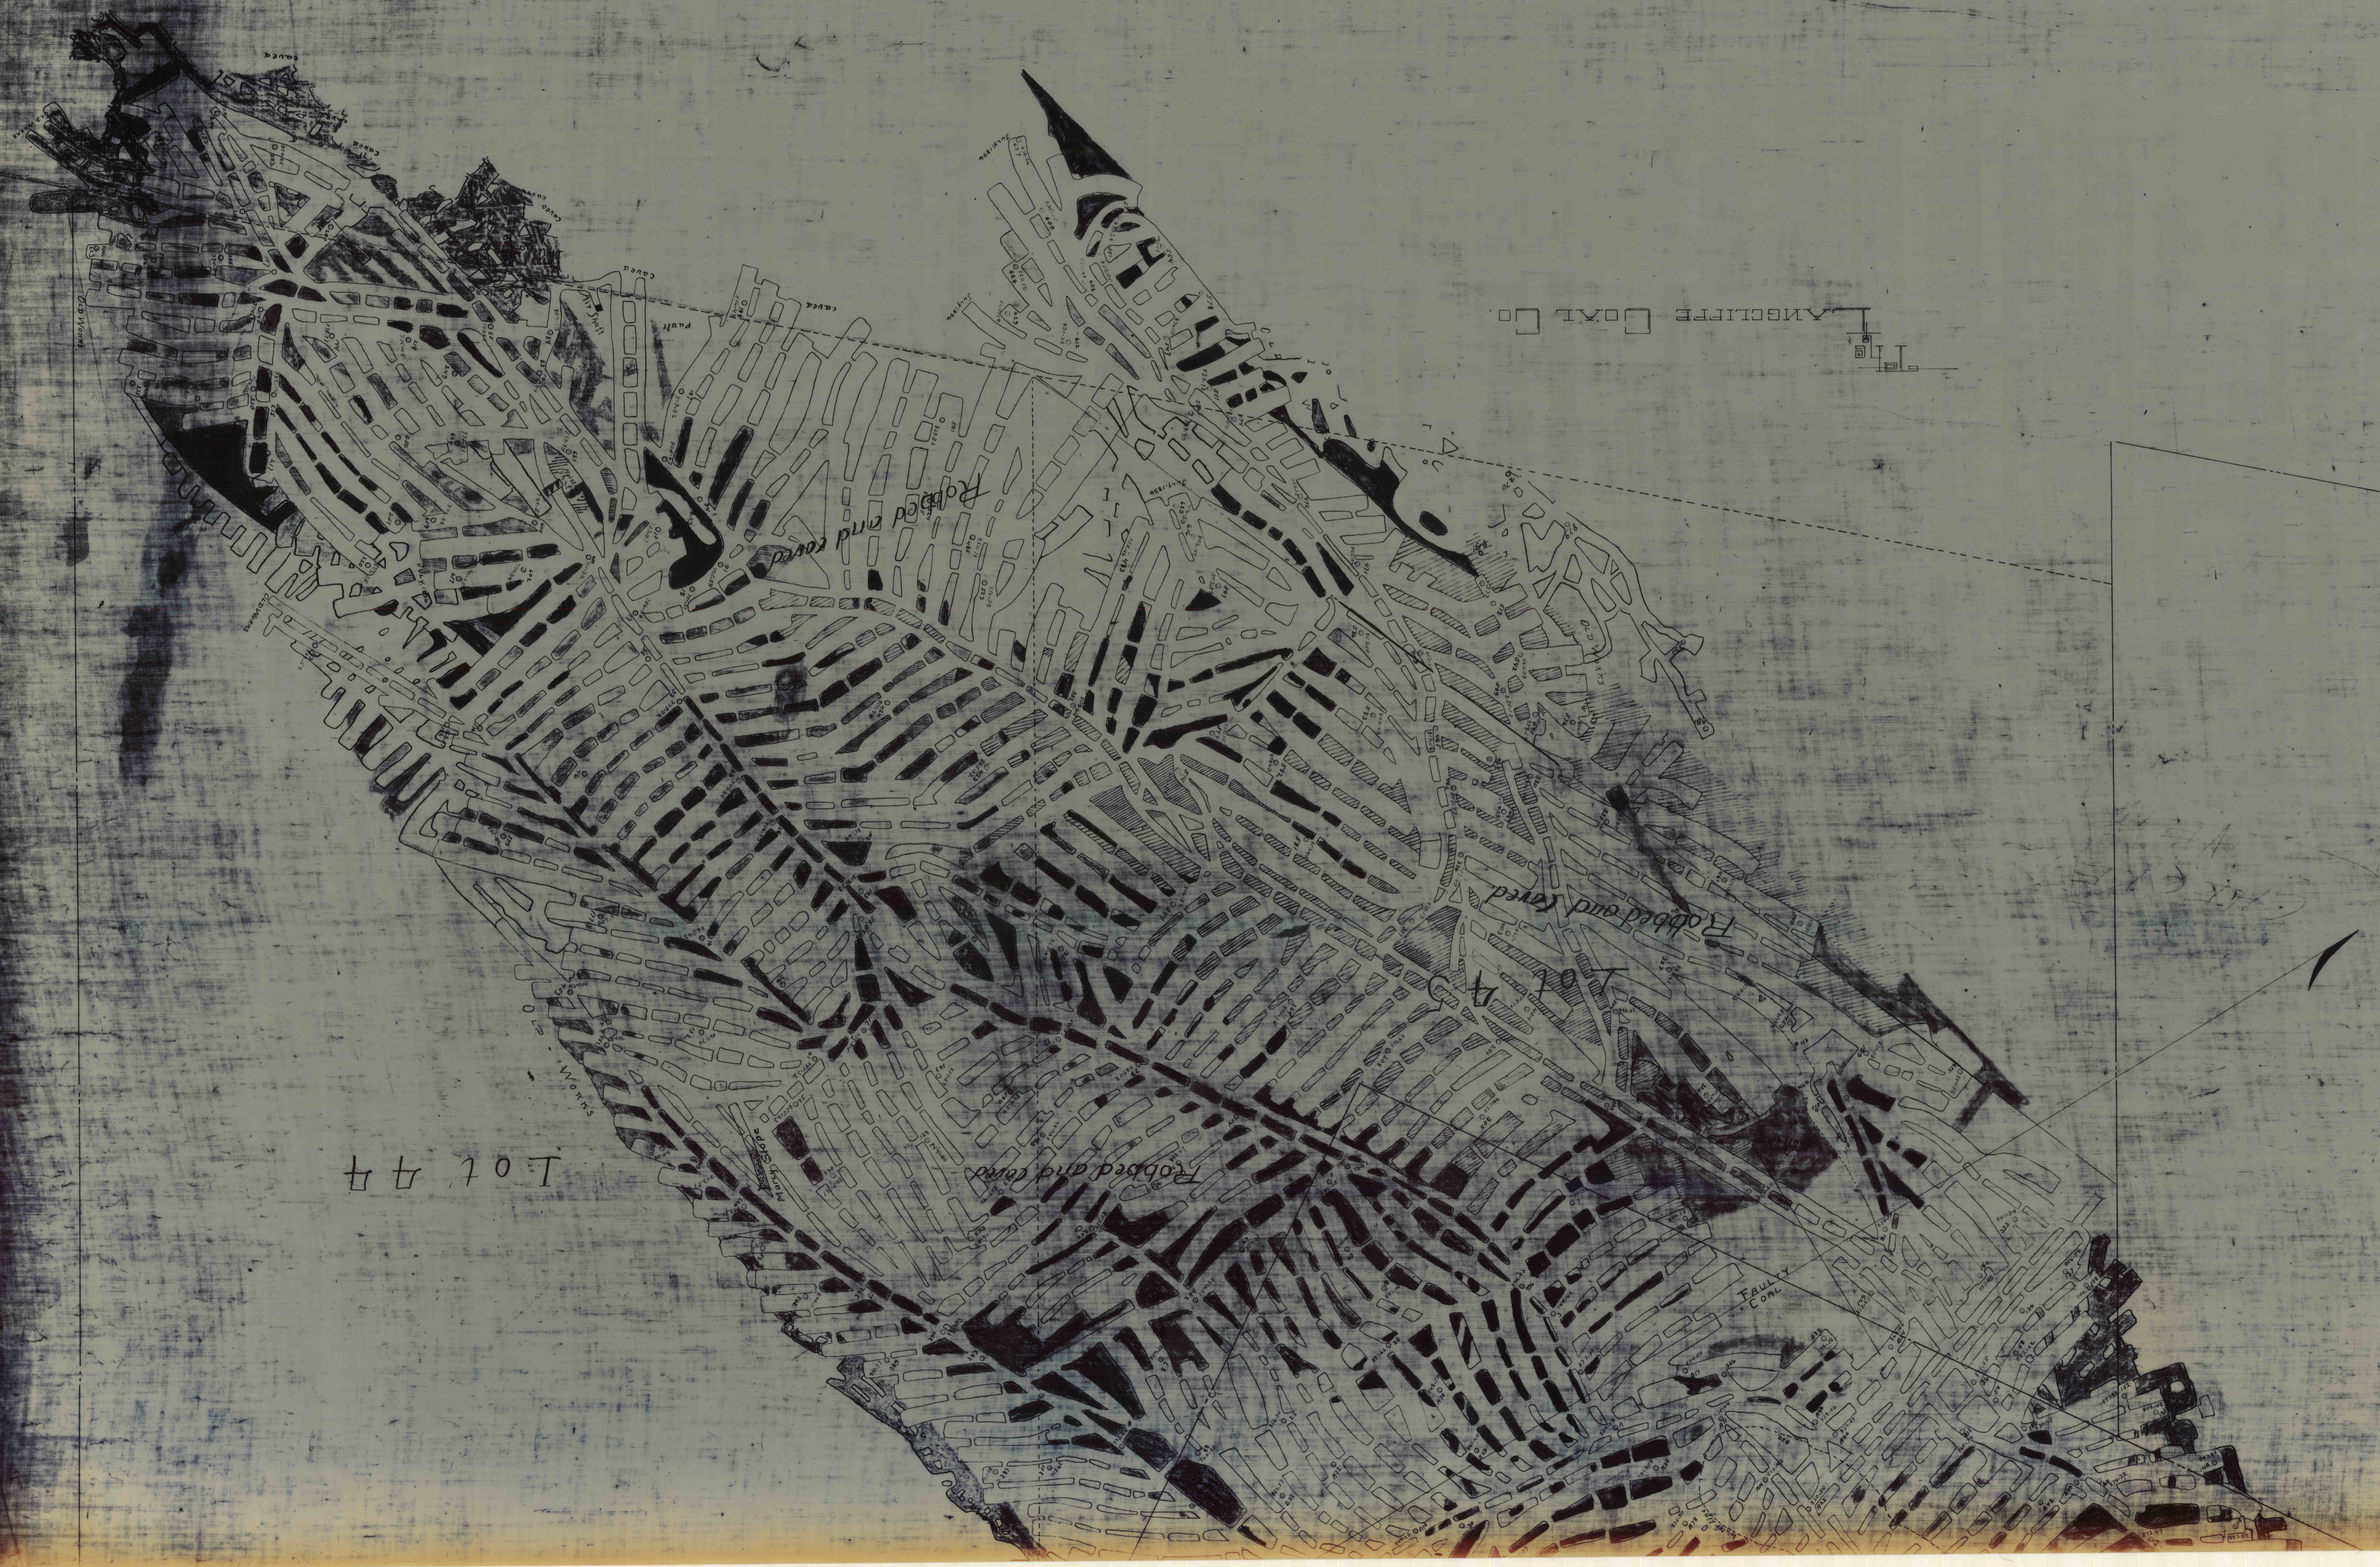

Lot 77