


Mined previous to Jan 1903
Extensions
Extensions
Jan 1904
July 1904

JOHN CARLOWELL
WARRANT

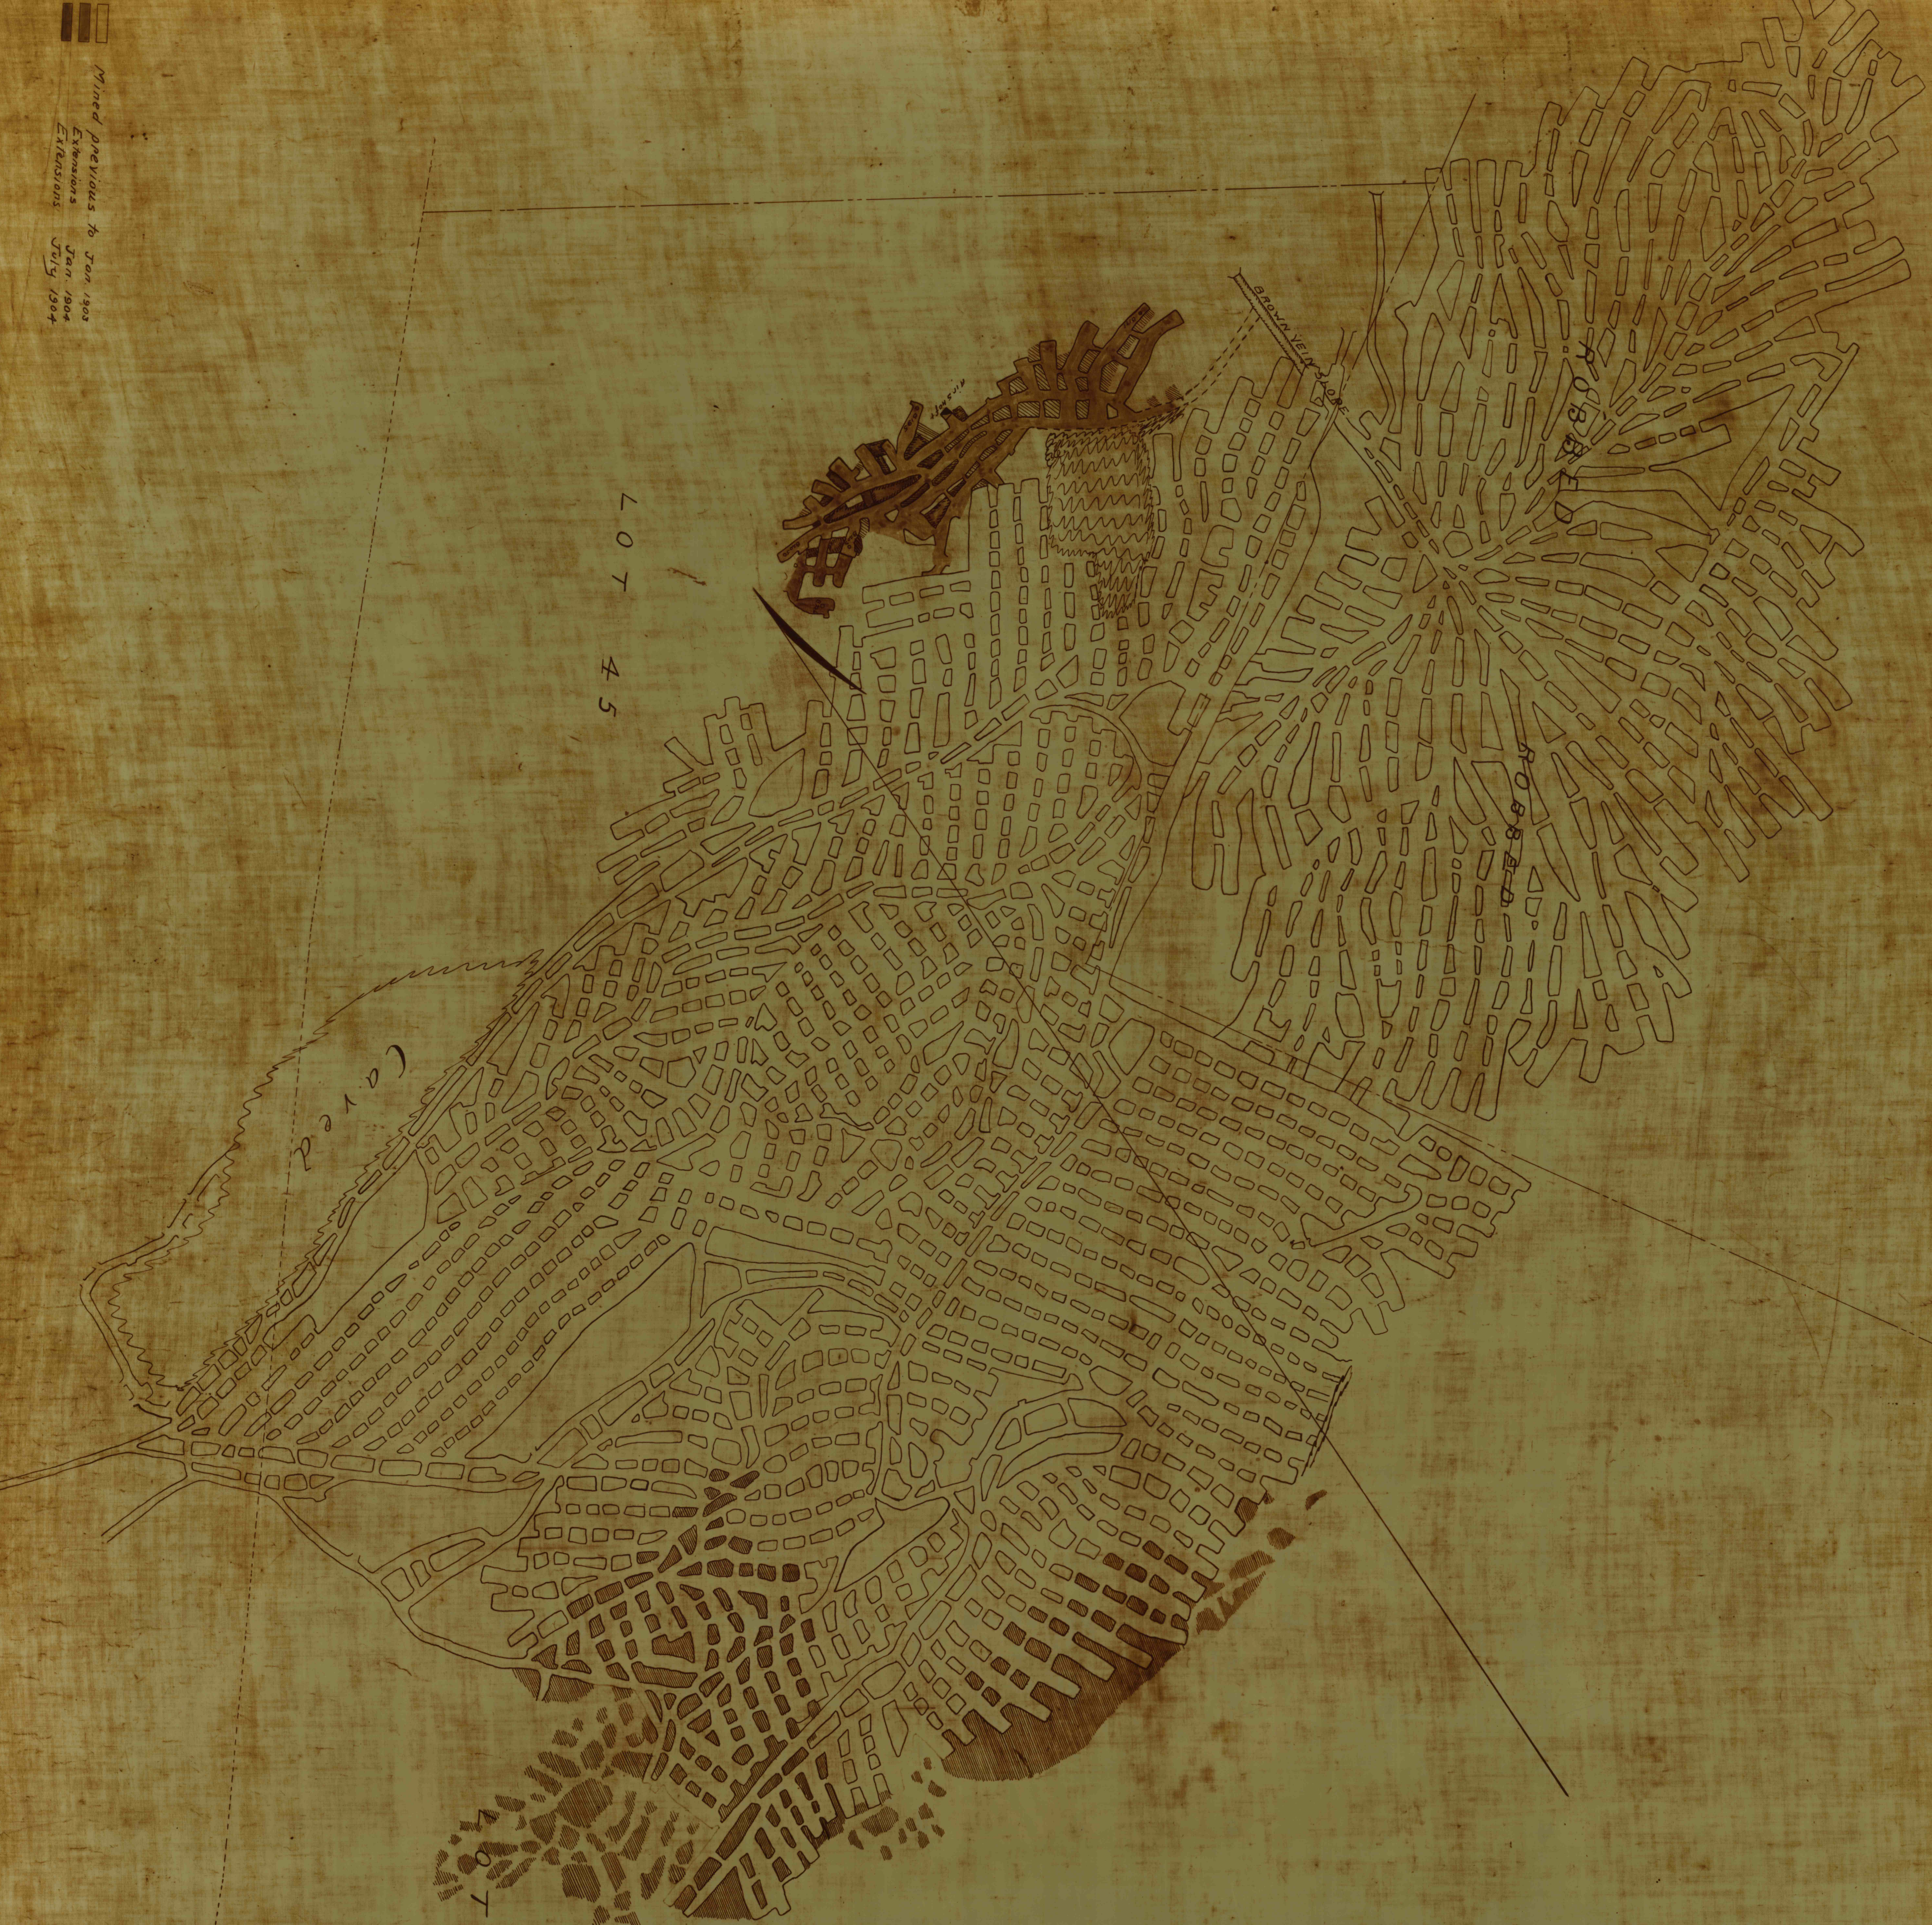

LOT 45

Caved

SANTA VERA SHO

LOT

44