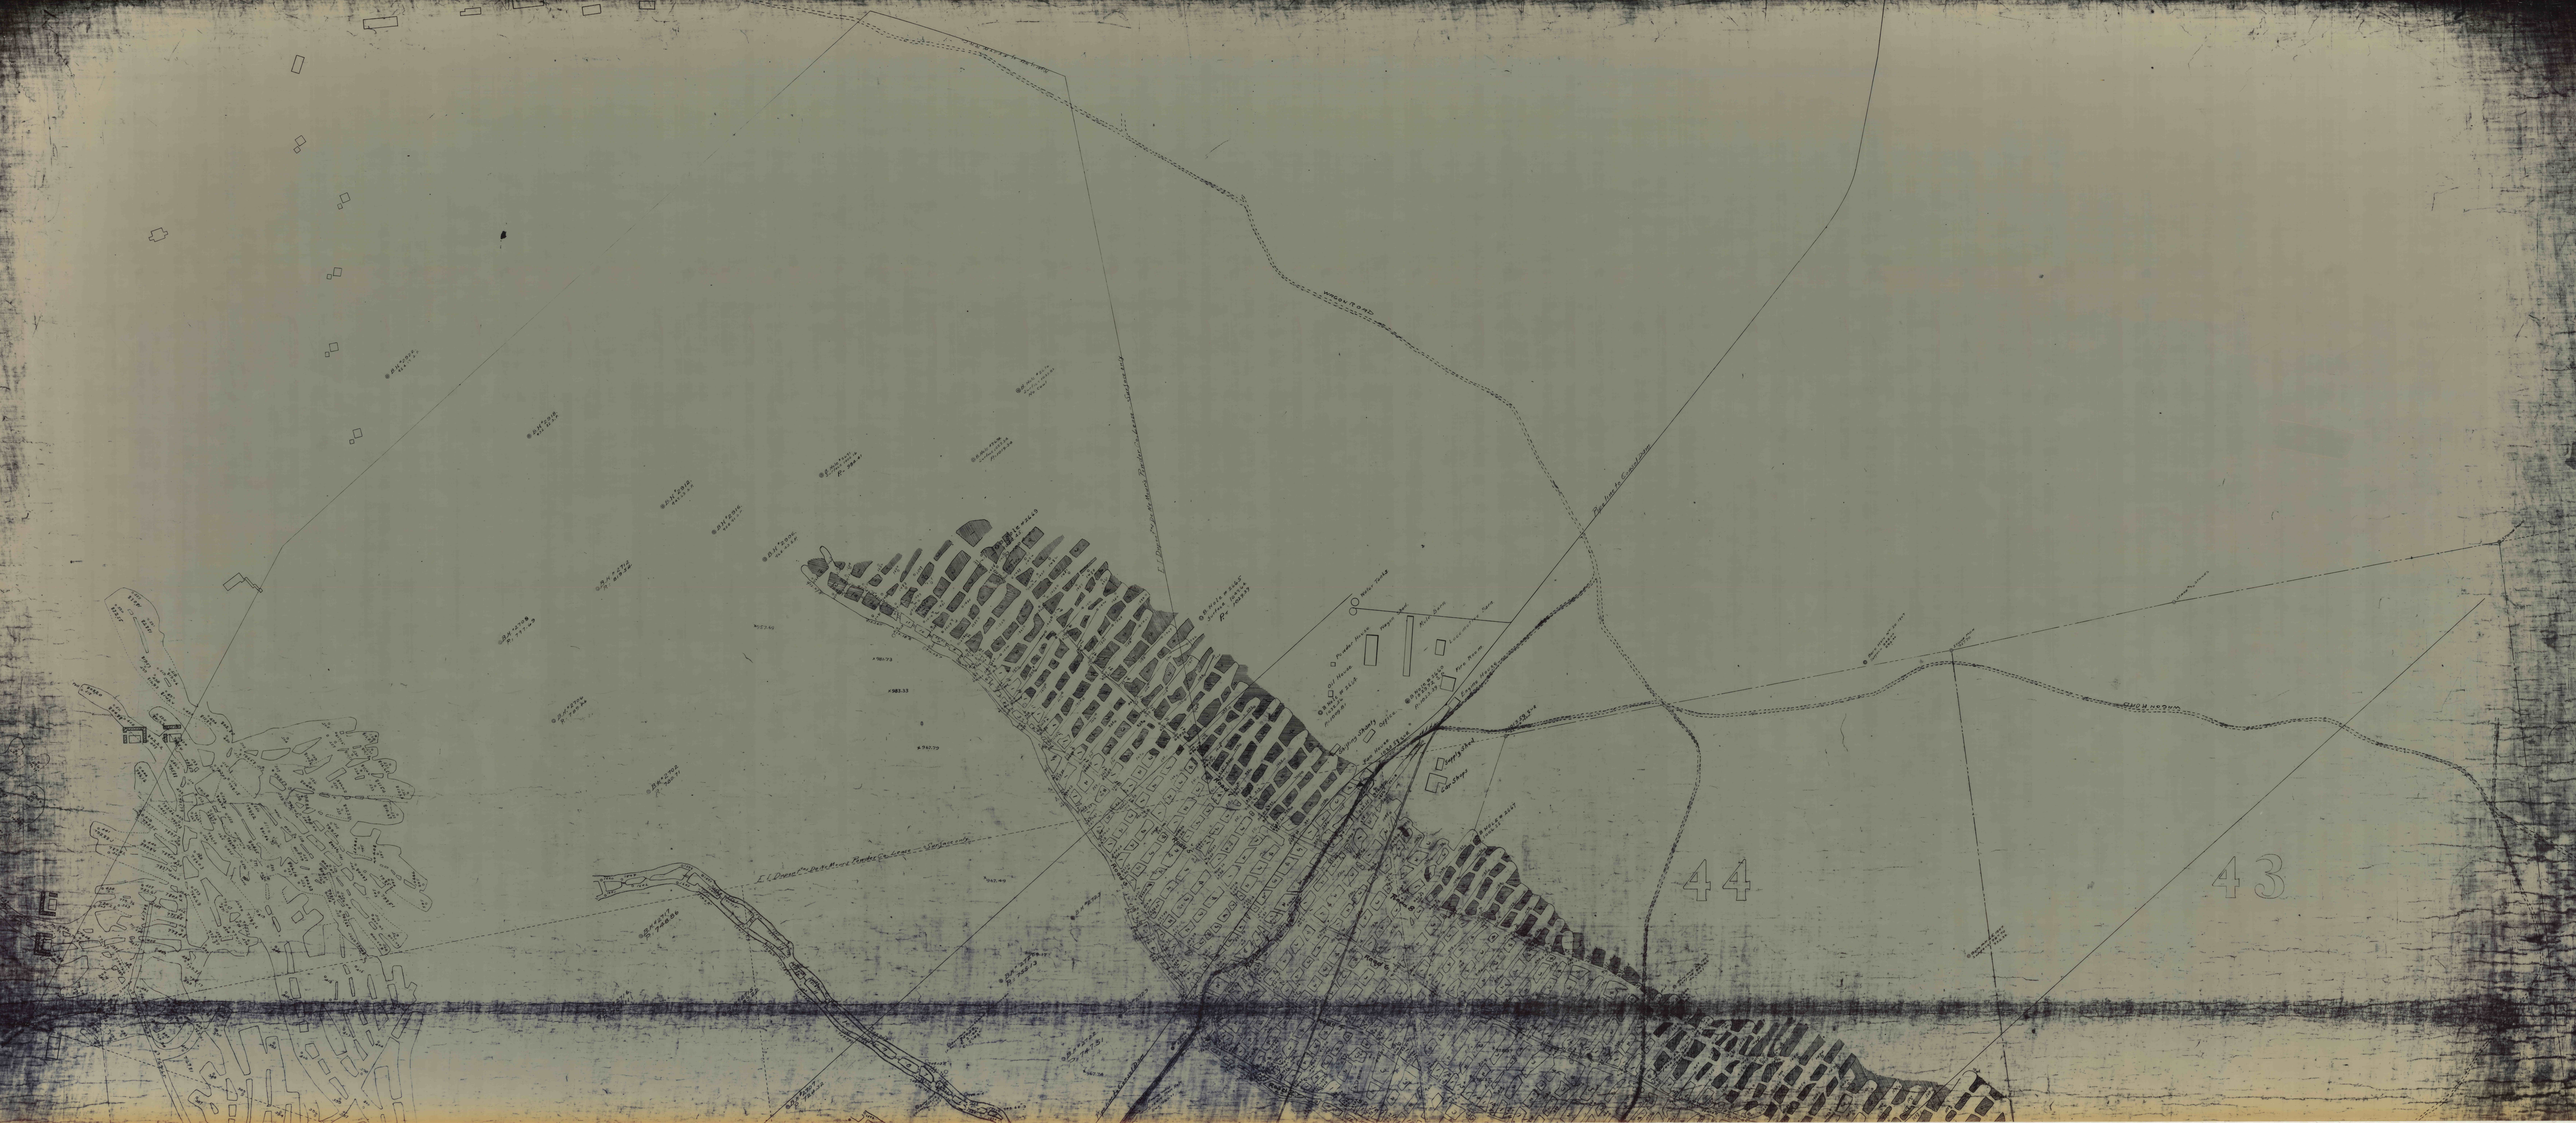
44
43