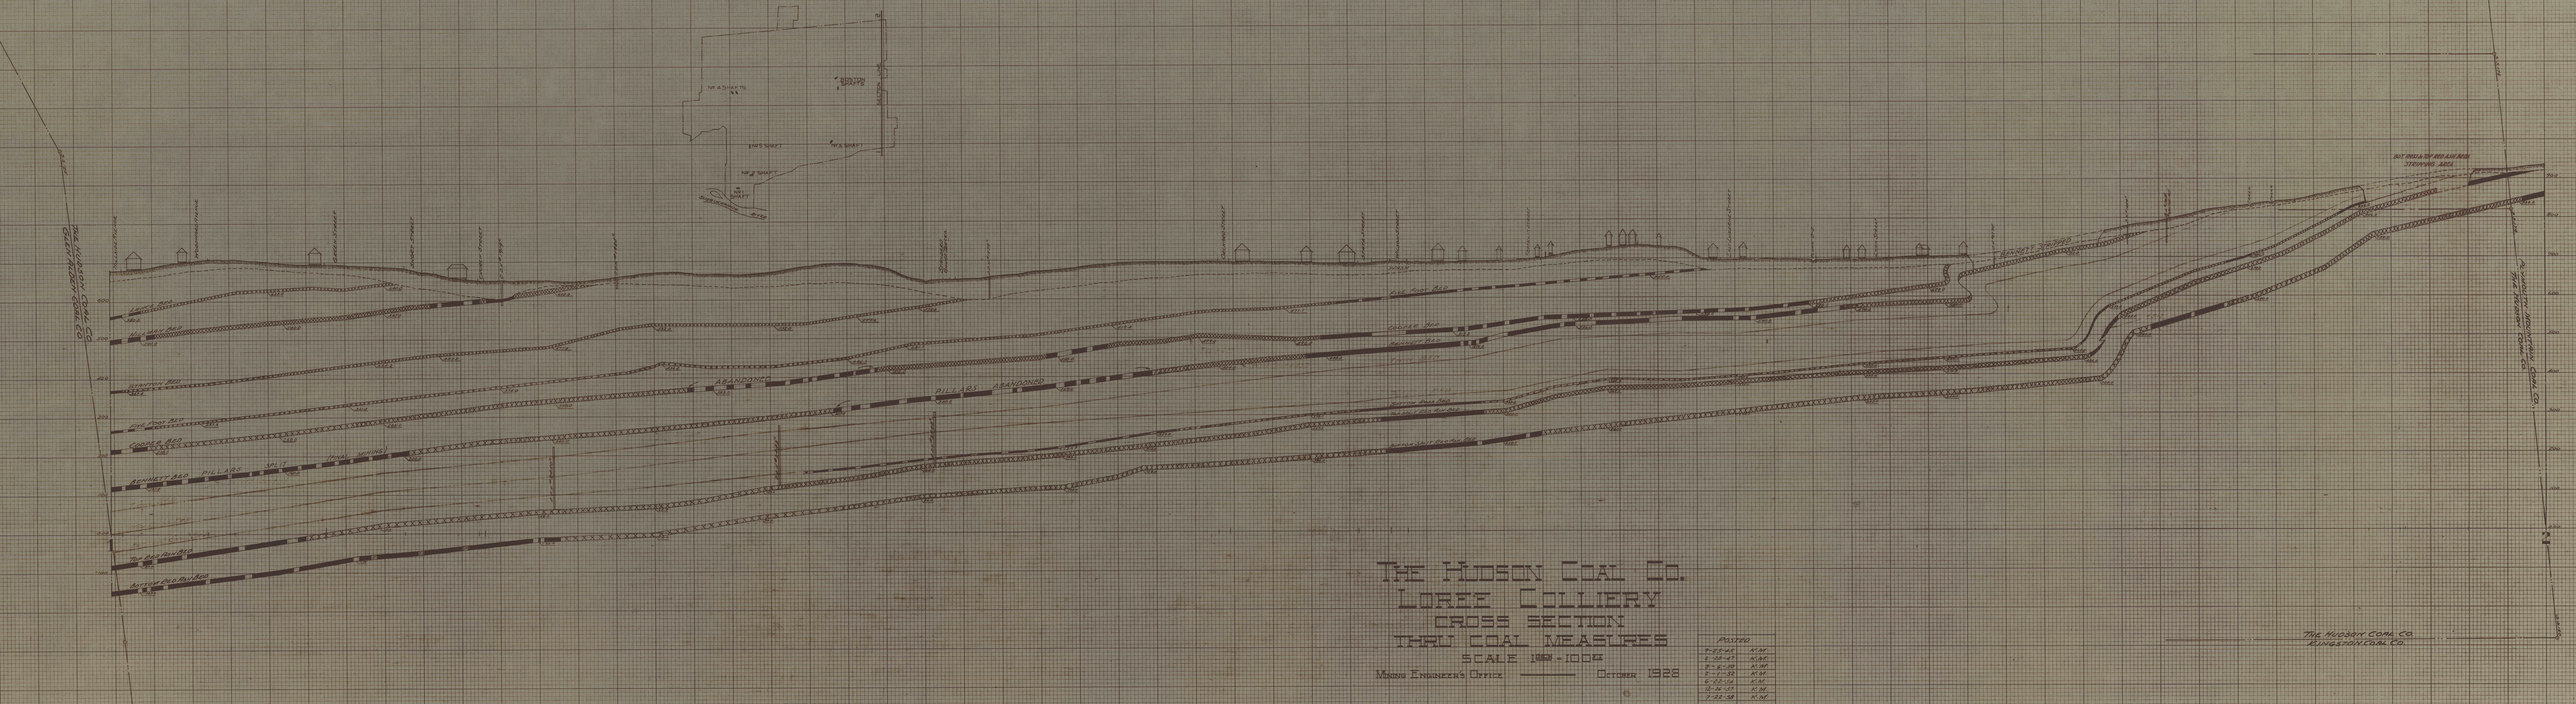
THE HUDSON COAL CO.
LOREE COLLIERY
CROSS SECTION
THRU COAL MEASURES
SCALE 1" = 100'
MINING ENGINEER'S OFFICE — OCTOBER 1928
POSTED
THE HUDSON COAL CO.
KINGSTON COAL CO.