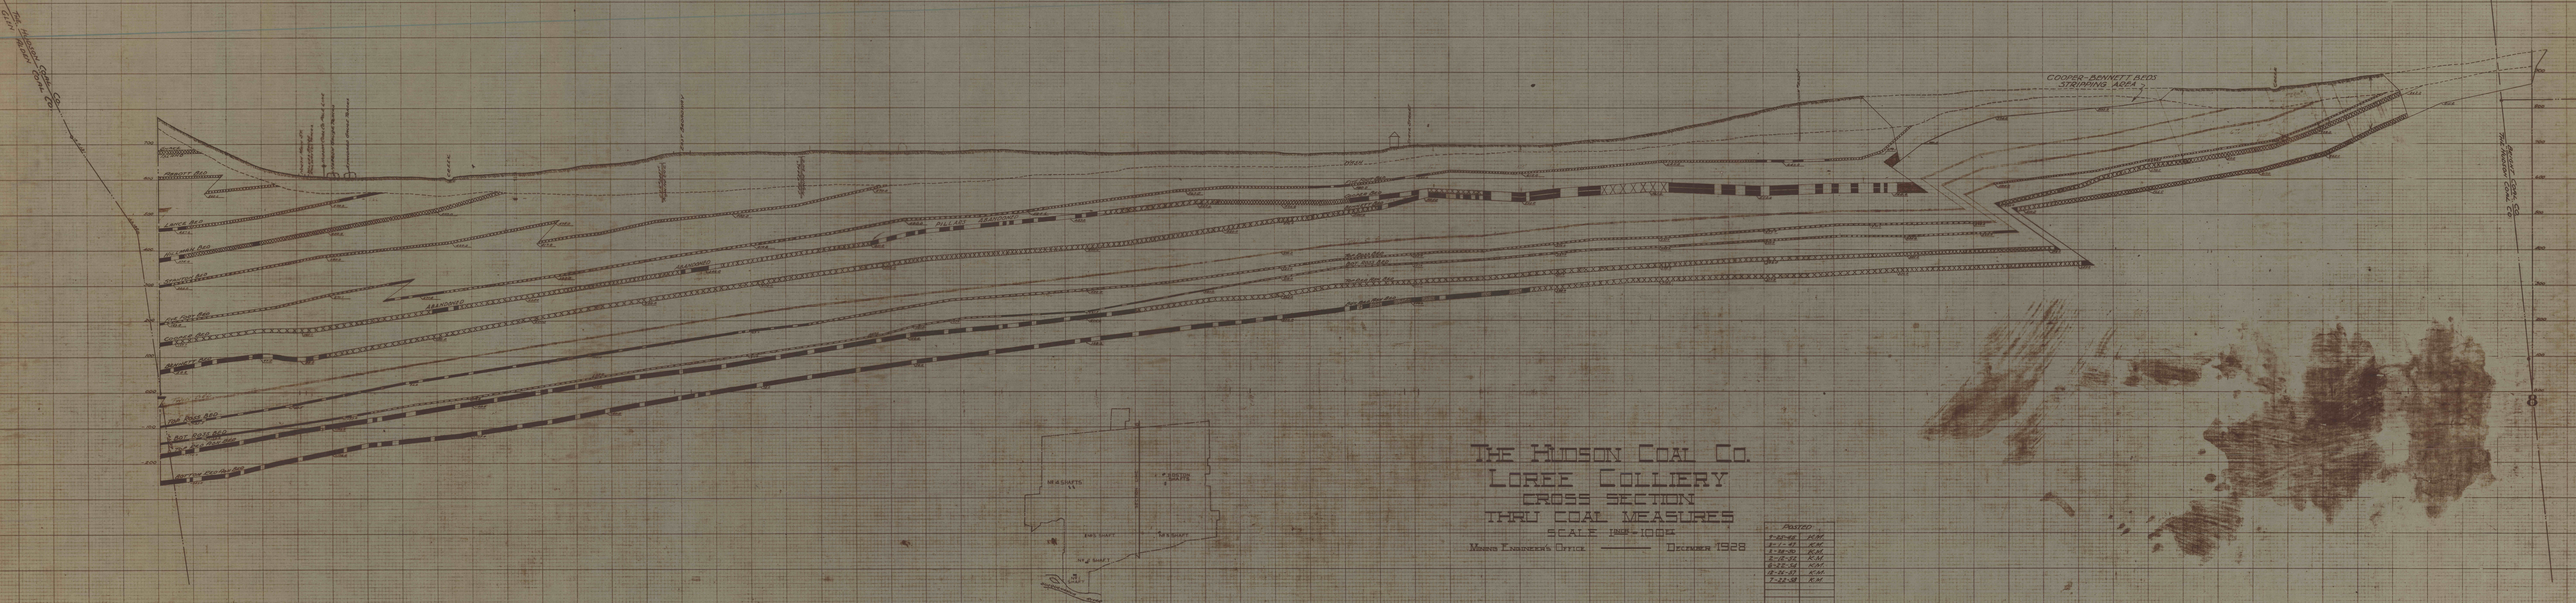
COOPER-BENNETT BEDS
STRIPPING AREA
THE HUDSON COAL CO.
LOREE COLLIERY
CROSS SECTION
THRU COAL MEASURES
SCALE 1"=100'
MINES ENGINEER'S OFFICE
DECEMBER 1928
PATTED
1-10-29 K.M.
1-16-29 K.M.
2-12-29 K.M.
6-12-29 K.M.
12-12-29 K.M.
7-22-38 K.M.
MAIN SHAFTS
FAN SHAFT
FAN SHAFT
THE HUDSON COAL CO.