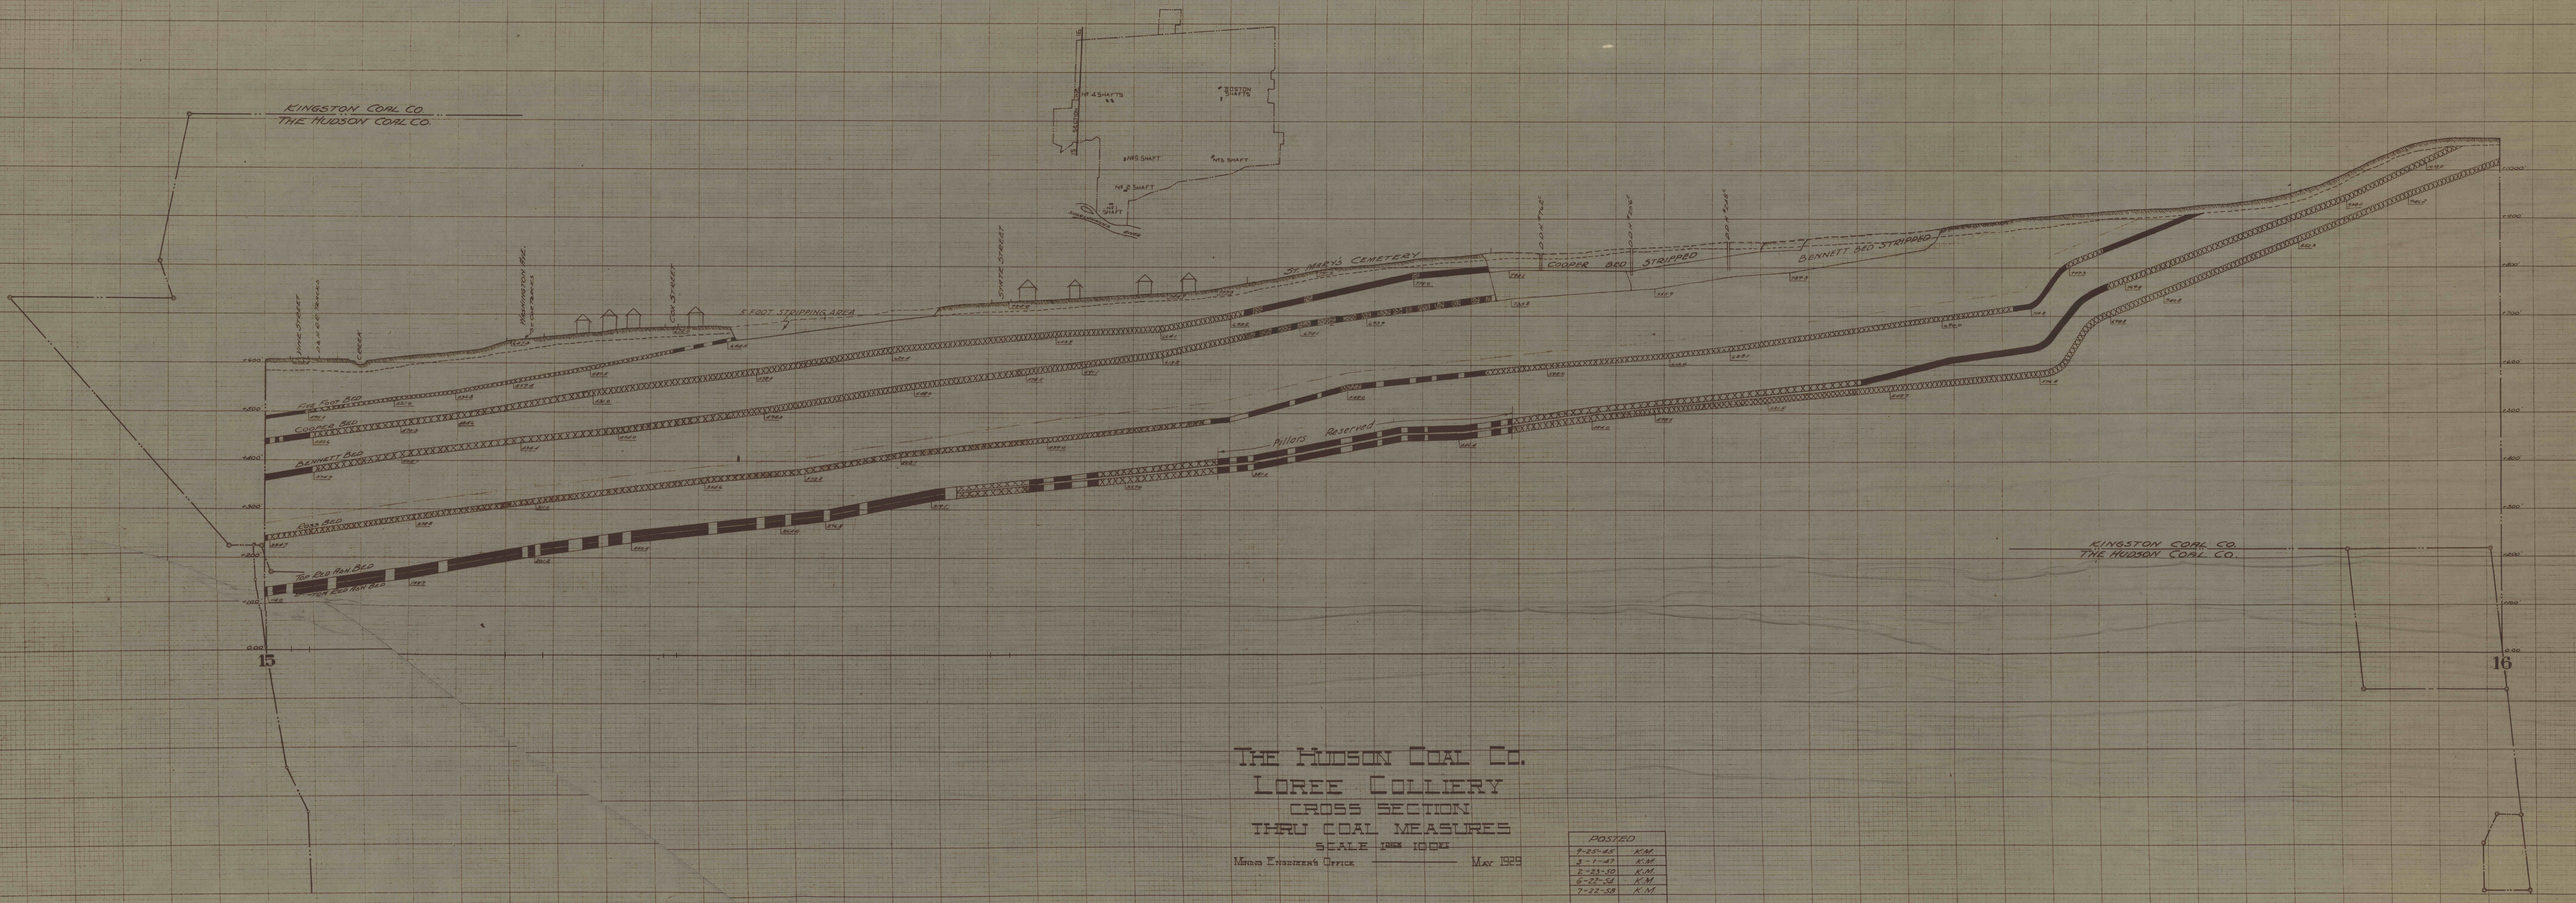

THE HUDSON COAL CO.
LOREE COLLIERY
CROSS SECTION
THRU COAL MEASURES

SCALE 1" = 100'

MINING ENGINEER'S OFFICE — MAY 1929

POSTED	
9-26-45	K.M.
3-1-47	K.M.
2-23-50	K.M.
6-27-51	K.M.
7-22-58	K.M.