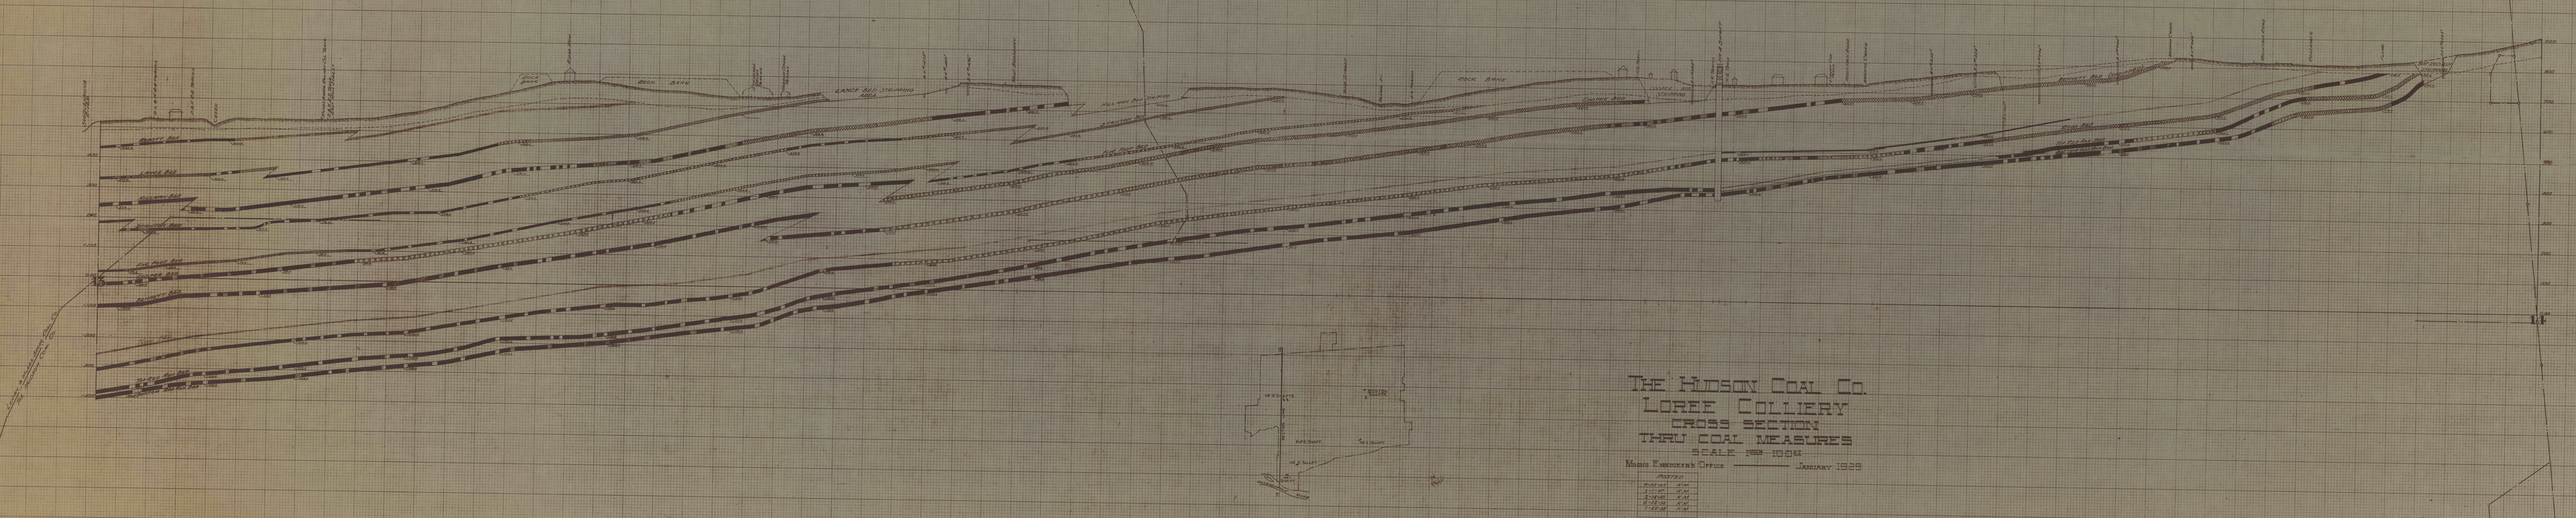
THE HUDSON COAL CO.
LOREE COLLIERY
CROSS SECTION
THRU COAL MEASURES
SCALE 1" = 100'
MINING ENGINEERS OFFICE
JANUARY 1939