


DATE OF LAST SURVEY POSTED

No. 3 Shaft	By
First	Who
When	
2-27	P.S.
10-21	P.S.
1-13	P.S.

Original was checked with Tom Corbin Records 2-1-32

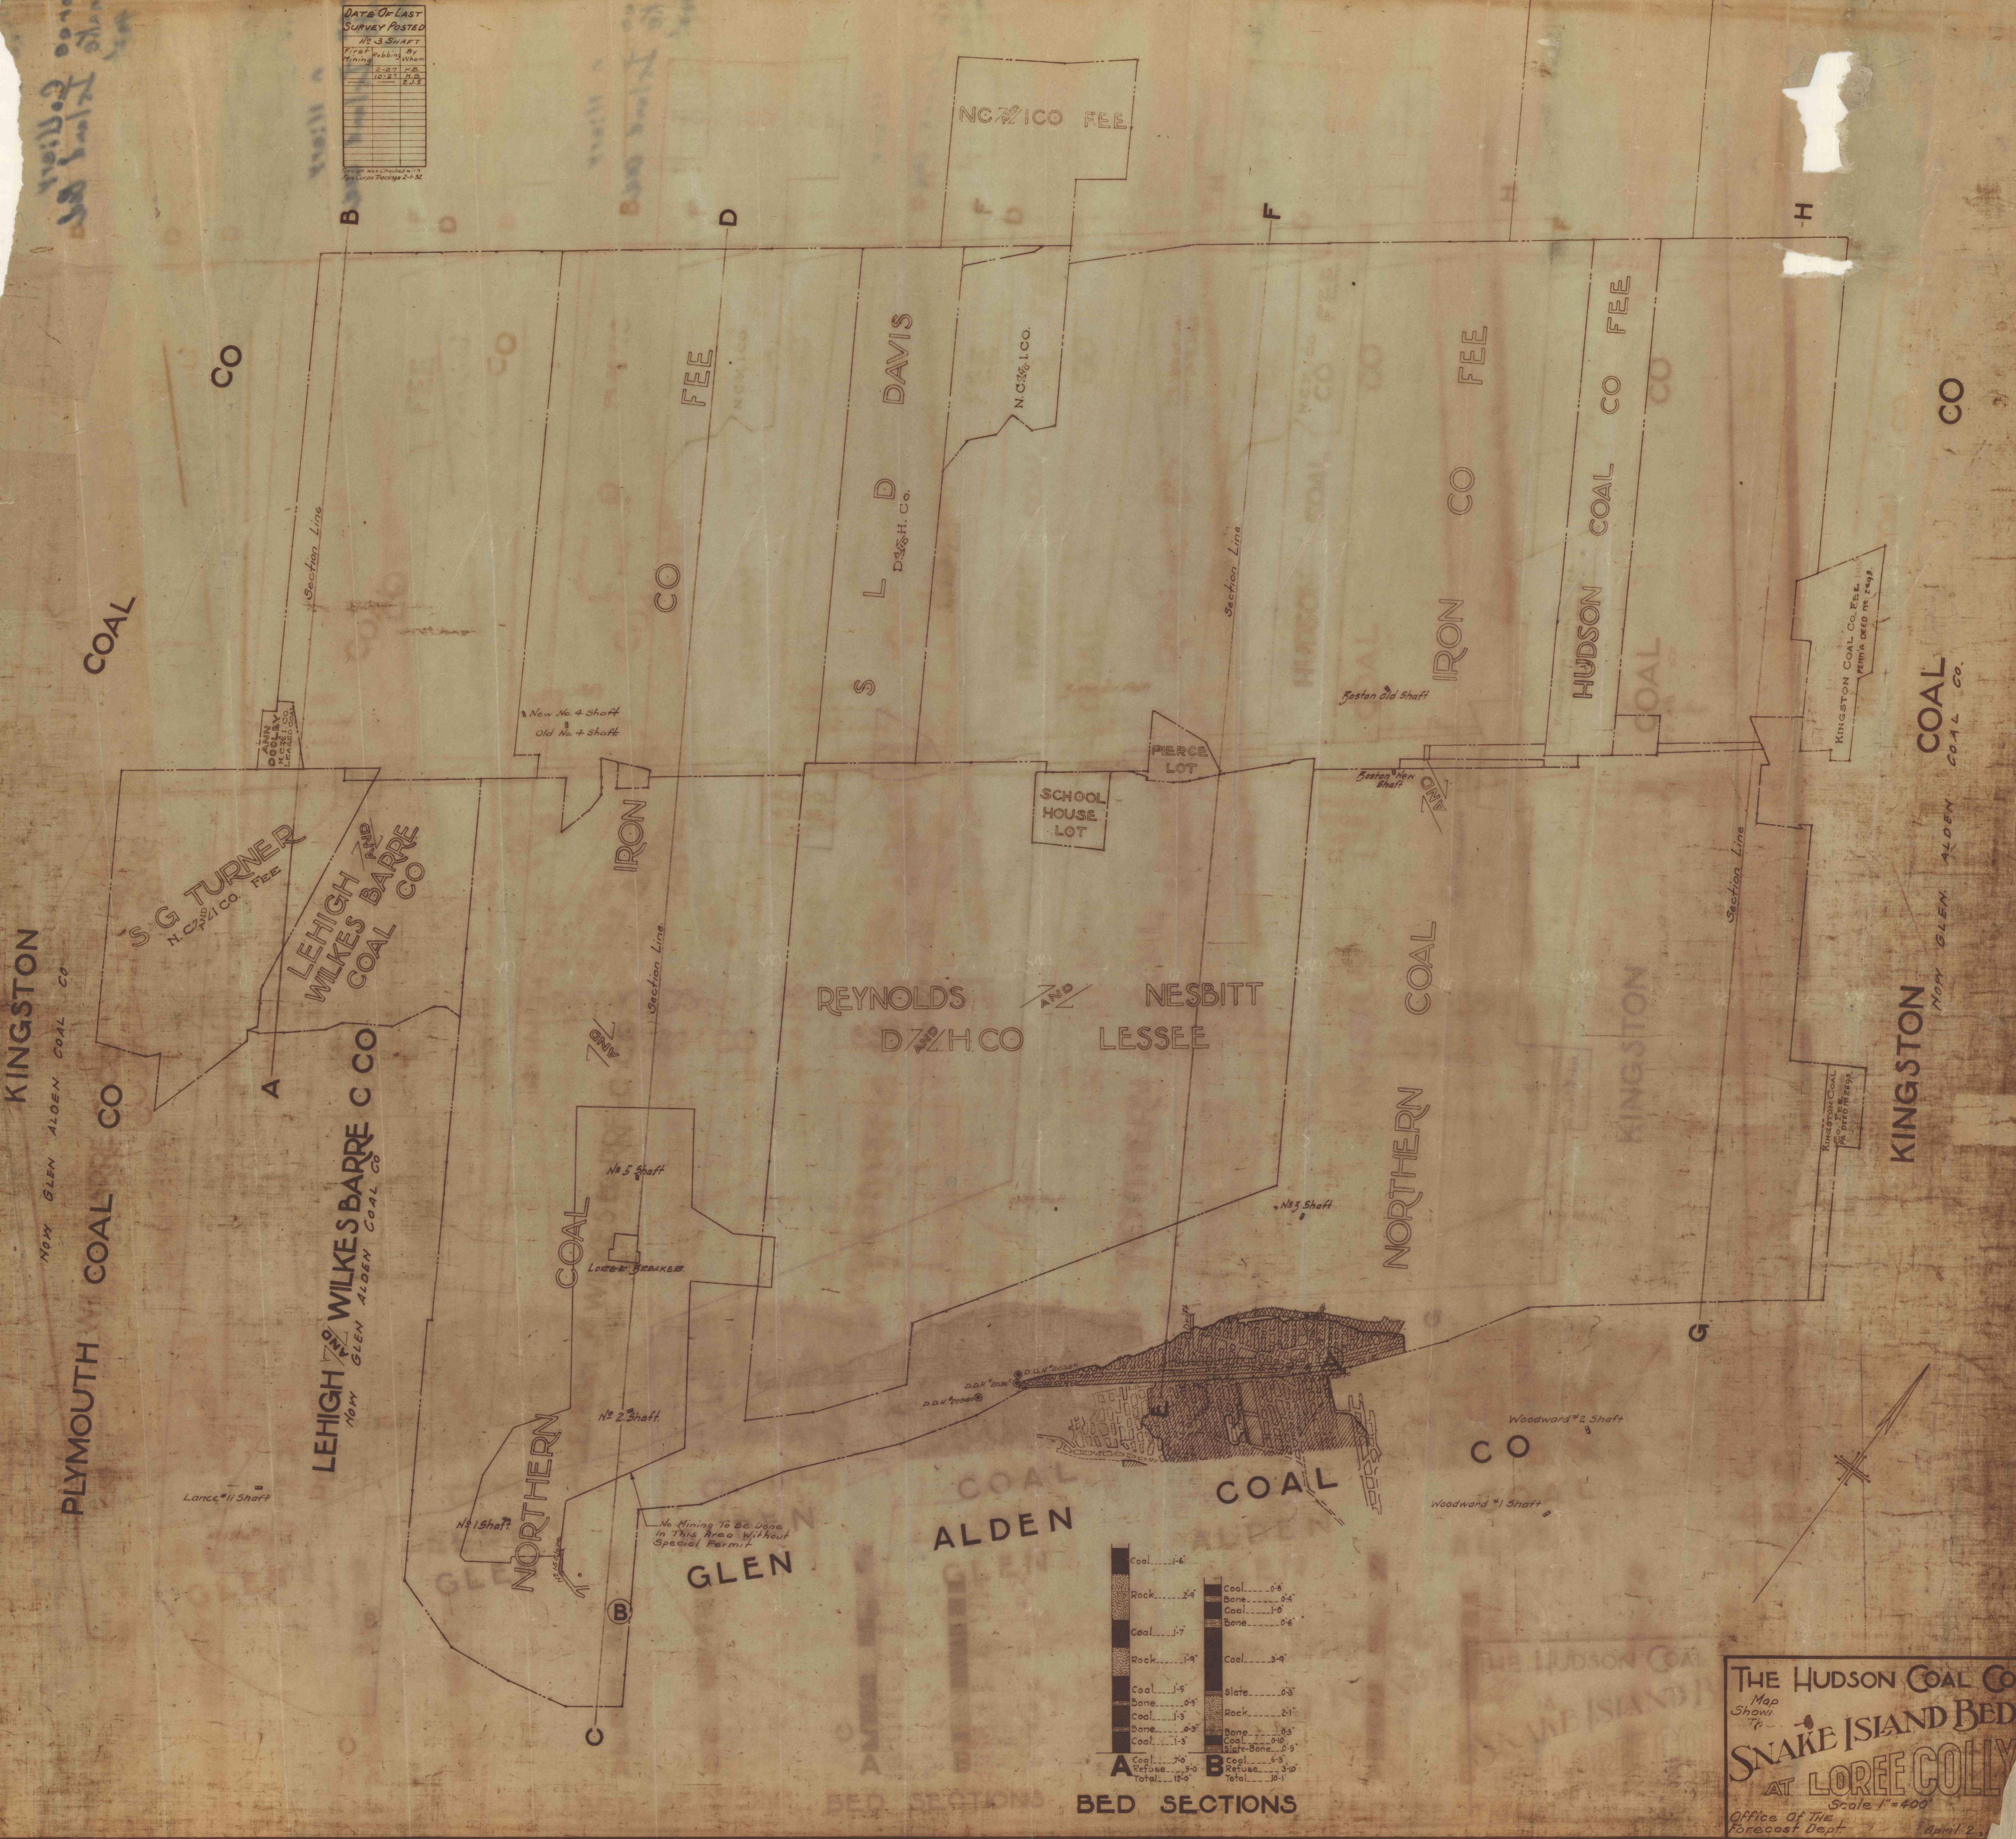

A

Coal	1-6
Rock	2-9
Coal	1-7
Rock	1-9
Coal	1-5
Bone	0-3
Coal	1-3
Bone	0-5
Coal	1-3
Coal	7-0
Refuse	3-10
Total	12-0

B

Coal	0-8
Bone	0-4
Coal	1-0
Bone	0-6
Coal	3-9
Slate	0-3
Rock	2-1
Coal	0-3
Coal	0-0
Slate-Bone	0-5
Coal	6-3
Refuse	3-10
Total	30-1

THE HUDSON COAL CO.
Map
Shows
The
Snake Island Bed
AT LOREE COLLY
Scale 1" = 400'
Office of the
Forecast Dept.
April 2, 1902