


DATE OF LAST SURVEY POSTED

NO. OF CHAS.	NO. OF SURV.	NO. OF CHAS.	NO. OF SURV.	NO. OF CHAS.	NO. OF SURV.	NO. OF CHAS.	NO. OF SURV.
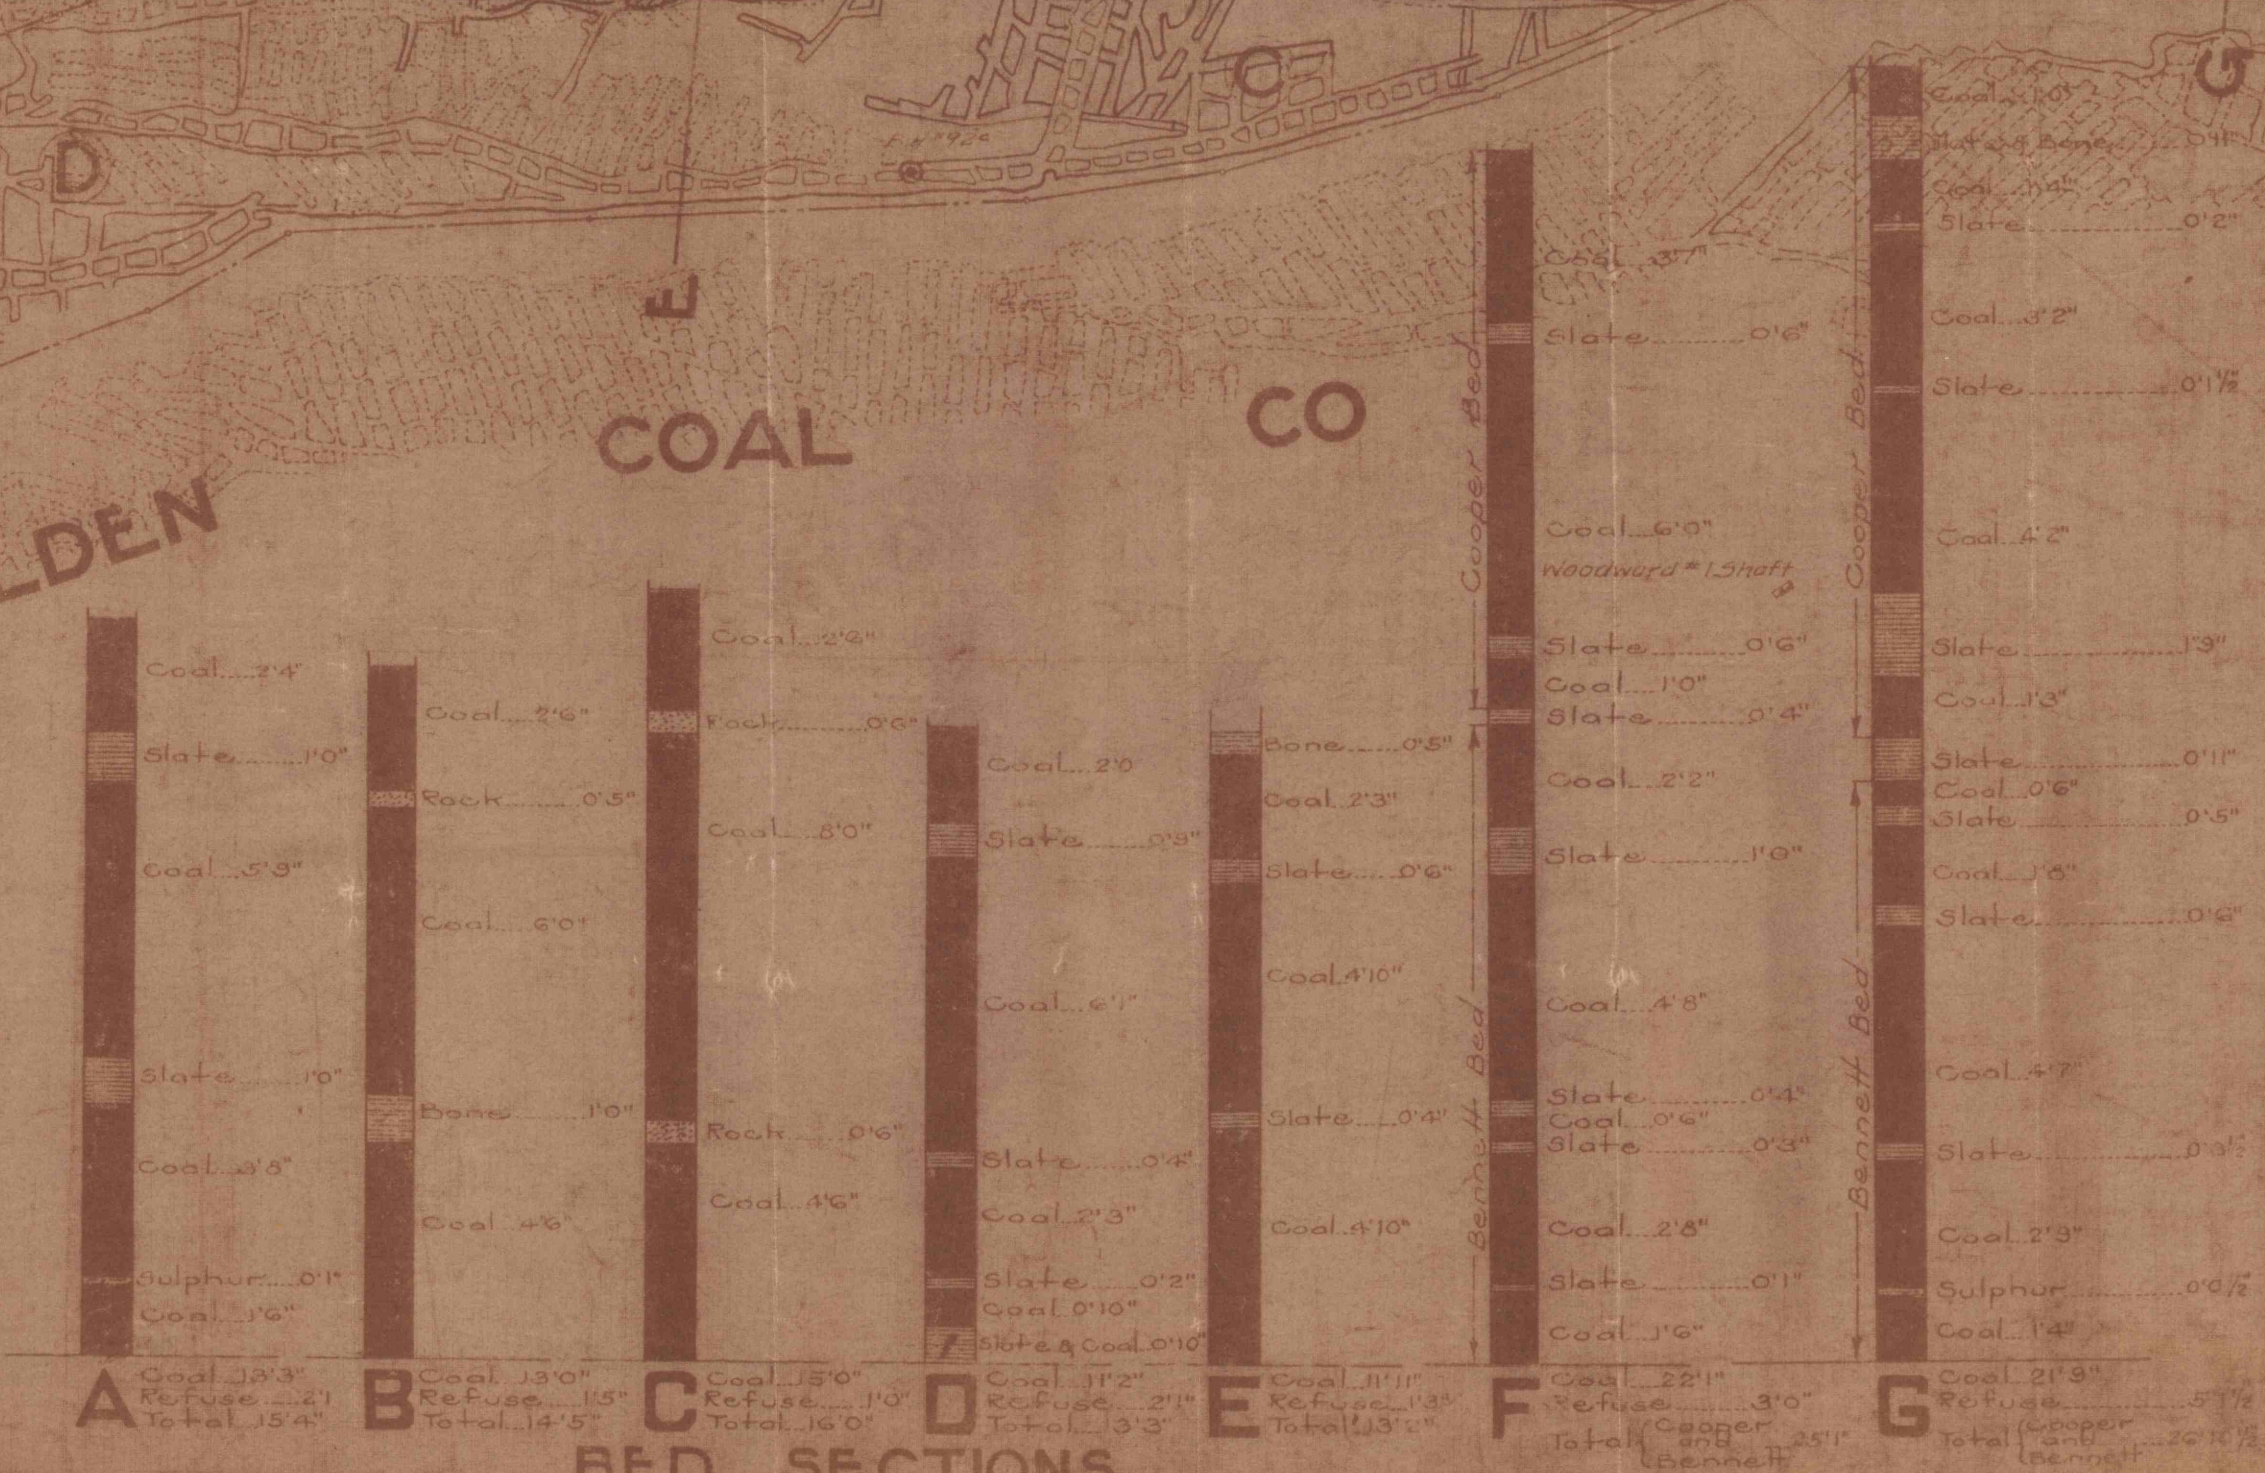

THE HUDSON COAL CO
 Map Showing The
BENNETT BED
 AT LOREE COLLY
 Office of the
 Forecast Dept.