
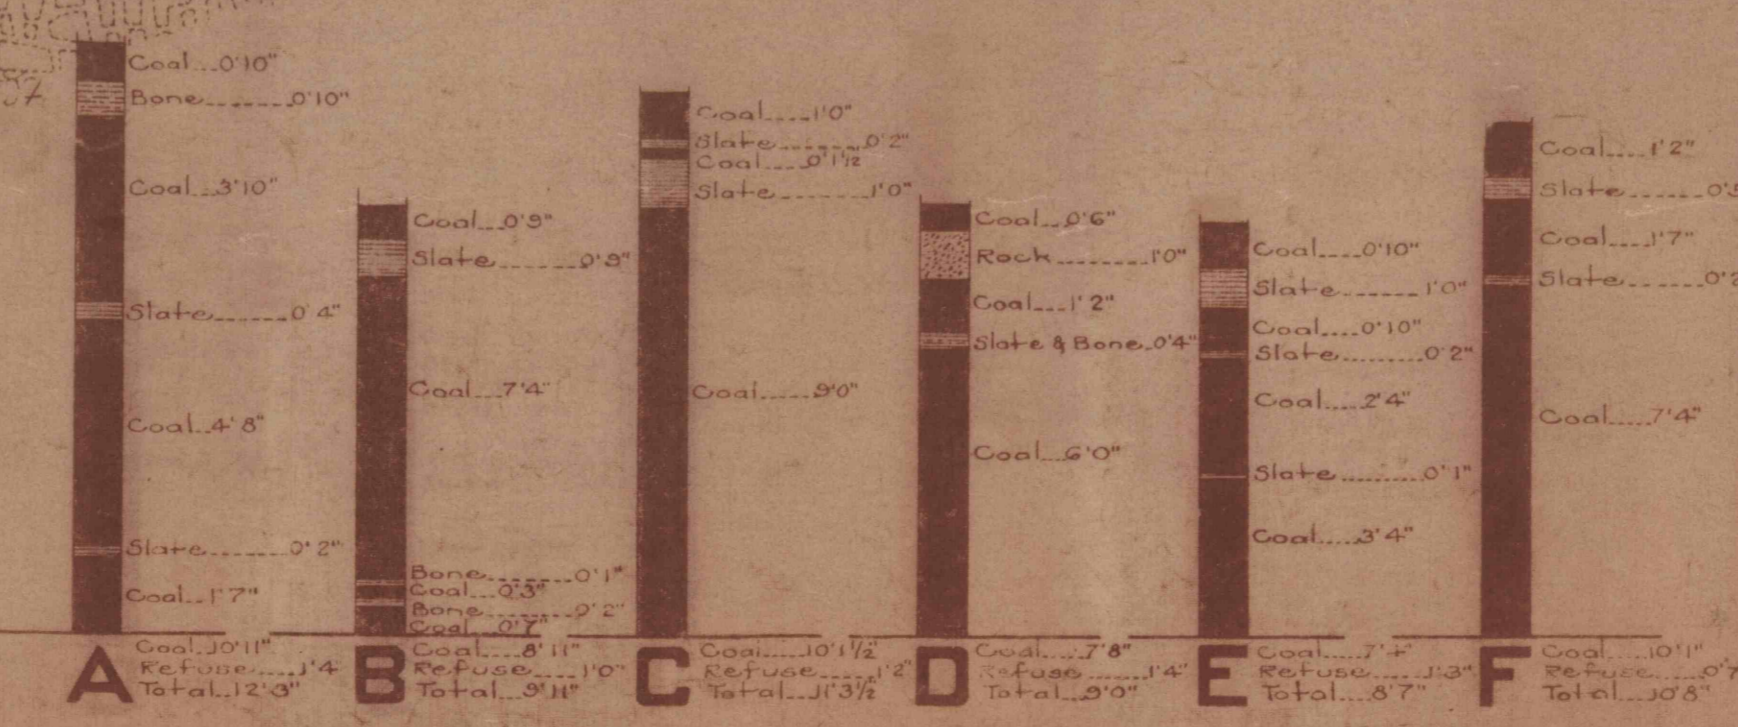


DATE OF LAST SURVEY POSTED

NO 2 SHAFT		NO 3 SHAFT		NO 3 SHAFT		BOSTON	
First	By	First	By	First	By	First	By

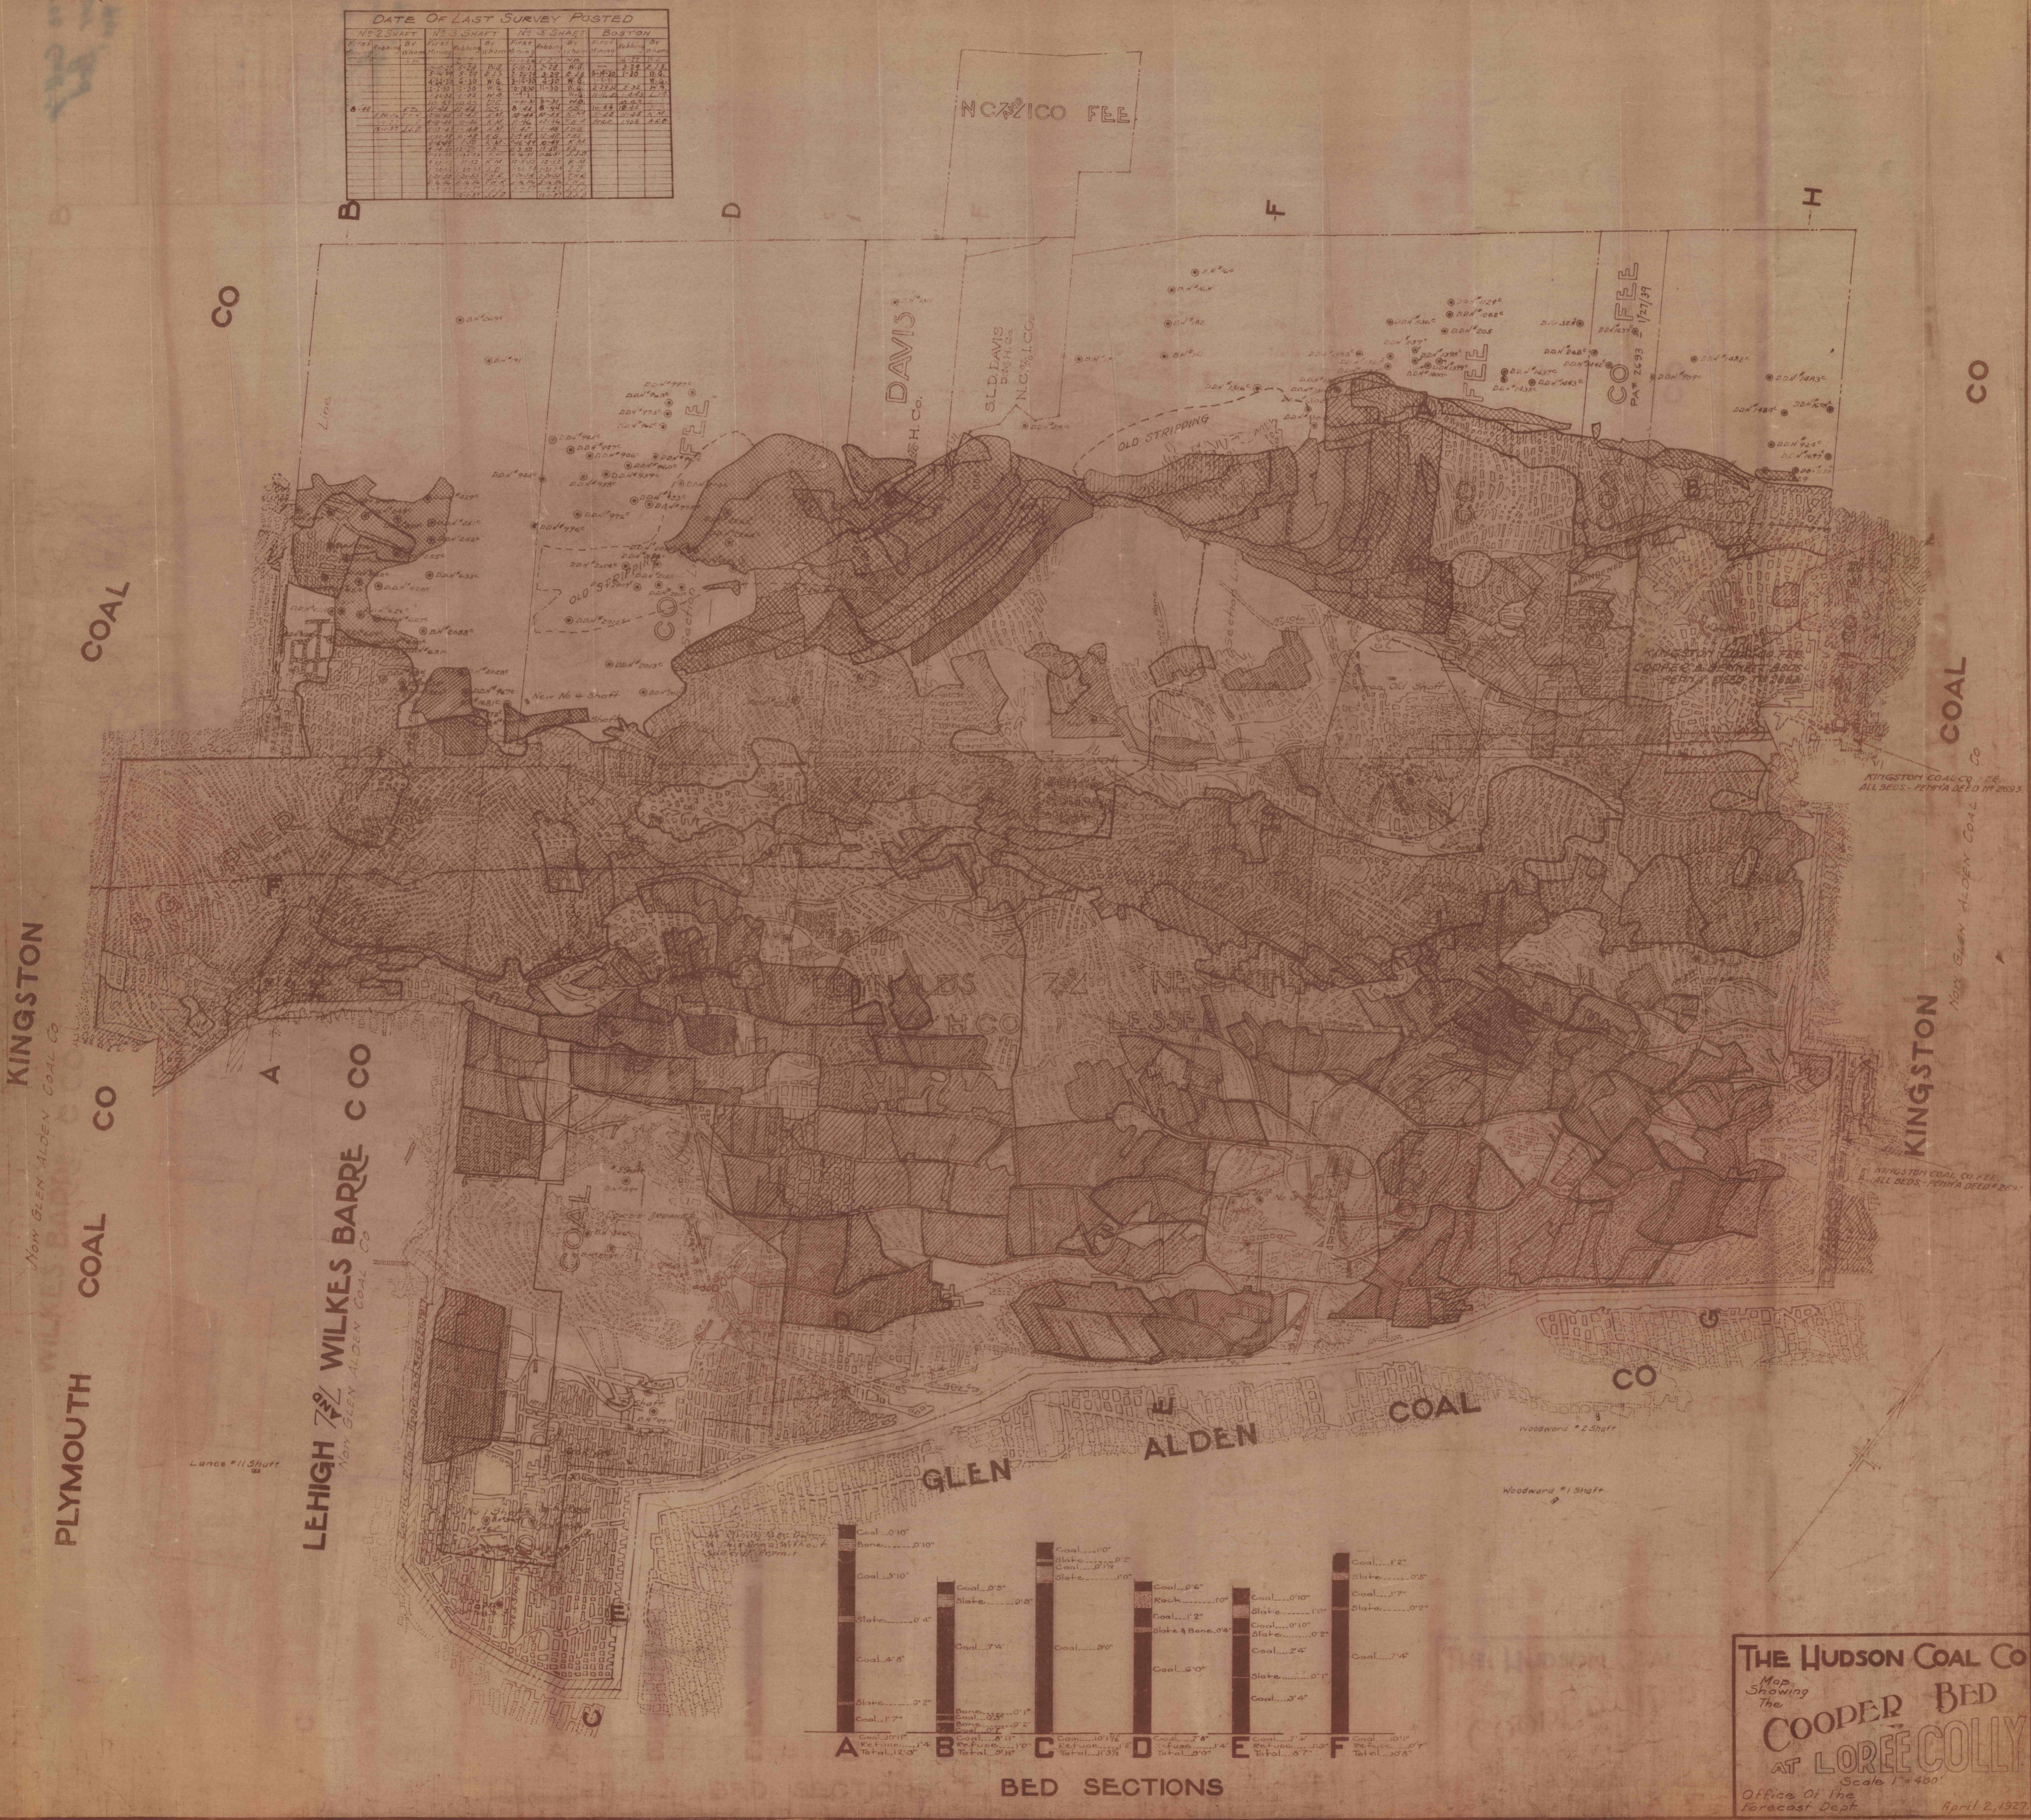

THE HUDSON COAL CO
 Map Showing The
COOPER BED
 AT LOREE COLLY
 Scale 1" = 400'
 Office of the
 Forecast Dept
 April 2, 1921