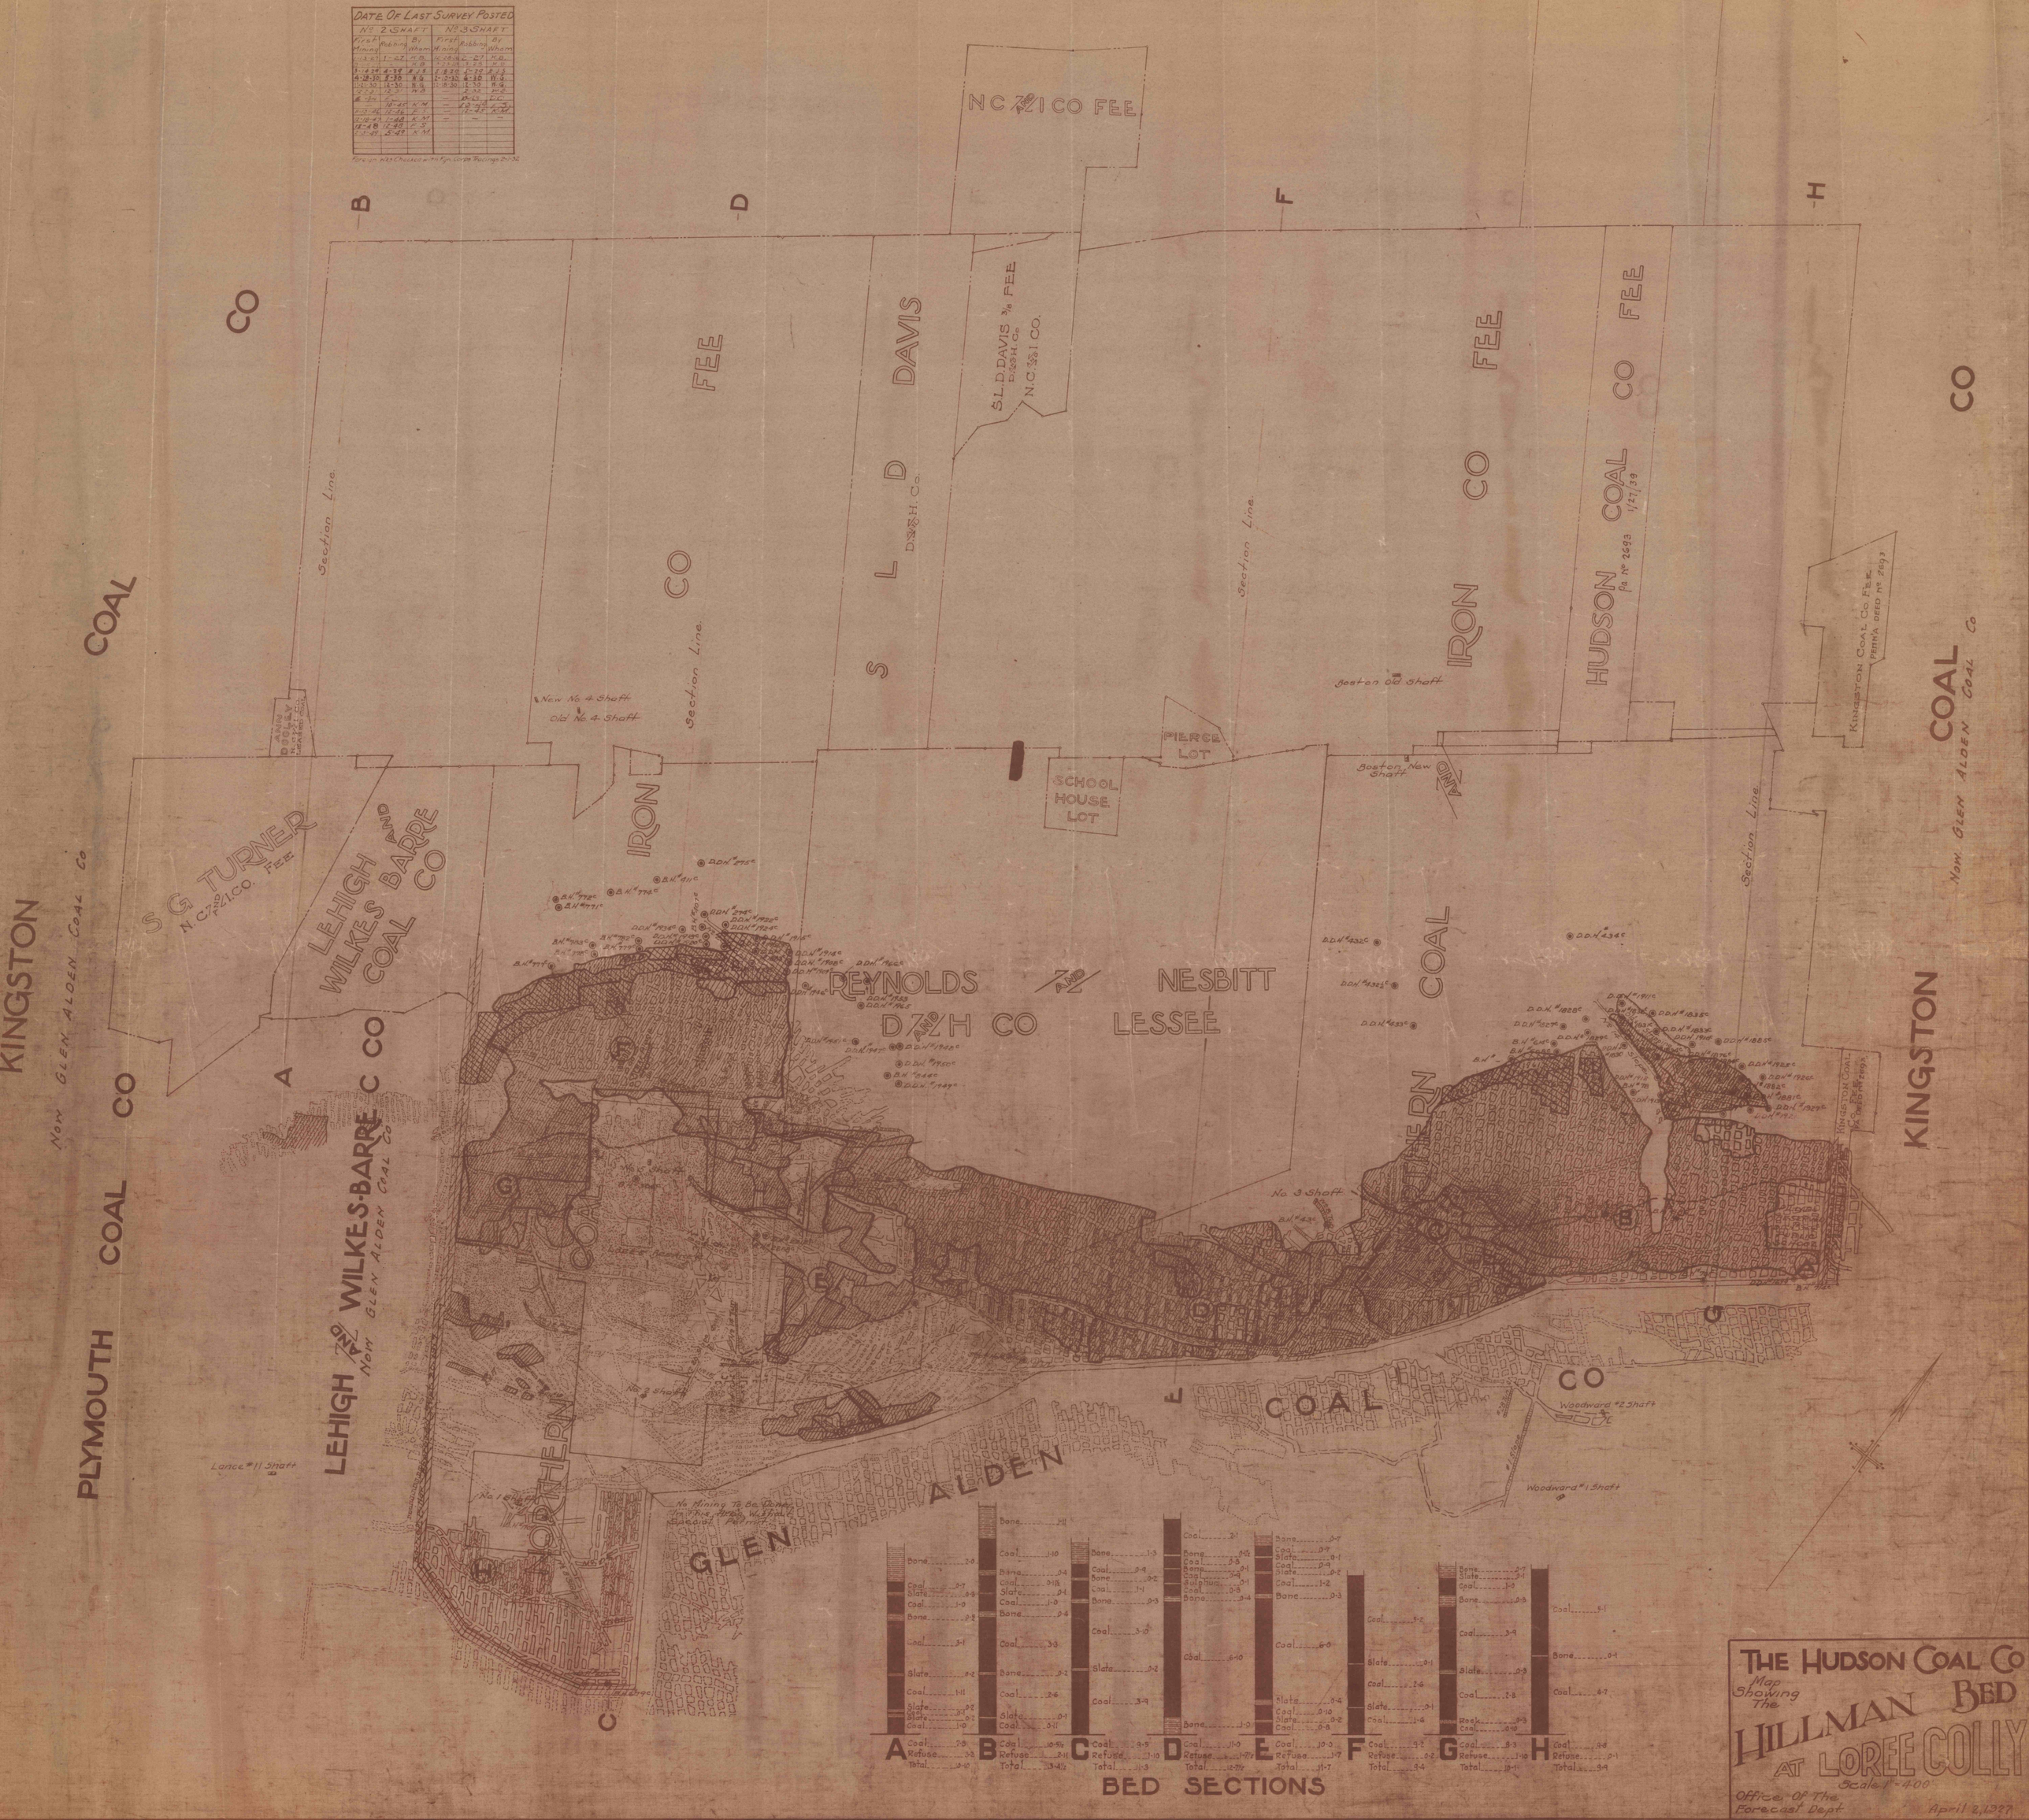

DATE OF LAST SURVEY POSTED
No 2 SHAFT
No 3 SHAFT
First Mining
Robbing
By Wham
NC 7/21 CO FEE
S L D DAVIS
S.L.D. DAVIS 3/8 FEE
N.C. 7/21 CO.
IRON CO FEE
HUDSON COAL CO FEE
KINGSTON COAL CO
PLYMOUTH COAL CO
LEHIGH AND WILKES-BARRE COAL CO
NORTHERN COAL
GLEN ALDEN COAL CO
REYNOLDS AND NESBITT
D 7/21 H CO LESSEE
SCHOOL HOUSE LOT
PIERCE LOT
Section Line
New No. 4 Shaft
Old No. 4 Shaft
Boston Old Shaft
Boston New Shaft
No. 3 Shaft
Woodward #2 Shaft
Woodward #1 Shaft
Lance #11 Shaft
No Mining To Be Done In This Area Without Special Permit
BED SECTIONS
THE HUDSON COAL CO
Map Showing The
HILLMAN BED
AT LOREE COLLY
Scale 1" = 400'
Office Of The Forecast Dept
April 2, 1927