


DATE OF LAST SURVEY POSTED

NO 2 SHAFT		NO 3 SHAFT		NO 4 SHAFT		NO 5 SHAFT		BOSTON	

NCZICO FEE
4-19-28 W.T. Payne lessee for 20 yrs.

NCZICO FEE COAL
4-19-28 W.T. Payne lessee 1/2 and coal term of 20 years

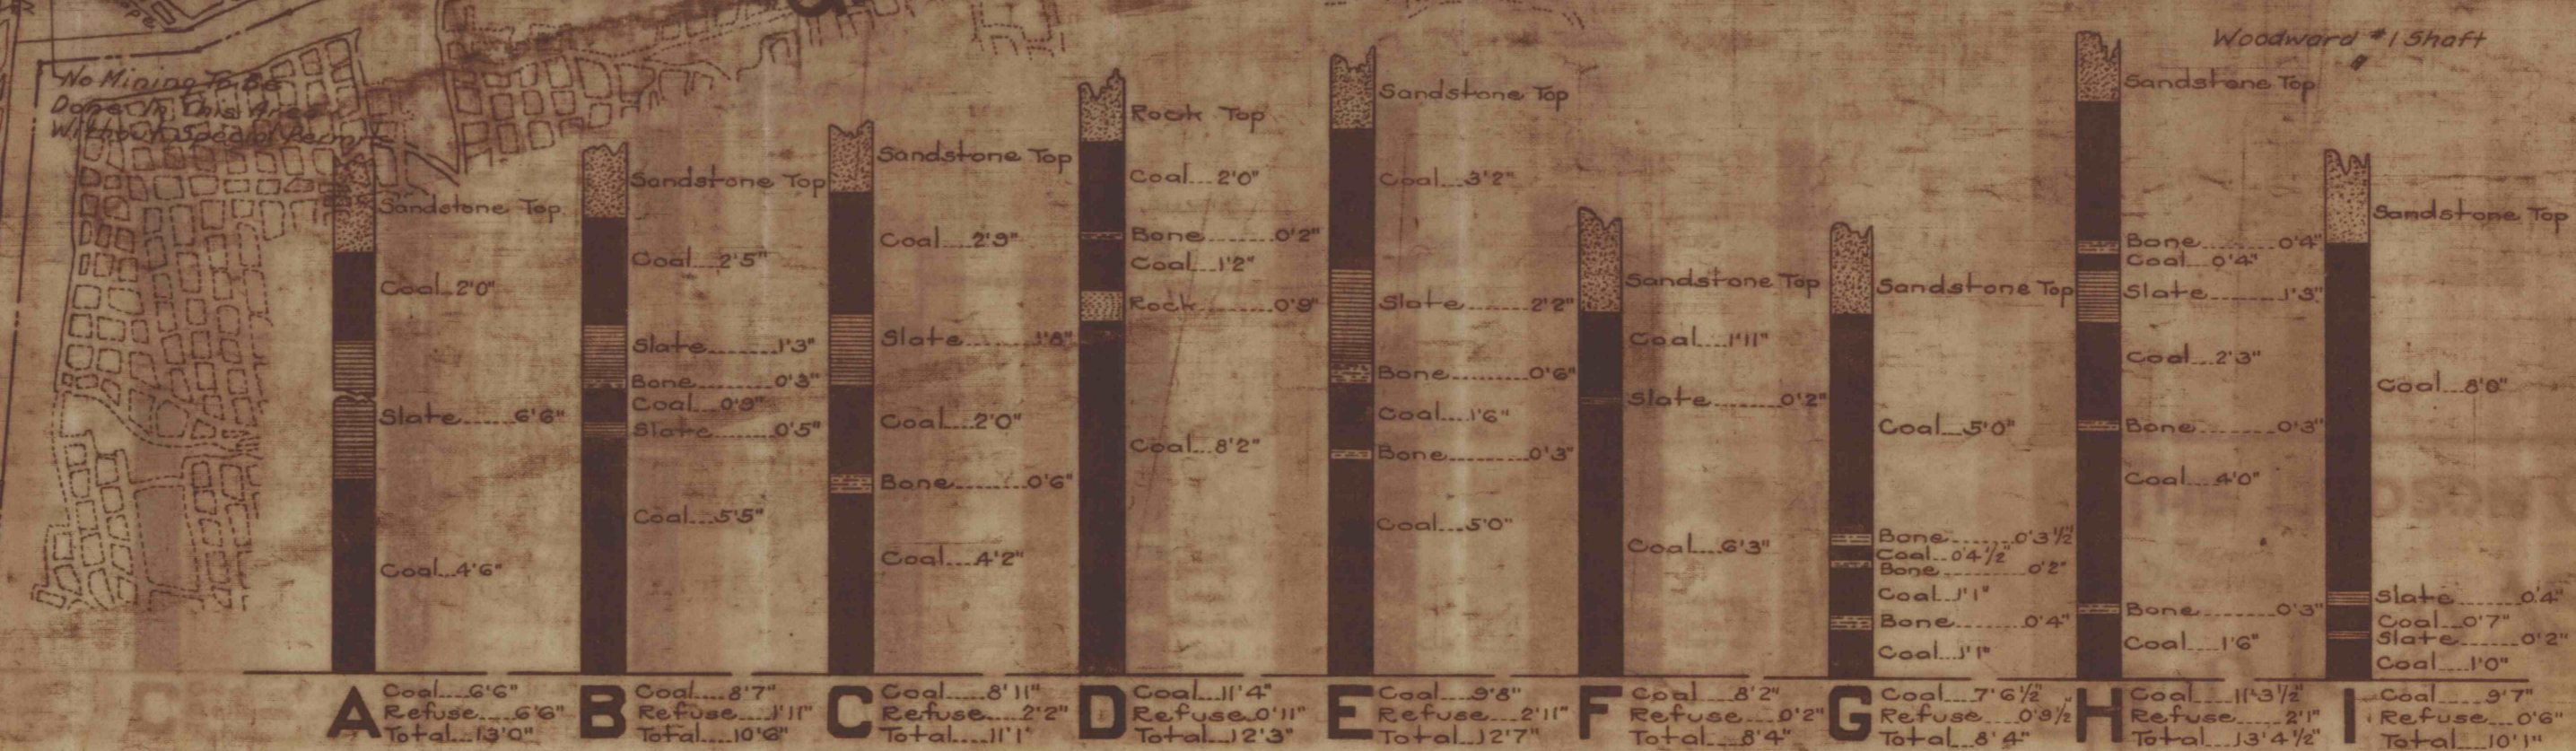

THE HUDSON COAL CO
Map Showing The
TOP RED ASH BED
AT LOREE COLLY
Scale 1"=400'
Office of The Forecast Dept.
April 2, 1900