
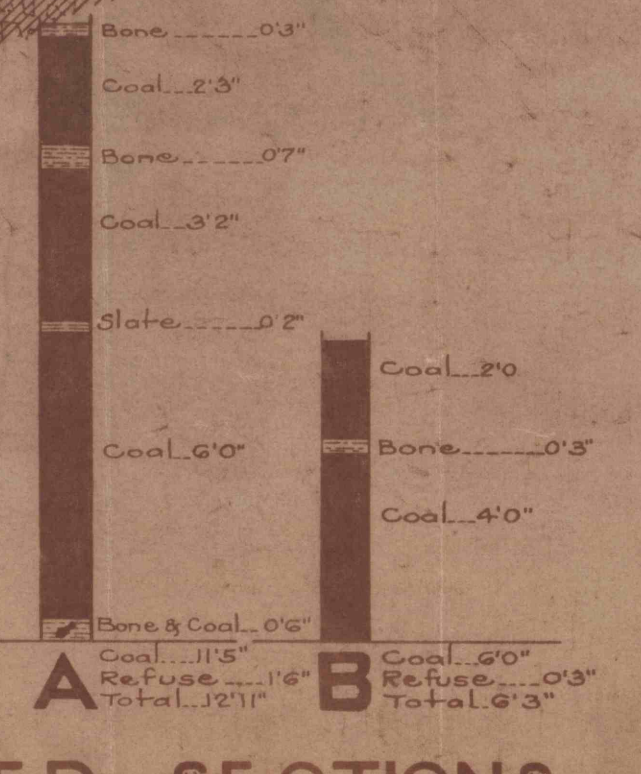


DATE OF LAST SURVEY POSTED

NO. 2 SHAFT	
First Reading	By
11.25	W. G.
12.27	W. G.
1.28	W. G.
2.30	W. G.
3.30	W. G.
4.30	W. G.
5.30	W. G.
6.30	W. G.
7.30	W. G.
8.30	W. G.
9.30	W. G.
10.30	W. G.
11.30	W. G.
12.30	W. G.

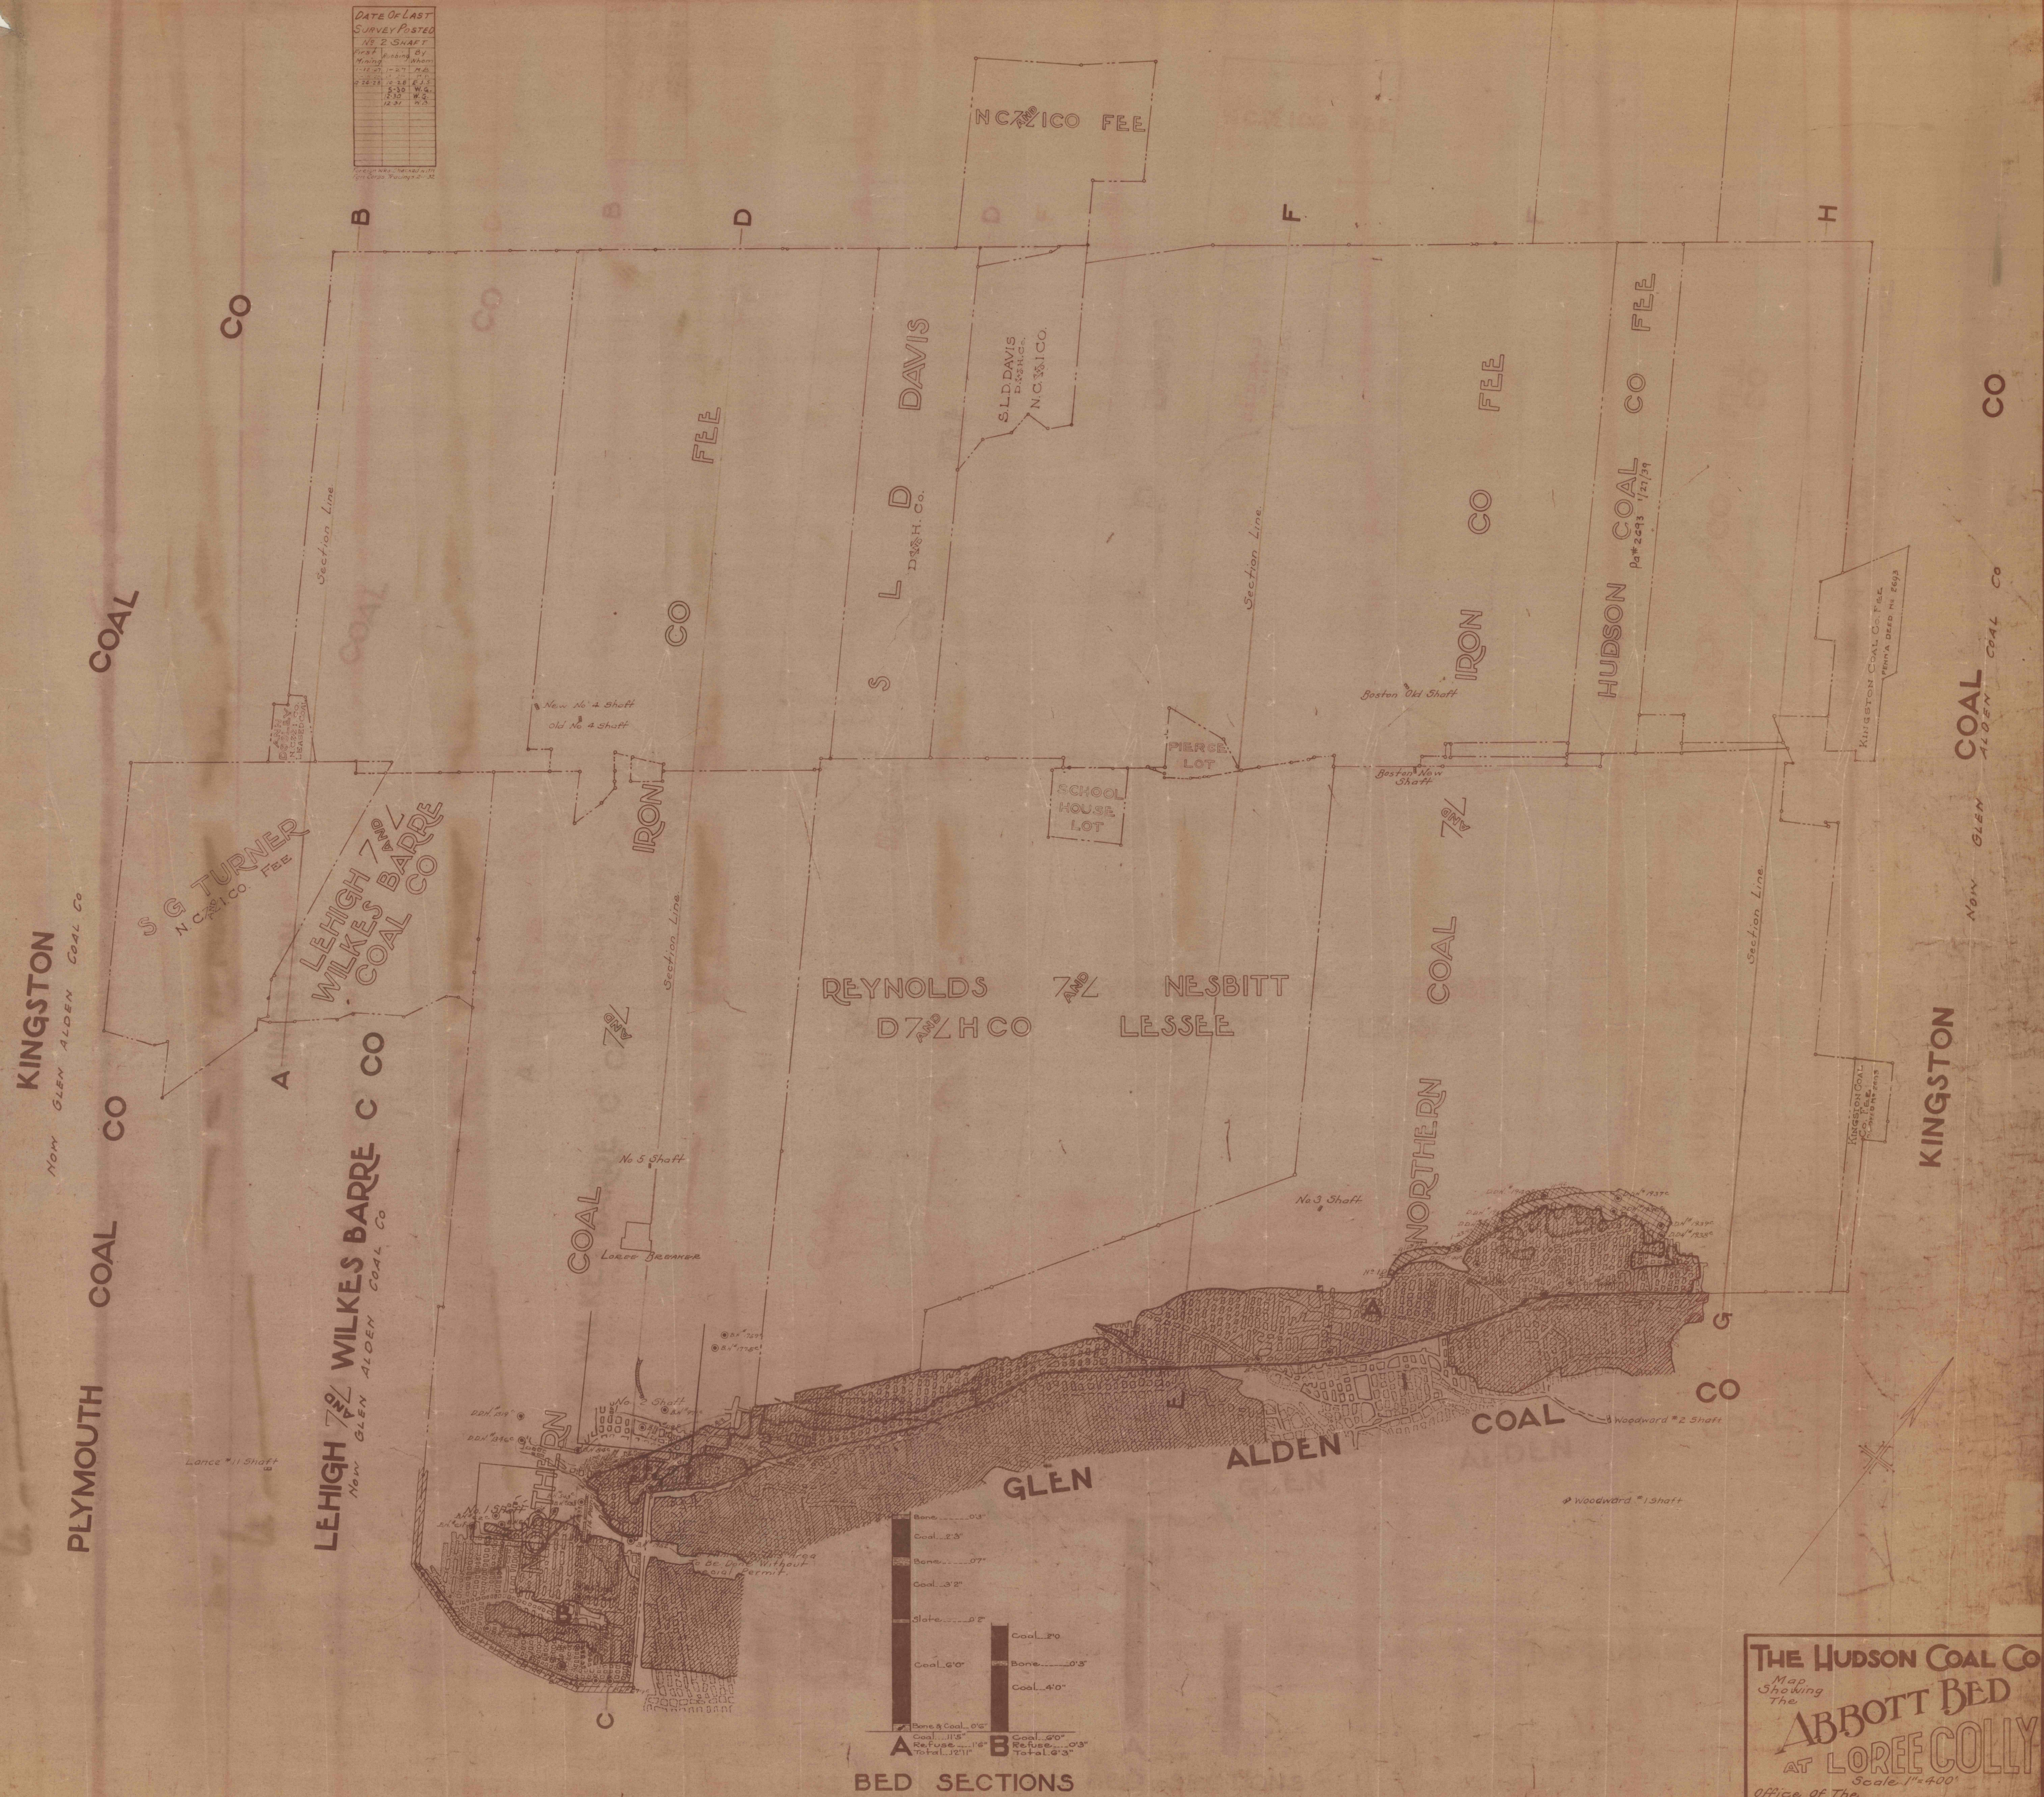

BED SECTIONS

THE HUDSON COAL CO
Map Showing The
ABBOTT BED
AT LOREE COLLY
Scale 1"=400'
Office of The Forecast Dept
April 2, 1921