
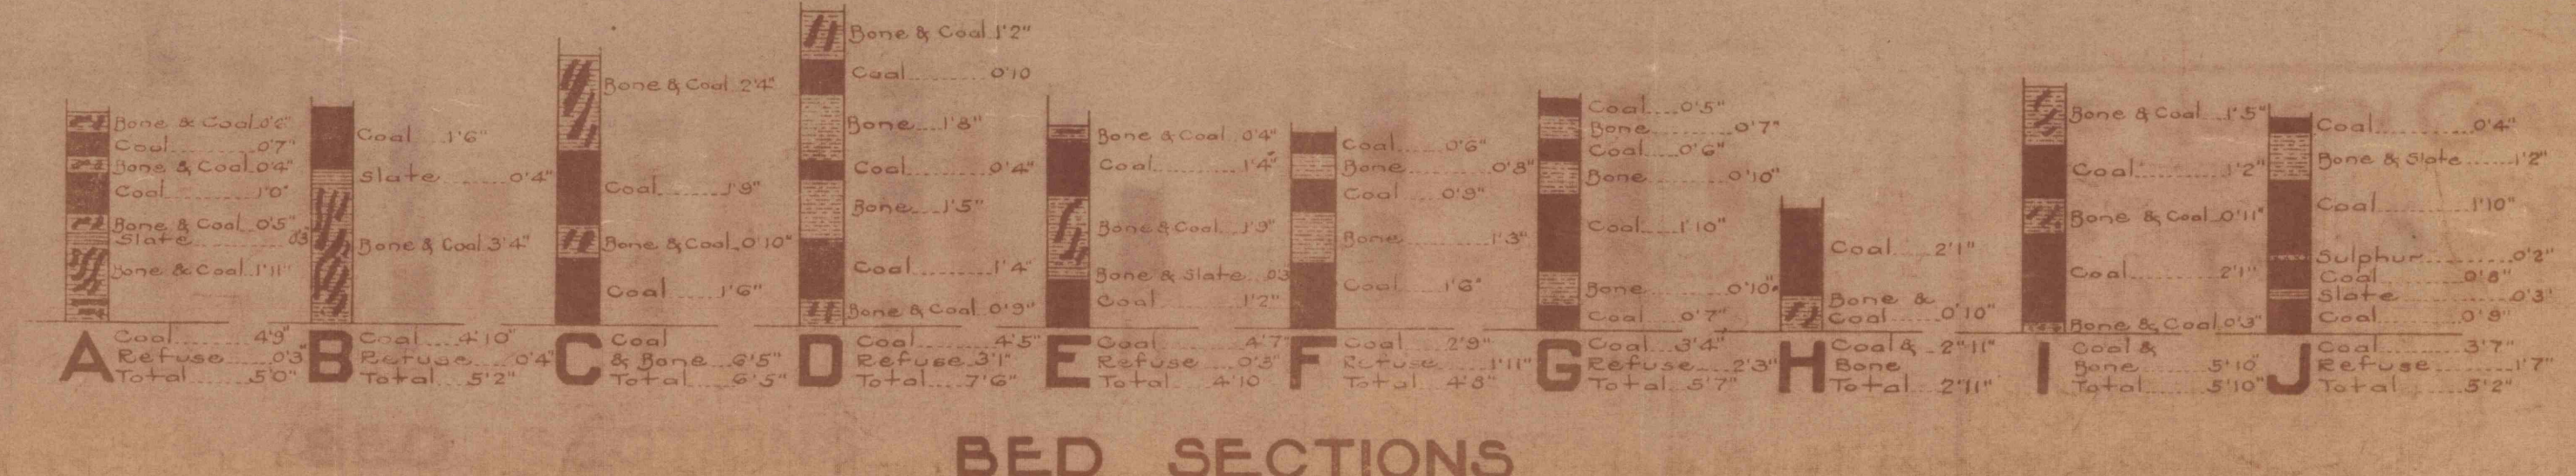


DATE OF LAST SURVEY POSTED

NO 1 SHAFTE	NO 3 SHAFTE	NO 4 SHAFTE	NO 5 SHAFTE	BOSTON

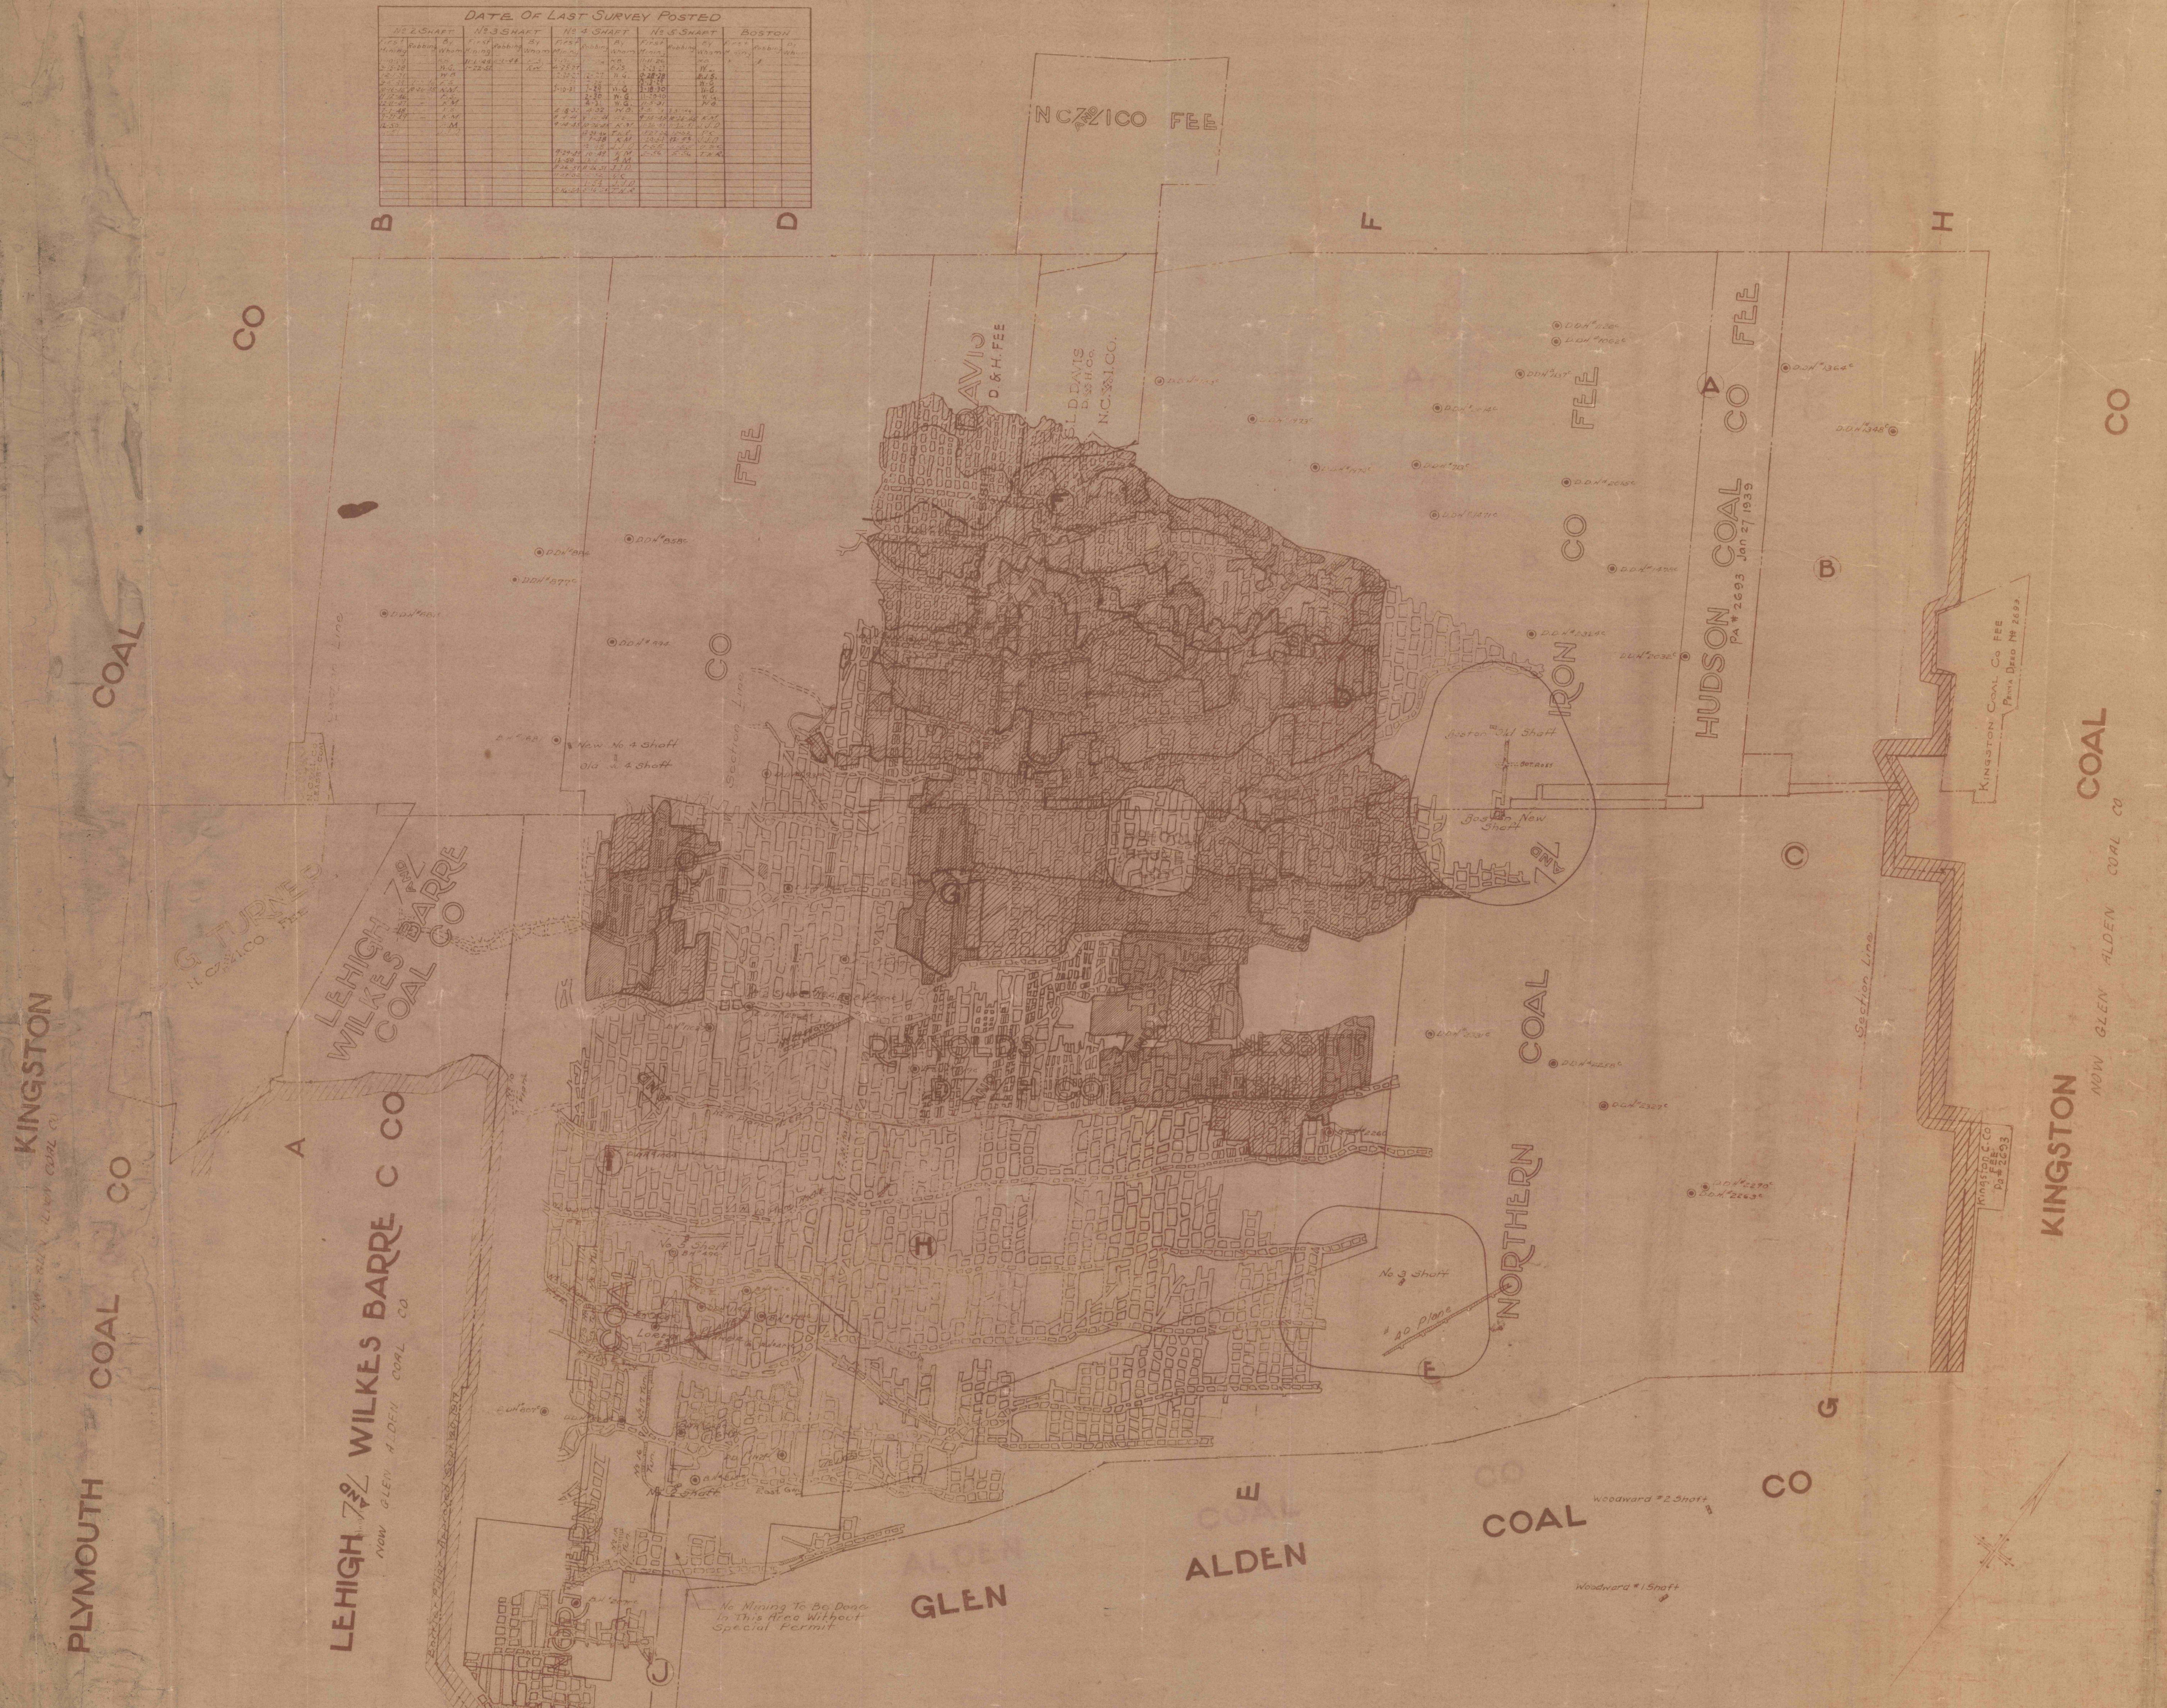

**THE HUDSON COAL CO**  
Map Showing The **ROSS BED** AT LOREE COLLY  
Scale 1" = 400'  
Office Of The Forecast Dept. April 2, 1935