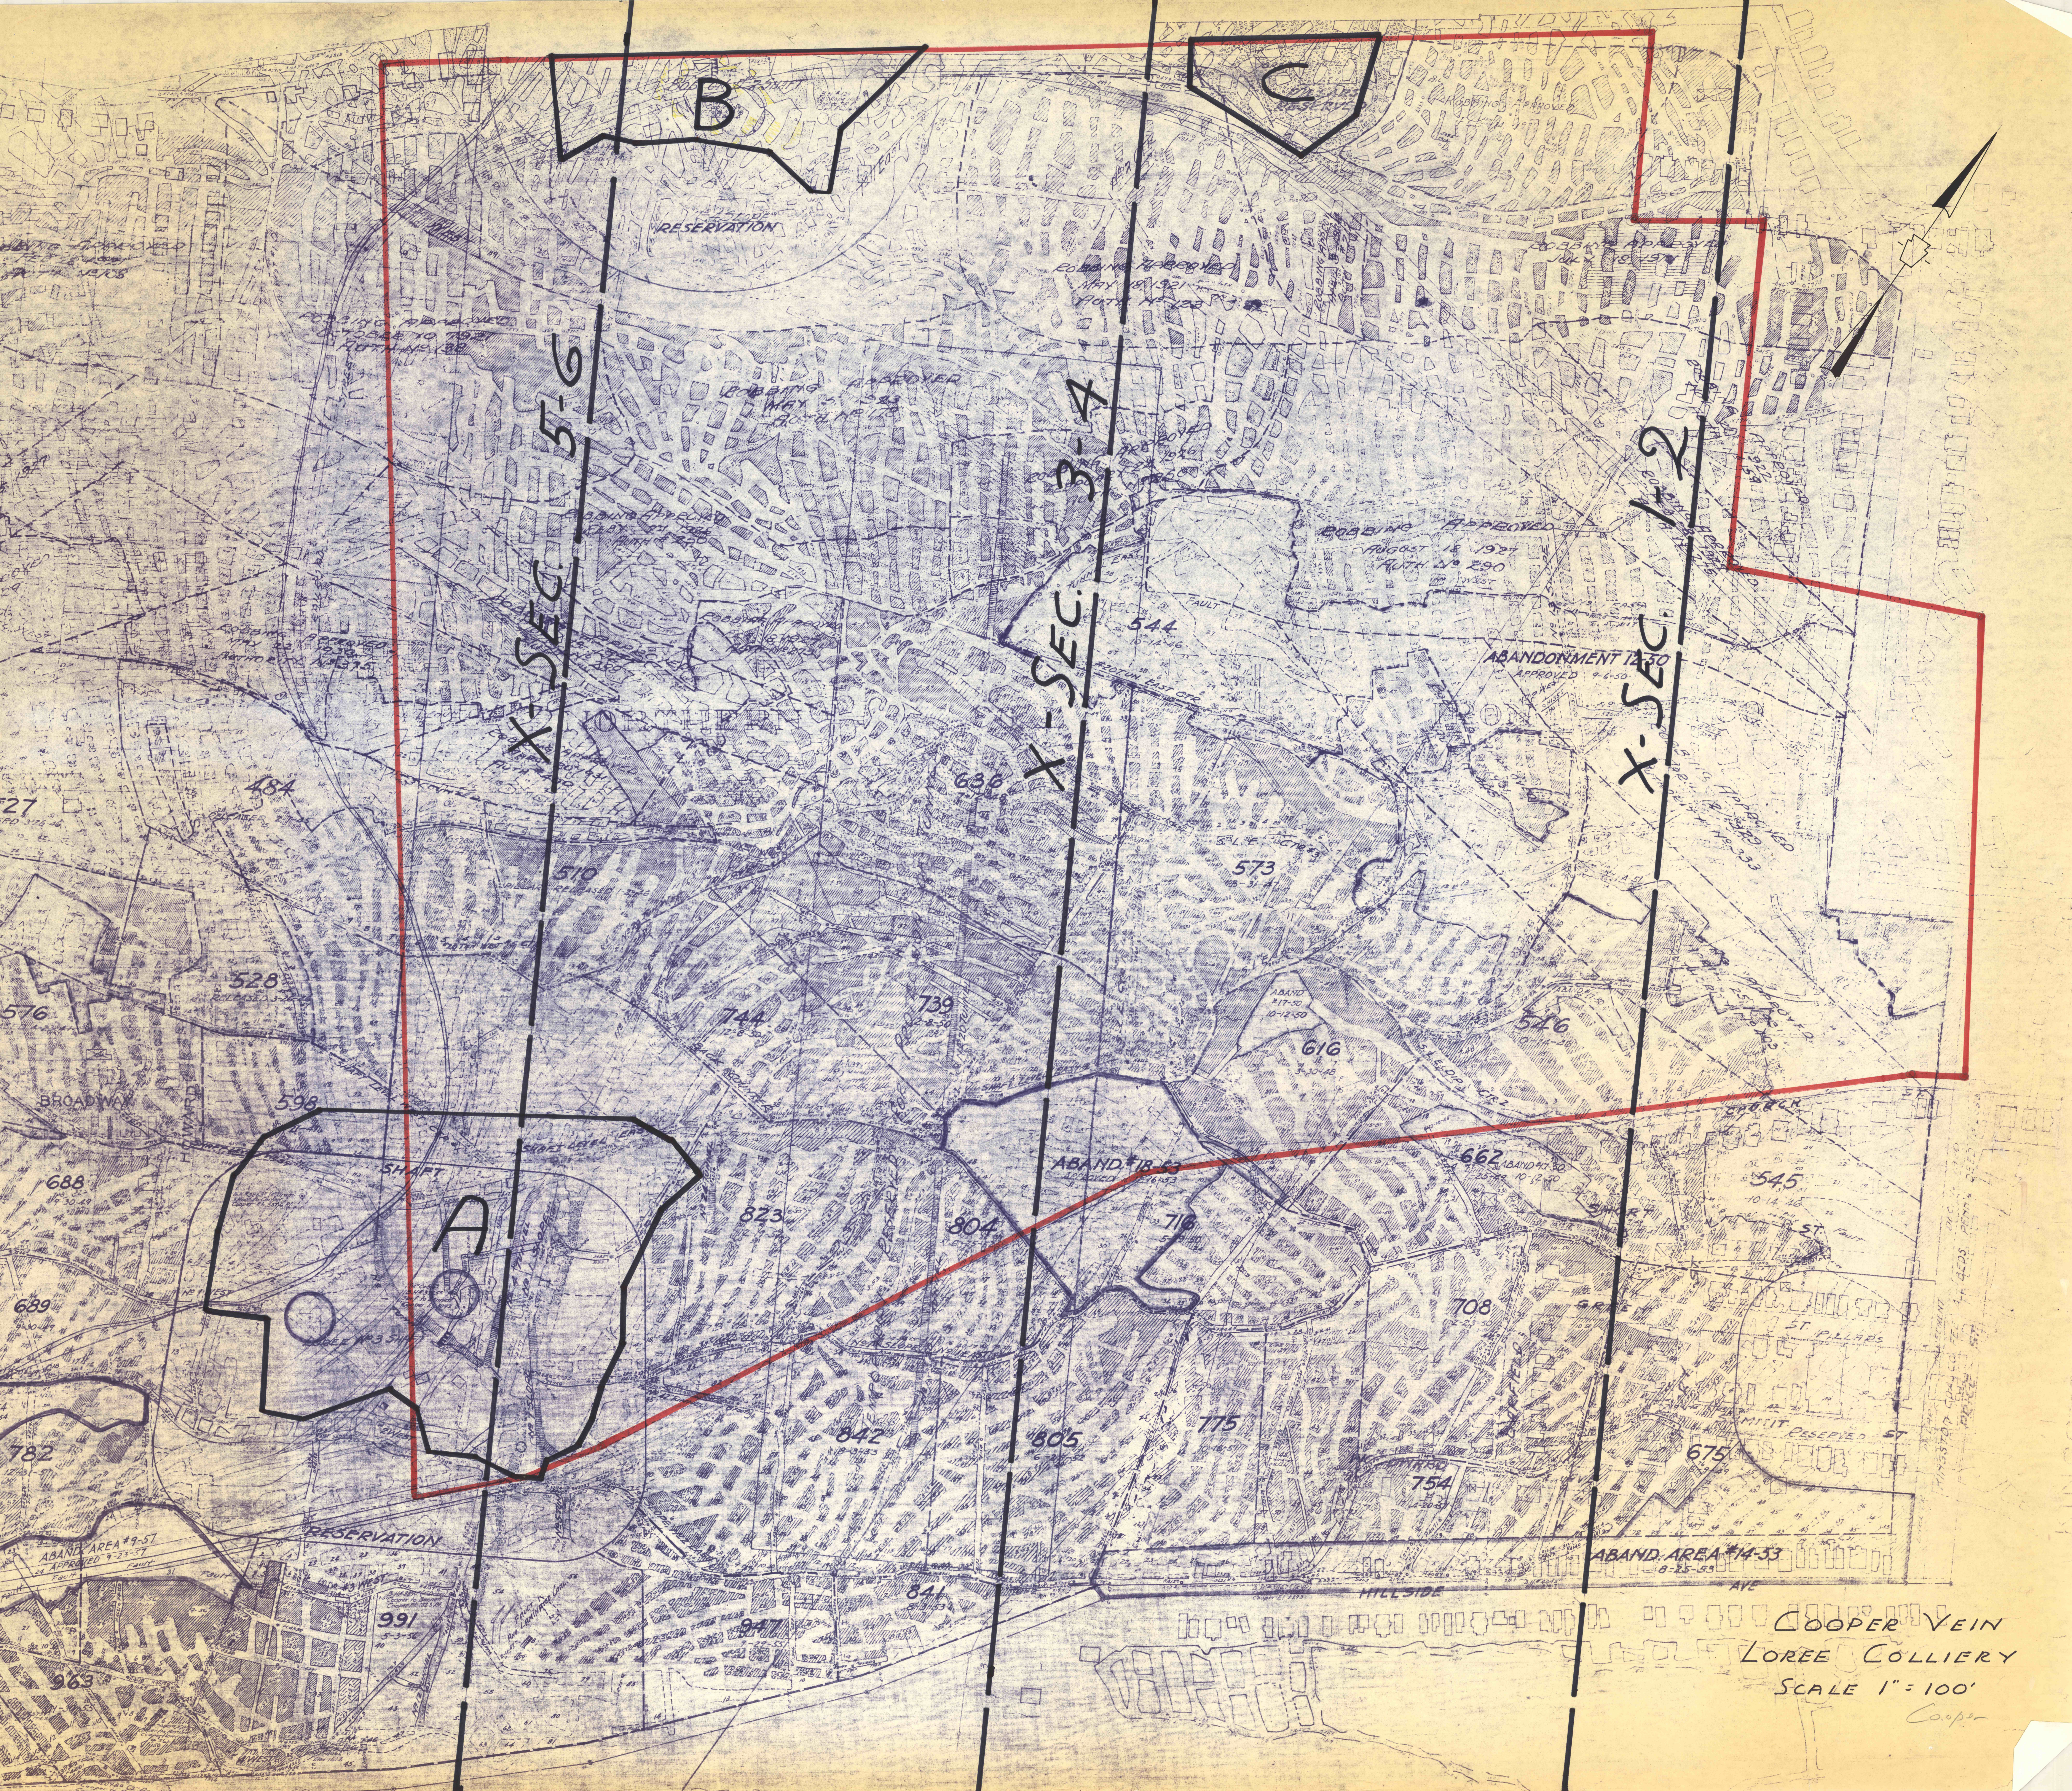
B
C
A
X-SEC. 5-6
X-SEC. 3-4
X-SEC. 1-2
RESERVATION
RESERVATION
ABANDONMENT 12-50
ABAND. #18-53
ABAND. AREA #9-57
ABAND. AREA #14-53
HILLSIDE
AVE
BROADWAY
HOWARD
SHAFT
ST. PILLARS
ROBBING APPROVED AUGUST 15 1927
544
686
573
510
484
528
576
598
688
689
782
744
739
616
546
823
804
716
662
545
842
805
775
754
708
675
841
947
991
963
727

Cooper Vein
Loree Colliery
Scale 1" = 100'

Cooper